

Portland Cement Concrete
Sidewalk - 125 mm
Sta 1+066.250 - 1+100.000 RT


Vertical Granite Curb
Sta 1+066.300 - 1+070.500 RT
Sta 1+072.100 - 1+100.000 RT

Construct Crosswalk Ramp
(2) Sta 1+071.500 RT +/-
(Crosswalk to be Located at Church Walk)


Detectable Warning Surface
Sta 1+168.000 - 1+170.000 RT
Sta 1+172.000 - 1+174.000 RT
Sta 1+095.000 - 1+097.000 RT

ALIGNMENT CURVE DATA

VT 12 Curve #1
Delta = 4° 00' 11.2" RT
Radius = 400.000
Tangent = 13.979
Length = 27.947
External = 0.244

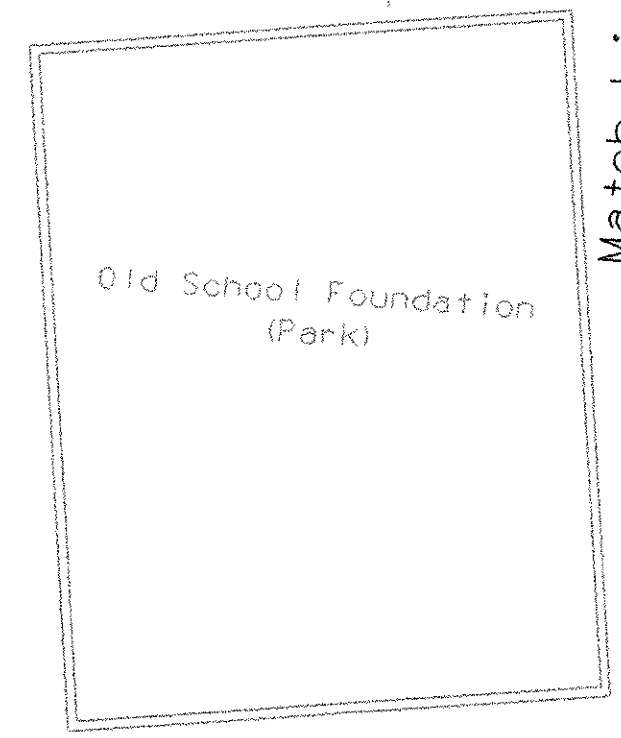

LAYOUT NO. 1

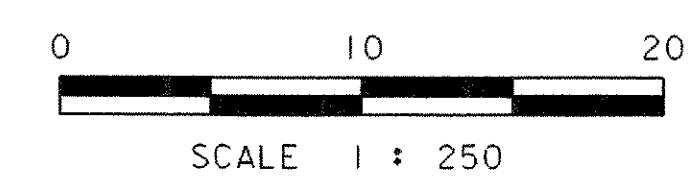

DATUM
VERTICAL NAVD 88
HORIZONTAL NAD 83/92

PROJECT: BETHEL	PROJECT NO. : BRF0241 (33) C/2
DESIGN FILE NAME: 02c180/structures/s02c180bdr.dgn	PLOT DATE: 14-APR-2005
IPARM FILE NAME: sc1801a1.i	SURVEY DATE: 10/99
SURVEYED BY: ORVIS	DRAWN BY: K. HIGGINS
SQUAD LEADER: C. P. WILLIAMS	R.O.W. SHEET 18 OF 19 SHEETS
	R.O.W. SHEET 80 OF 130