

# RIGHT - OF - WAY DETAIL SHEET




TABLE OF PROPERTY ACQUISITION

PARCEL NO.	PROPERTY OWNER	SHEET NO.	BEGINNING STATION	ENDING STATION	TAKE	REMAINDER	RIGHT			RECORDING DATA				REMARKS	
					AREA ±	AREA ±	TYPE	(T/P)	AREA ±	TITLE	DATE	TOWN / CITY	BOOK		PAGE
1A	TOWN OF BETHEL	18.19													ACQUIRED UNDER CONTRACT 1
2A	PRATT, FRANK E. & PLACY, DIANE L.	19	1+105.00 RT.												DRIVE 5.7M(18') GRAVEL ROW OVER PARCEL #1A
3A	C.V. PROPERTIES, INC. JOINED BY: NEW ENGLAND CENTRAL RAILROAD, INC.	19	1+159.02 RT. 1+159.02 RT.	1+195.52 RT. 1+175.19 RT.	.068 HA		CONST	T	4.38 SM						0.17A± HWY EASE. INCLUDES EROSION CONTROL & PDF 46 S.F.±
3B			1+174.47 LT. 1+175.17 LT. 1+178.80 LT.	1+195.89 LT. 1+192.06 LT.	.013 HA		INSTALL CONST.	T T	83 SM						0.03A± HWY EASE. EROSION CONTROL INCLUDES EROSION CONTROL & PDF, 893 S.F.±
4A	BETHEL MILLS, NC.	19	1+270.00 RT. 1+270.60 RT. 1+227.360 RT. 1+228.0 RT. 1+223.80 RT. 1+223.80 RT.	1+325.27 RT. 1+287.00 RT. 1+247.38 RT. 1+241.47 RT. 1+234.68 RT. 1+325.27 RT.			DRIVE  INSTALL & MAINTAIN  CUL. & DR. CHANNEL REMOVE	T  P P T	  14.2 SM  20.6 SM .057 HA						PAVED 3.7M(12') "DO NOT DISTURB" VAULT, UNDERGROUND POWER RETAINING WALL & FOOTING. 153 S.F.± CONNECT TO EXISTING WALL.  222 S.F.± TEMP. BRIDGE, DRIVE & APPURTENANCES, 0.14A±
			1+271.38 RT. DRIVE STATION 3+023.33 LT	1+283.31 RT. DRIVE STATION 3+046.94 LT.			INSTALL INSTALL	T T							GUARDRAIL  EROSION CONTROL & PDF

TABLE OF REVISIONS

REVISION NO.	SHEET NO.	DESCRIPTION	DATE
1	17	PARCEL NO. & PUNGER. CHANGE BEGINNING STA. OF CHANNEL (P) FROM STA. 1+226.35 LT. TO 1+231.35 LT. PER C.O. 9388. DRAWN BY: MR APPROVED BY: RPD	10/19/2004
		IPARMS AND SPREADSHEETS TO STRUCTURES	2/14/2005

PLAN LEGEND

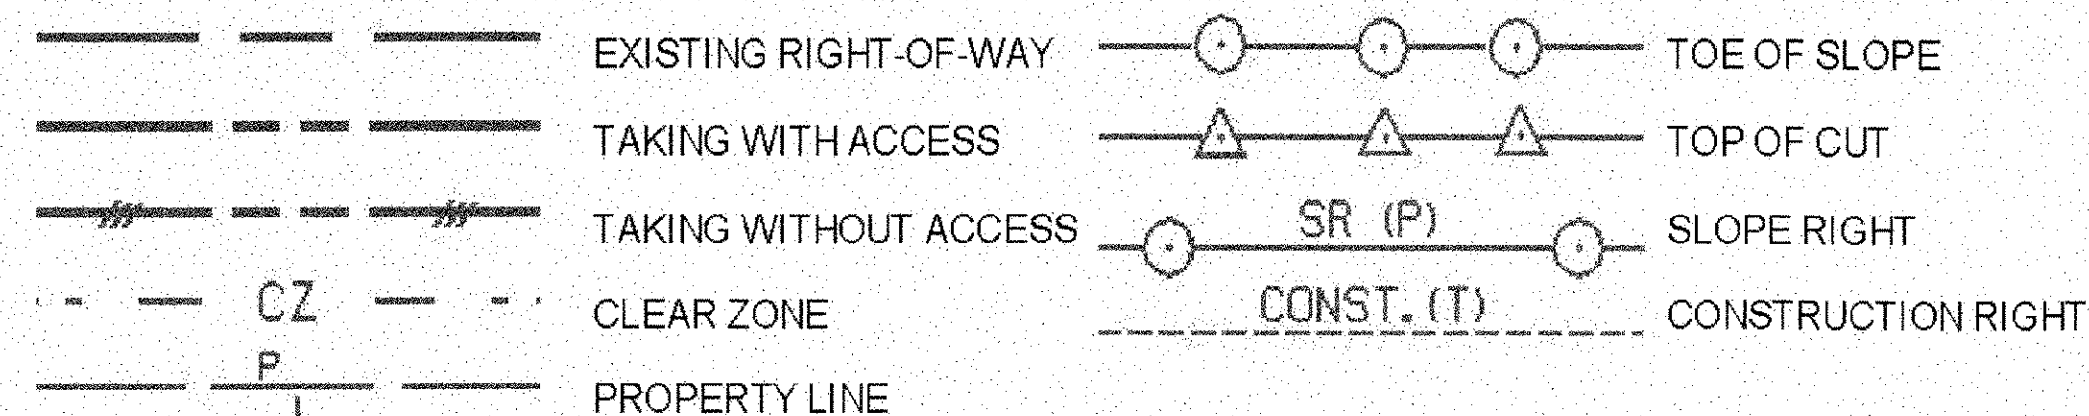

- (P) -PERMANENT
- (T) -TEMPORARY
- DR. -DRAINAGE RIGHT
- DIT. -DITCHING RIGHT
- CH. -CHANNEL RIGHT
- DRIVE -DRIVE RIGHT
- CUL. -CULVERT RIGHT
- C&T -CLEARING & TRIMMING RIGHT
- SR -SLOPE RIGHT
- UE -UTILITY EASEMENT

APPROVED: ROGER P. DUMAS DATE: 06-16-04  
CHIEF, PLANS & TITLES

2/16/2005

PROJECT NAME: **BETHEL**  
 PROJECT NUMBER: **BRF 0241(33) C/2**  
 FILE NAME: r02c180det.xls PLOT DATE:  
 PROJECT LEADER: C.P. WILLIAMS DRAWN BY: G. FUNK  
 DESIGNED BY: K. HIGGINS CHECKED BY: F. MALNATI  
 R.O.W. SHEET 16 OF 19 SHEET 82 OF 130