


END COLD PLANING  
STA 1+075.000

COMMON EXC. START @ 1+075.00  
COMMON EXC. = 3.70 sm'

*Rev 4-9-07 JHP 6/07/07*

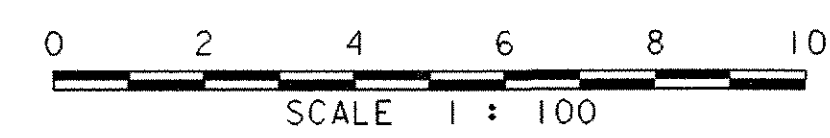

|   |                                   |
|---|-----------------------------------|
| PROJECT:<br>BETHEL                                  | PROJECT NO. :<br>BRF0241 (33) C/2 |
| DESIGN FILE NAME: 02c180/Structures/s02c180xsec.dgn | IPARM FILE NAME: sc180m12.i       |
| MAINLINE CROSS SECTIONS                             |                                   |
| STA 1+080 Thru STA 1+105                            | SHEET: 85 OF 130                  |