




I+120
END APPROACH
BEGIN PROJECT
STA I+120.000

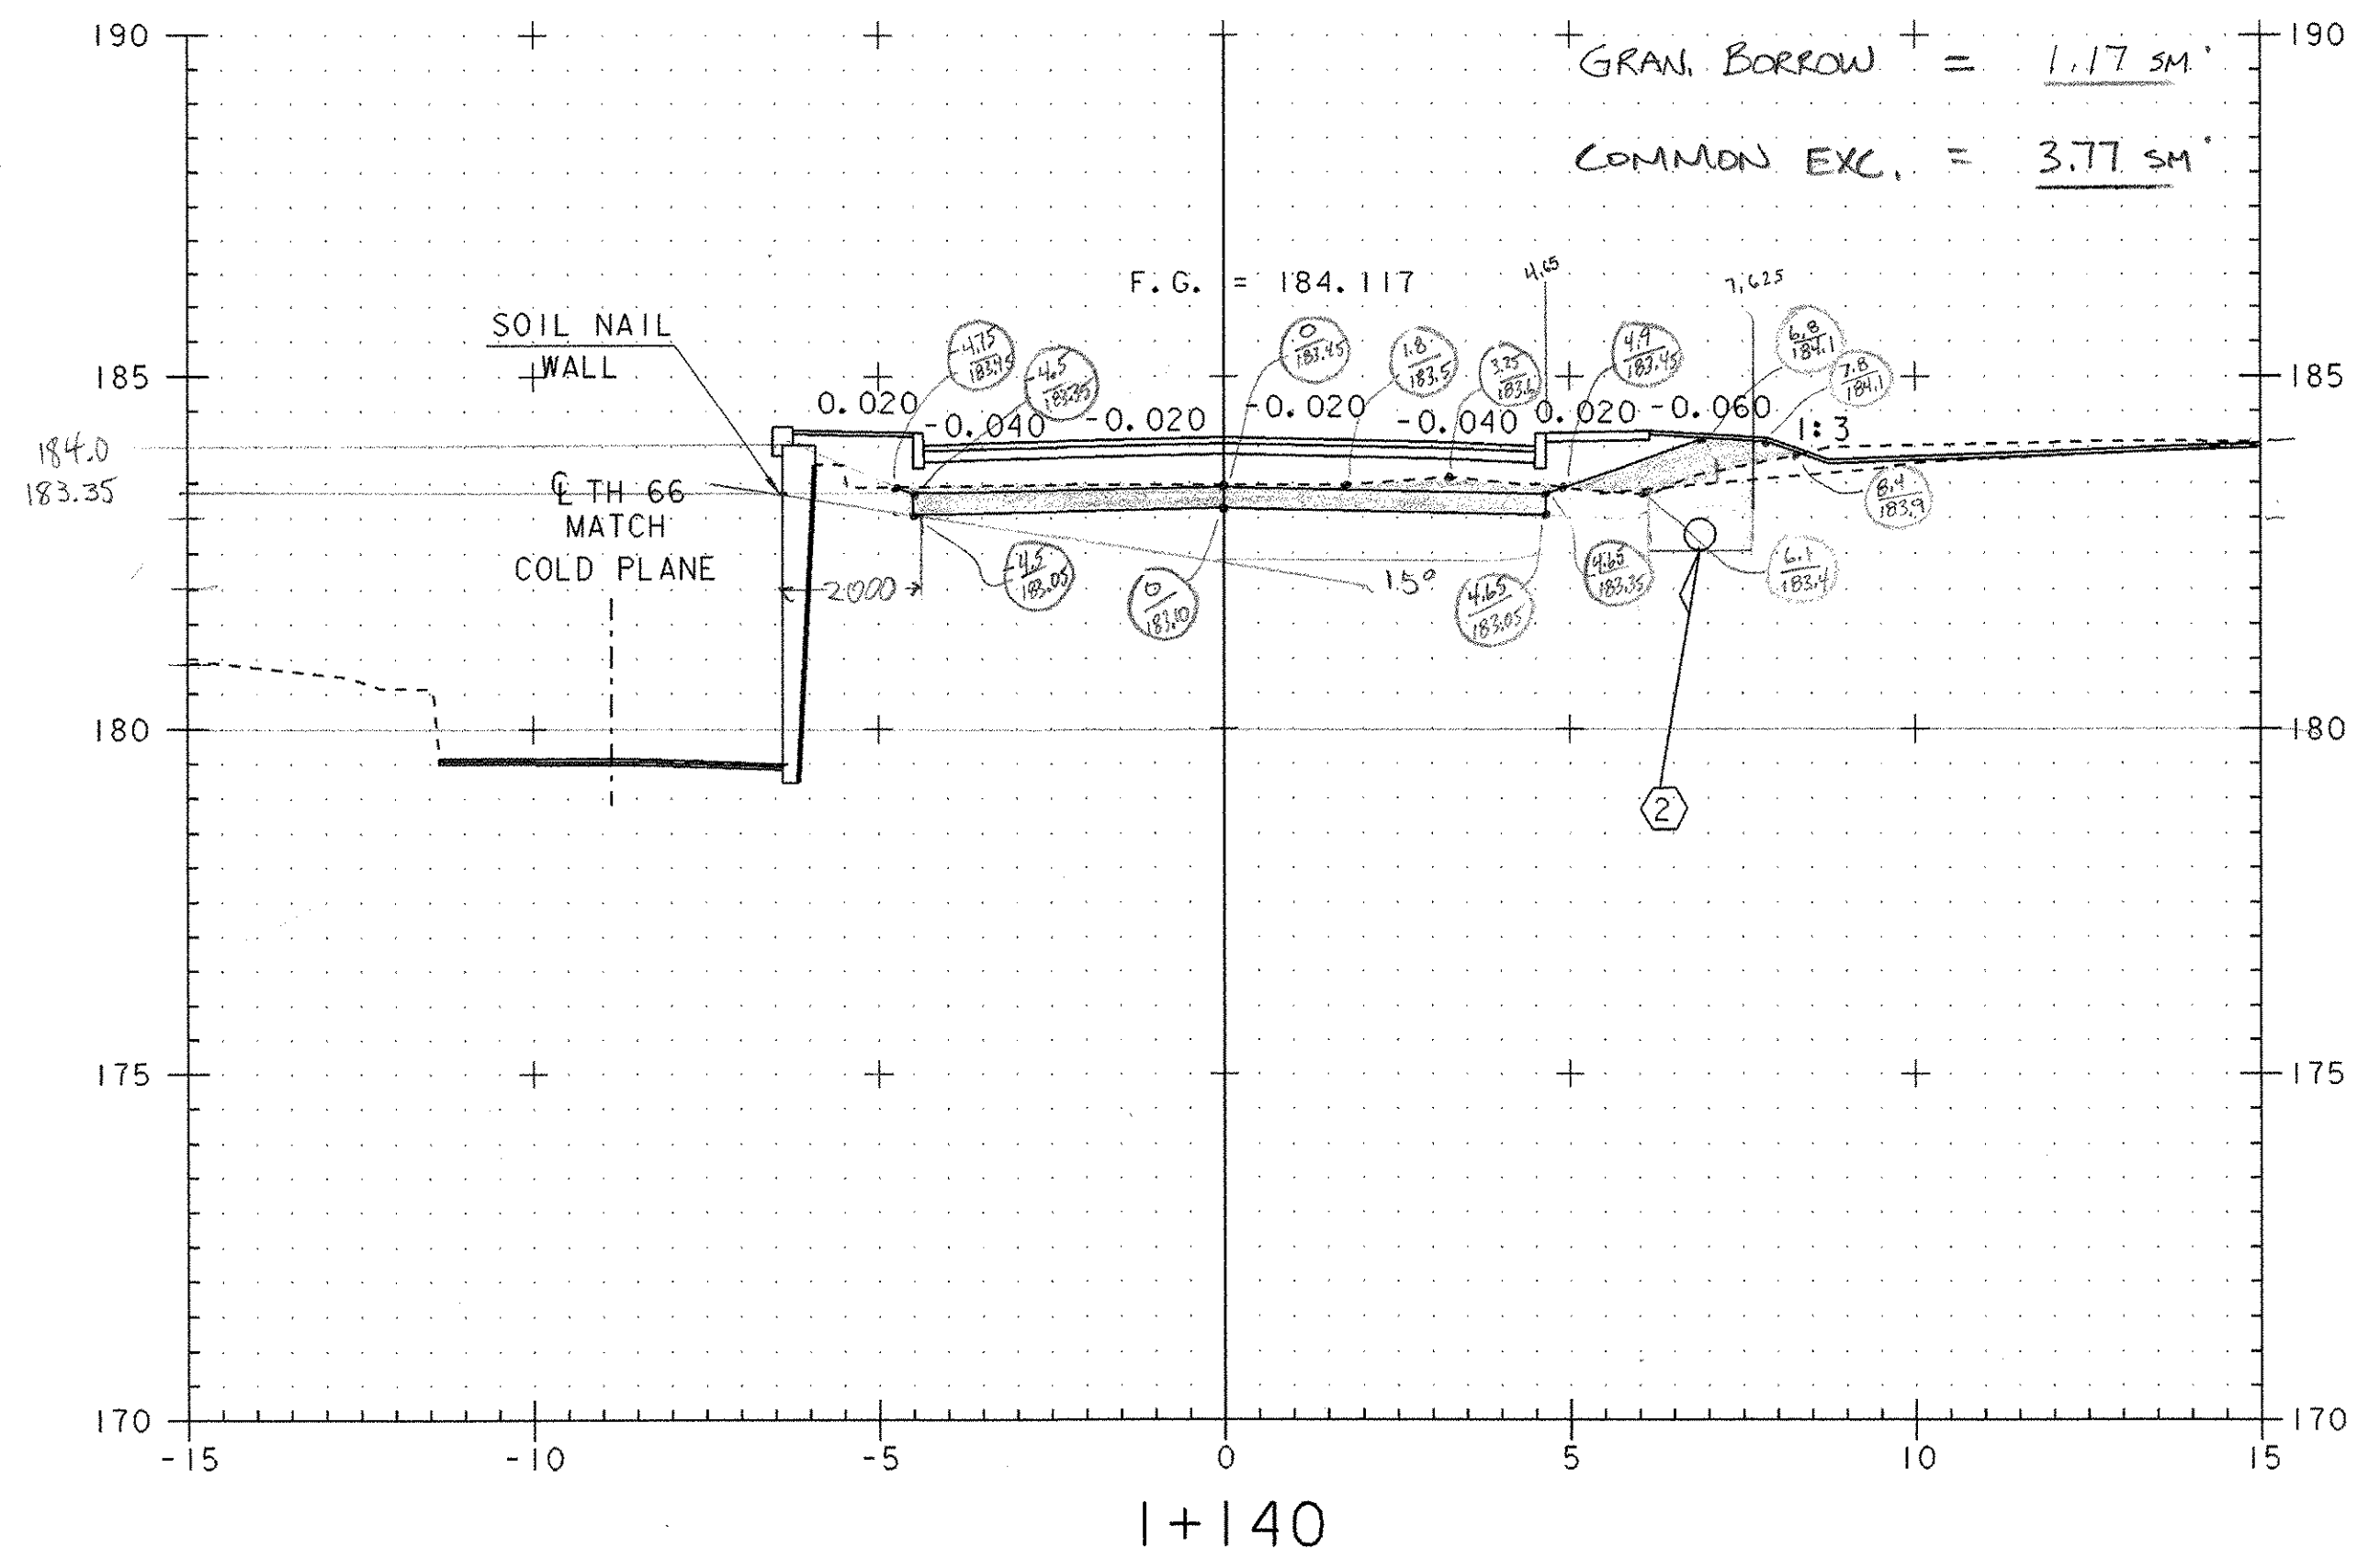

I+140

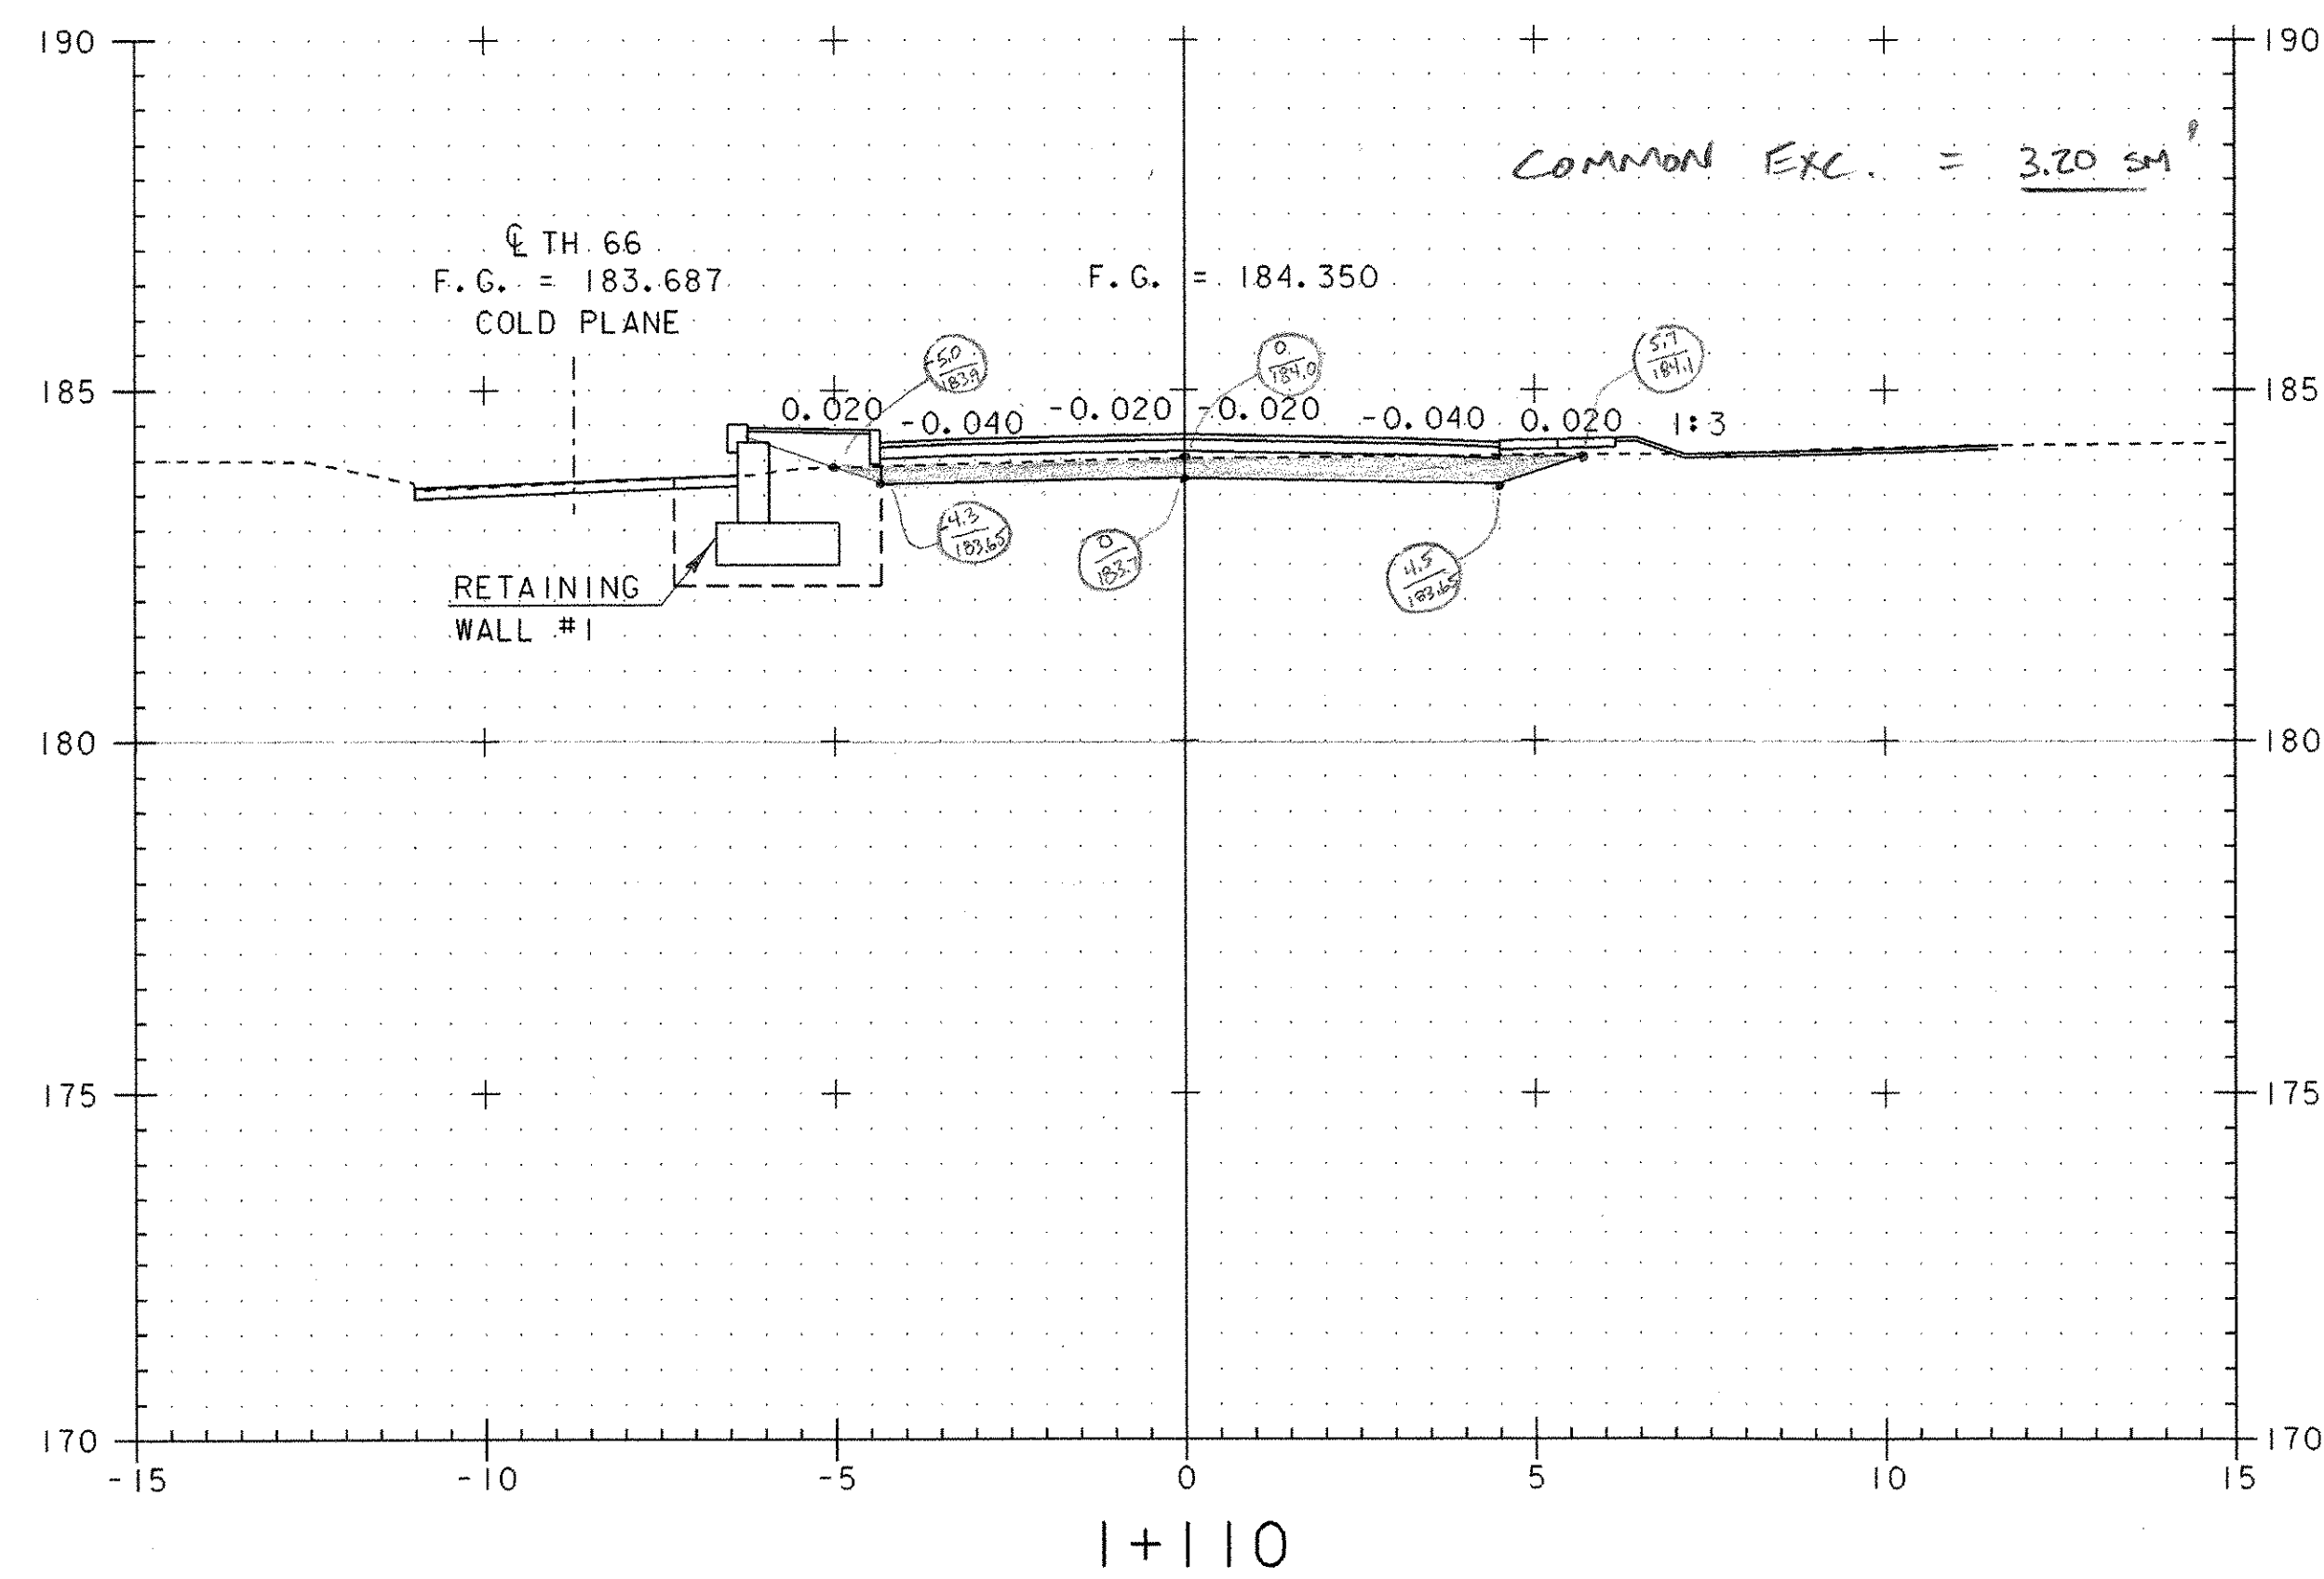


I+110

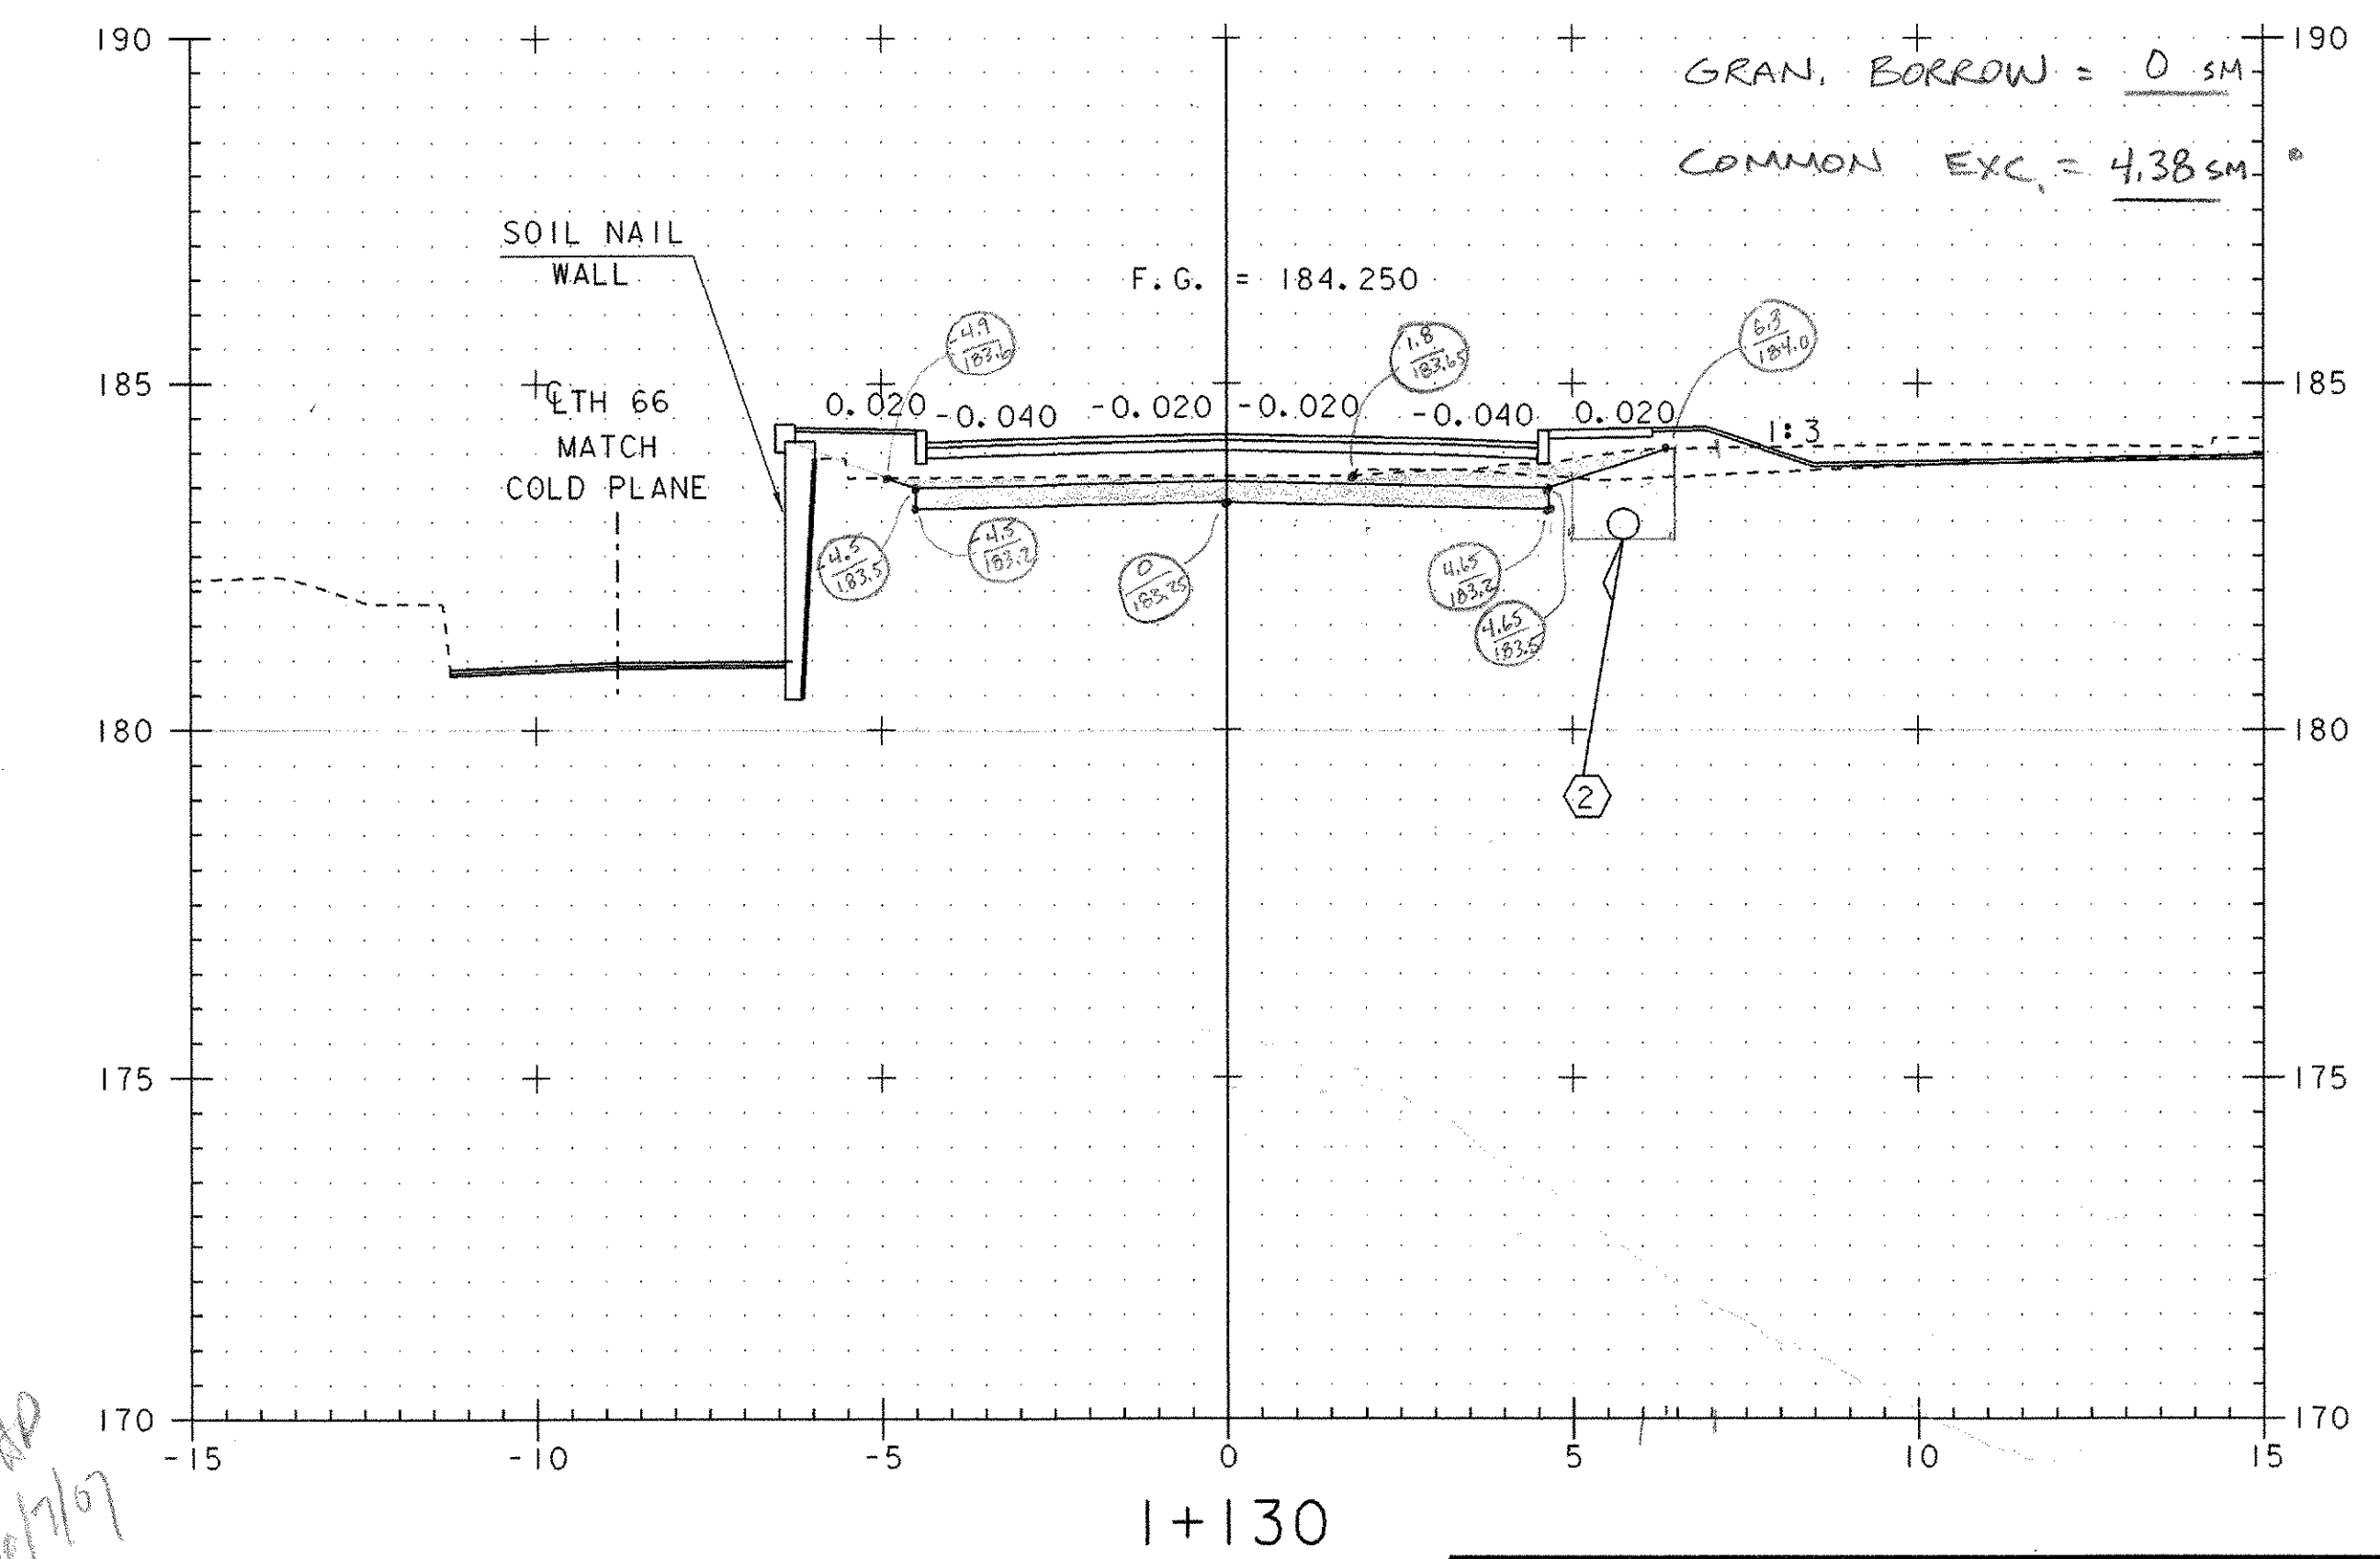

I+130

Ref 4-9-07 JMD 6/7/07

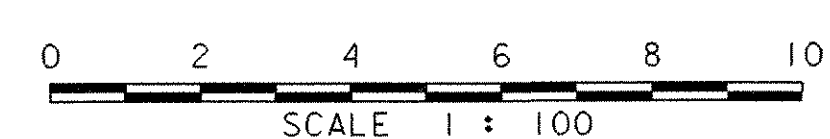

PROJECT: BETHEL	PROJECT NO. : BRF0241 (33) C/2
DESIGN FILE NAME: 02c180/Structures/s02c180xsec.dgn	PLOT DATE: 14-APR-2005
IPARM FILE NAME: sc180m13.1	
MAINLINE CROSS SECTIONS	
STA I+110 Thru STA I+140	SHEET: 86 OF 130