

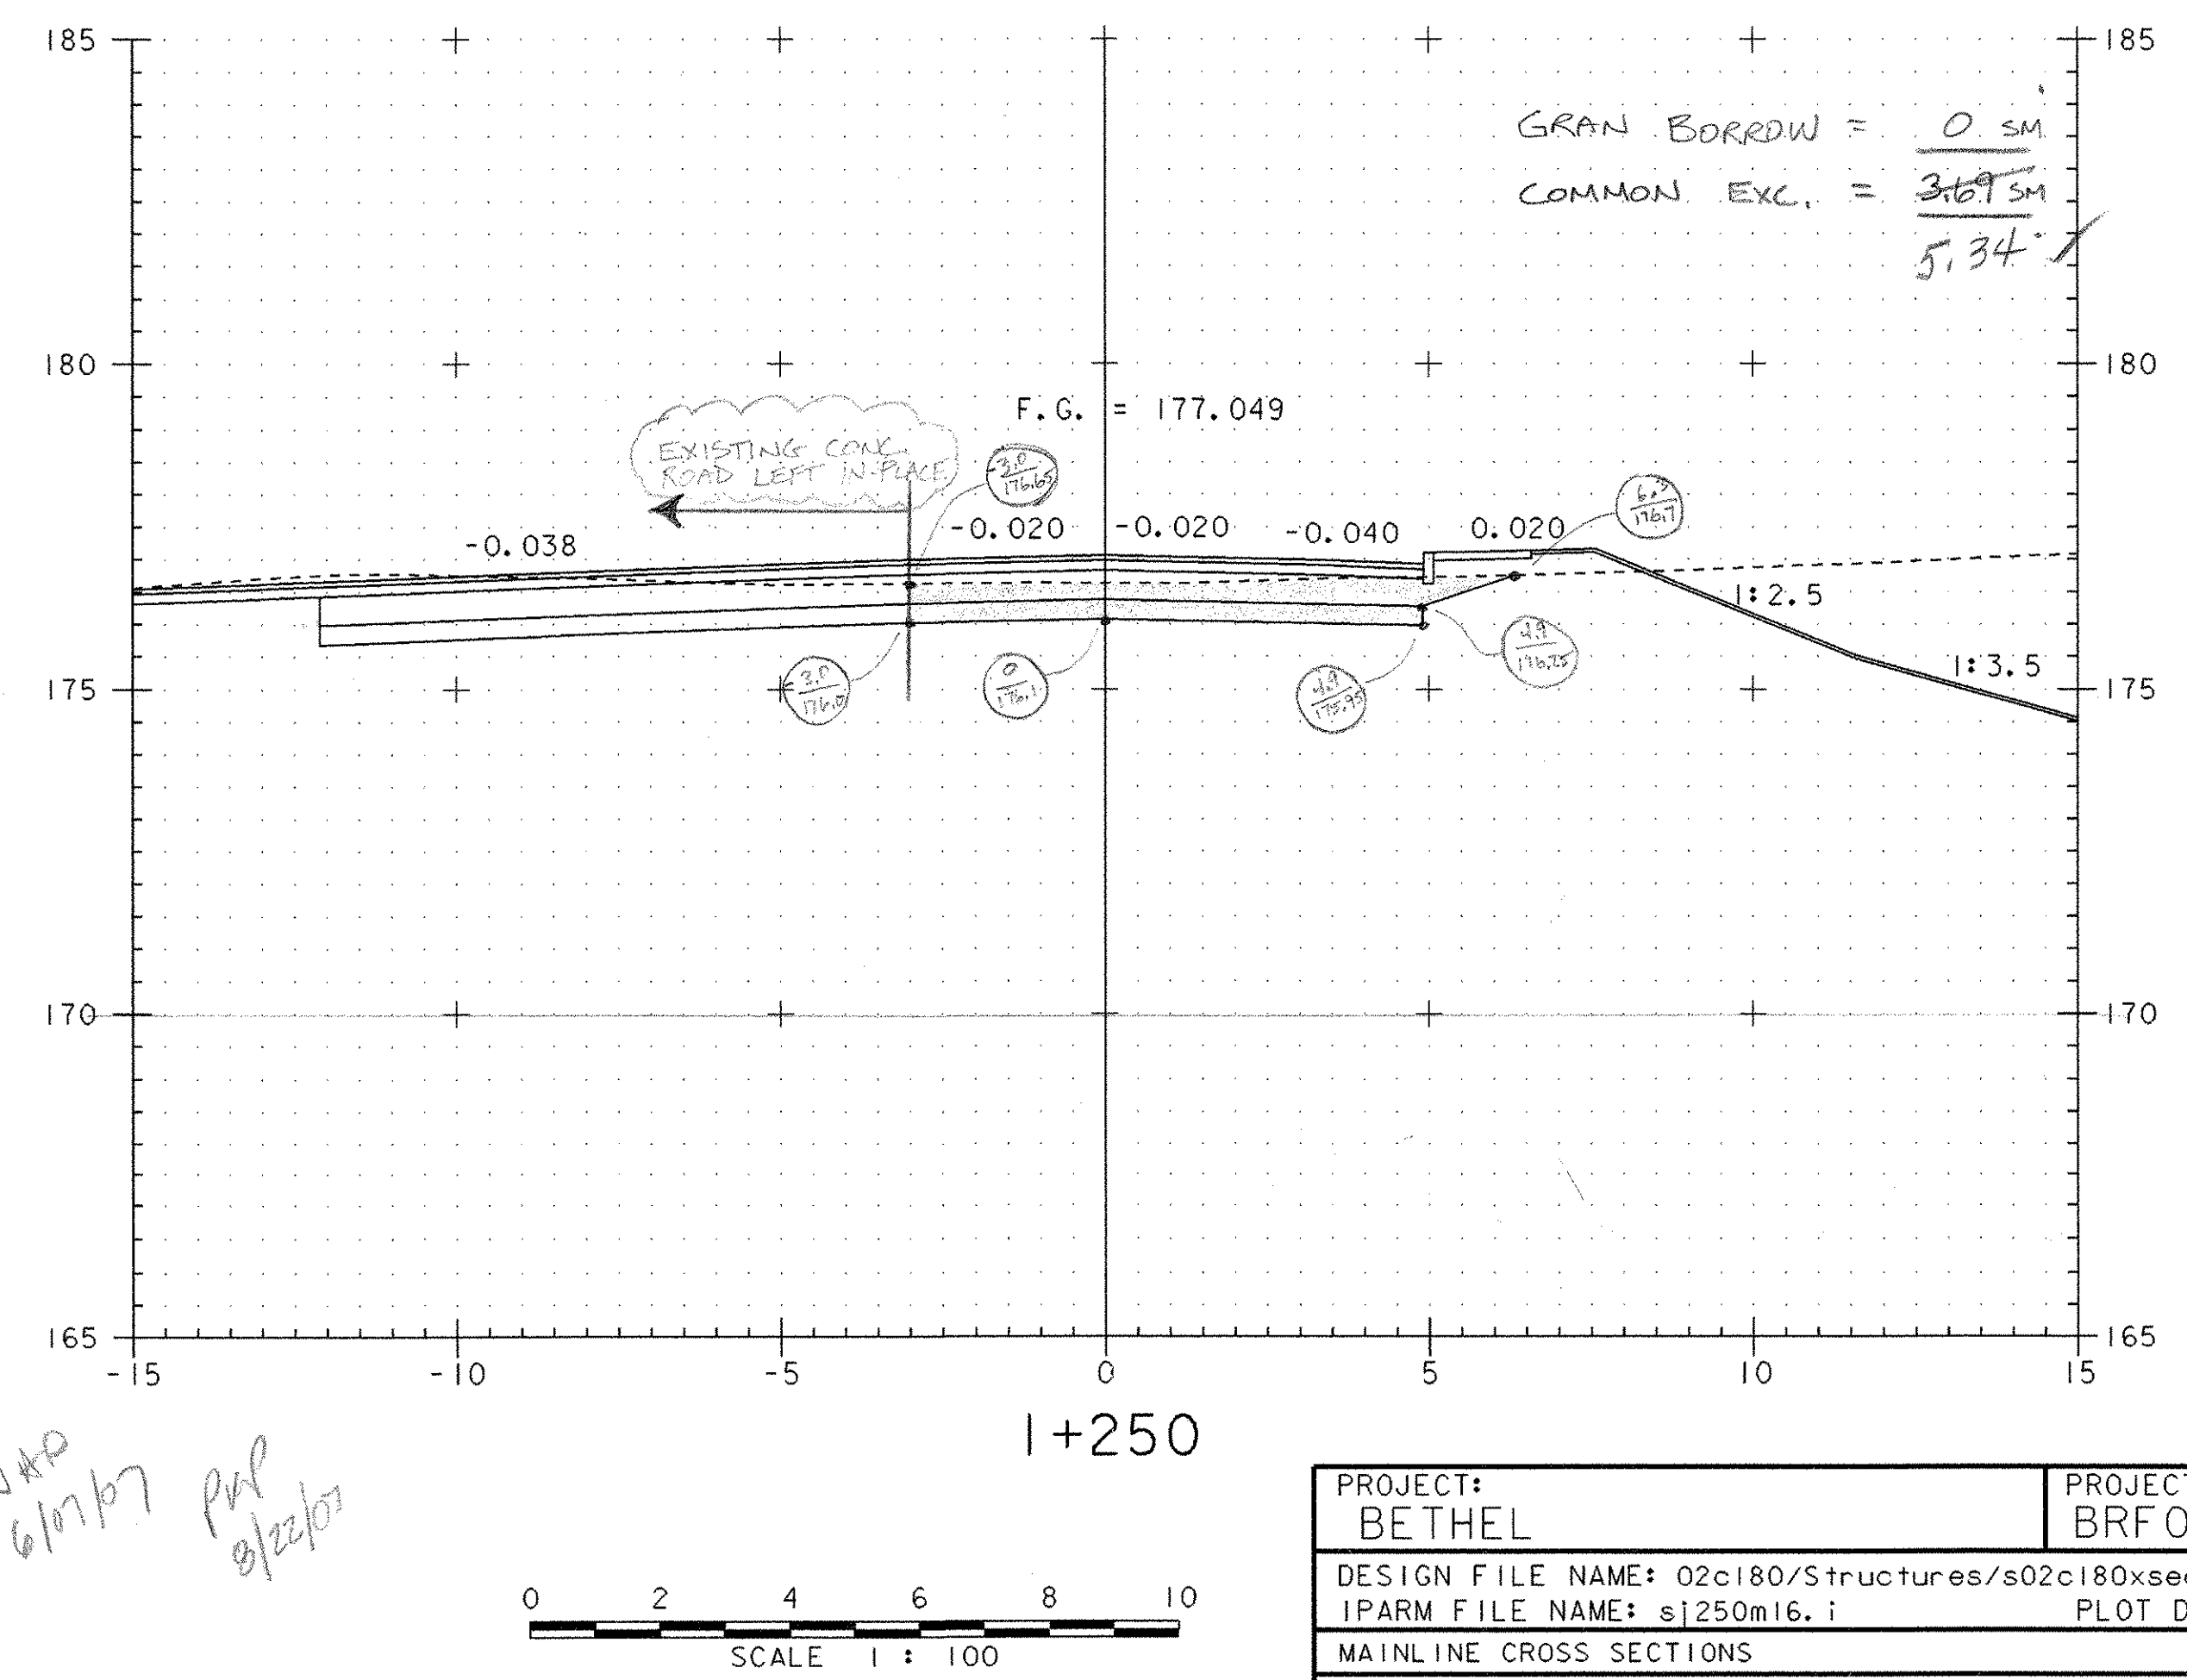
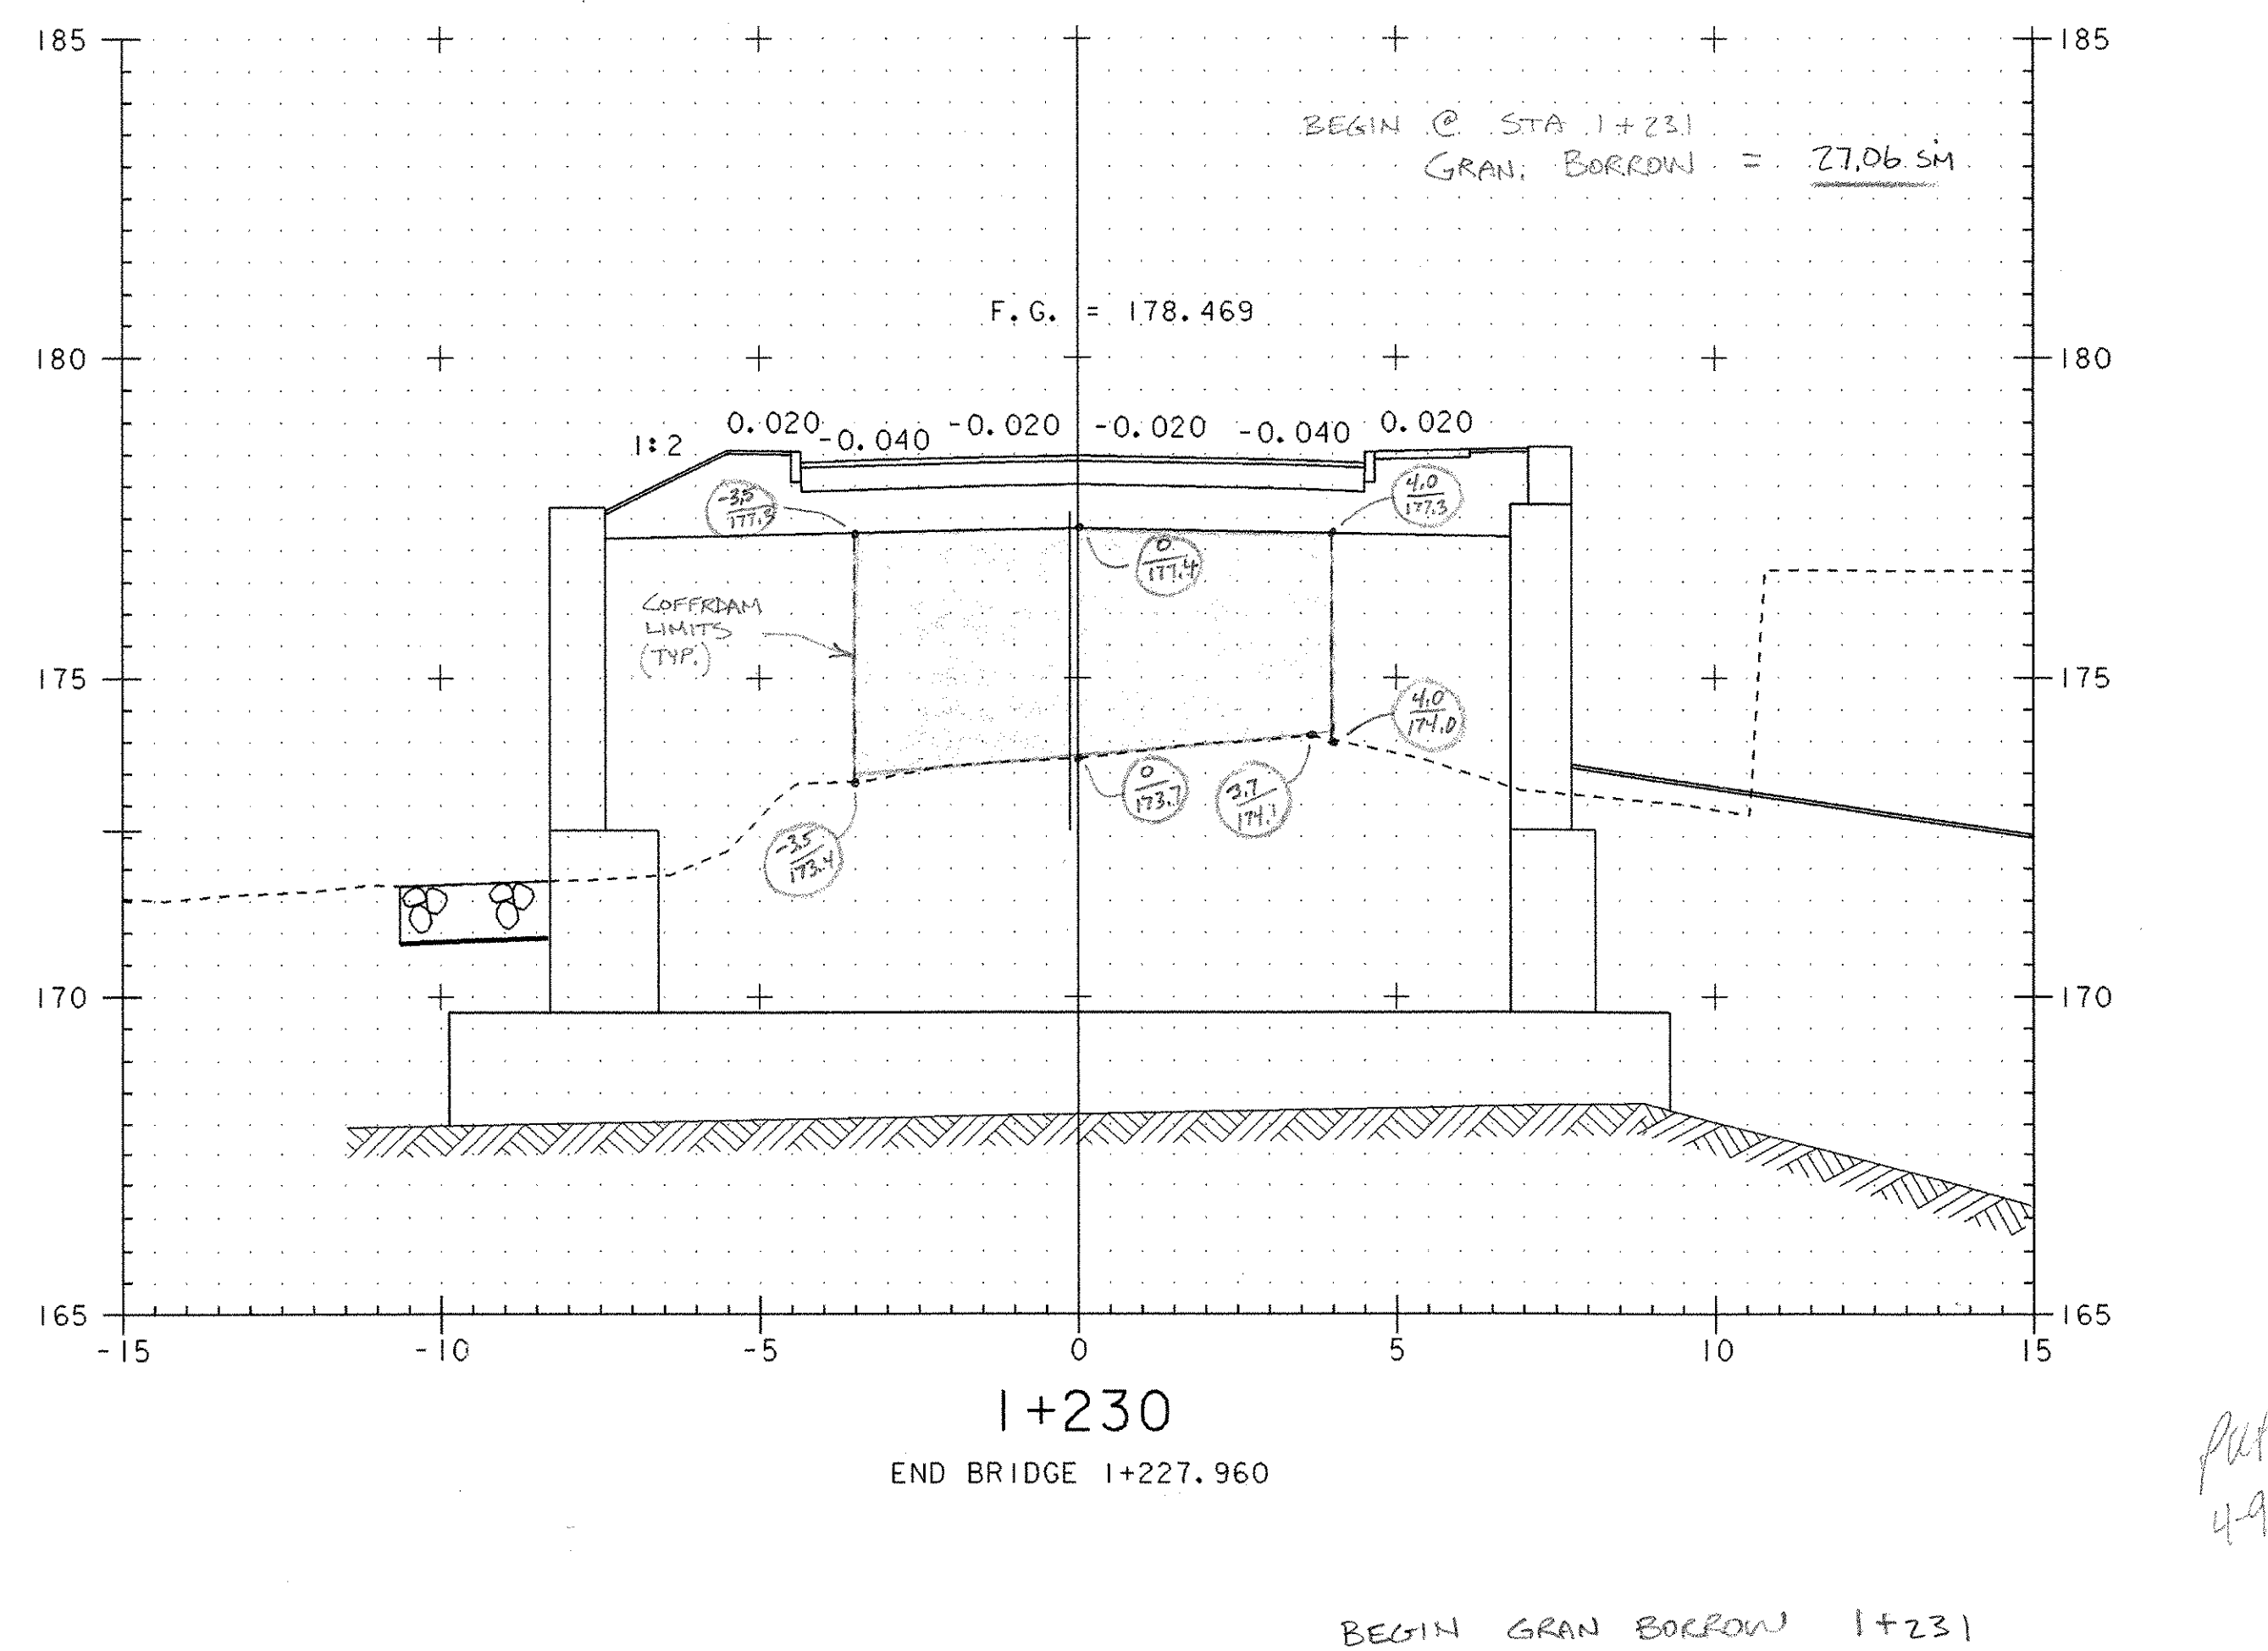


SCALED FROM PLAN, COMMON EXC. @ 1+241 IS FROM G OF M TO 20 m LT. USE SAME AVE DEPTH OF COMMON @ 1+240.

$(20m)(0.7m) =$ COMMON EXC. = 14.00 SM

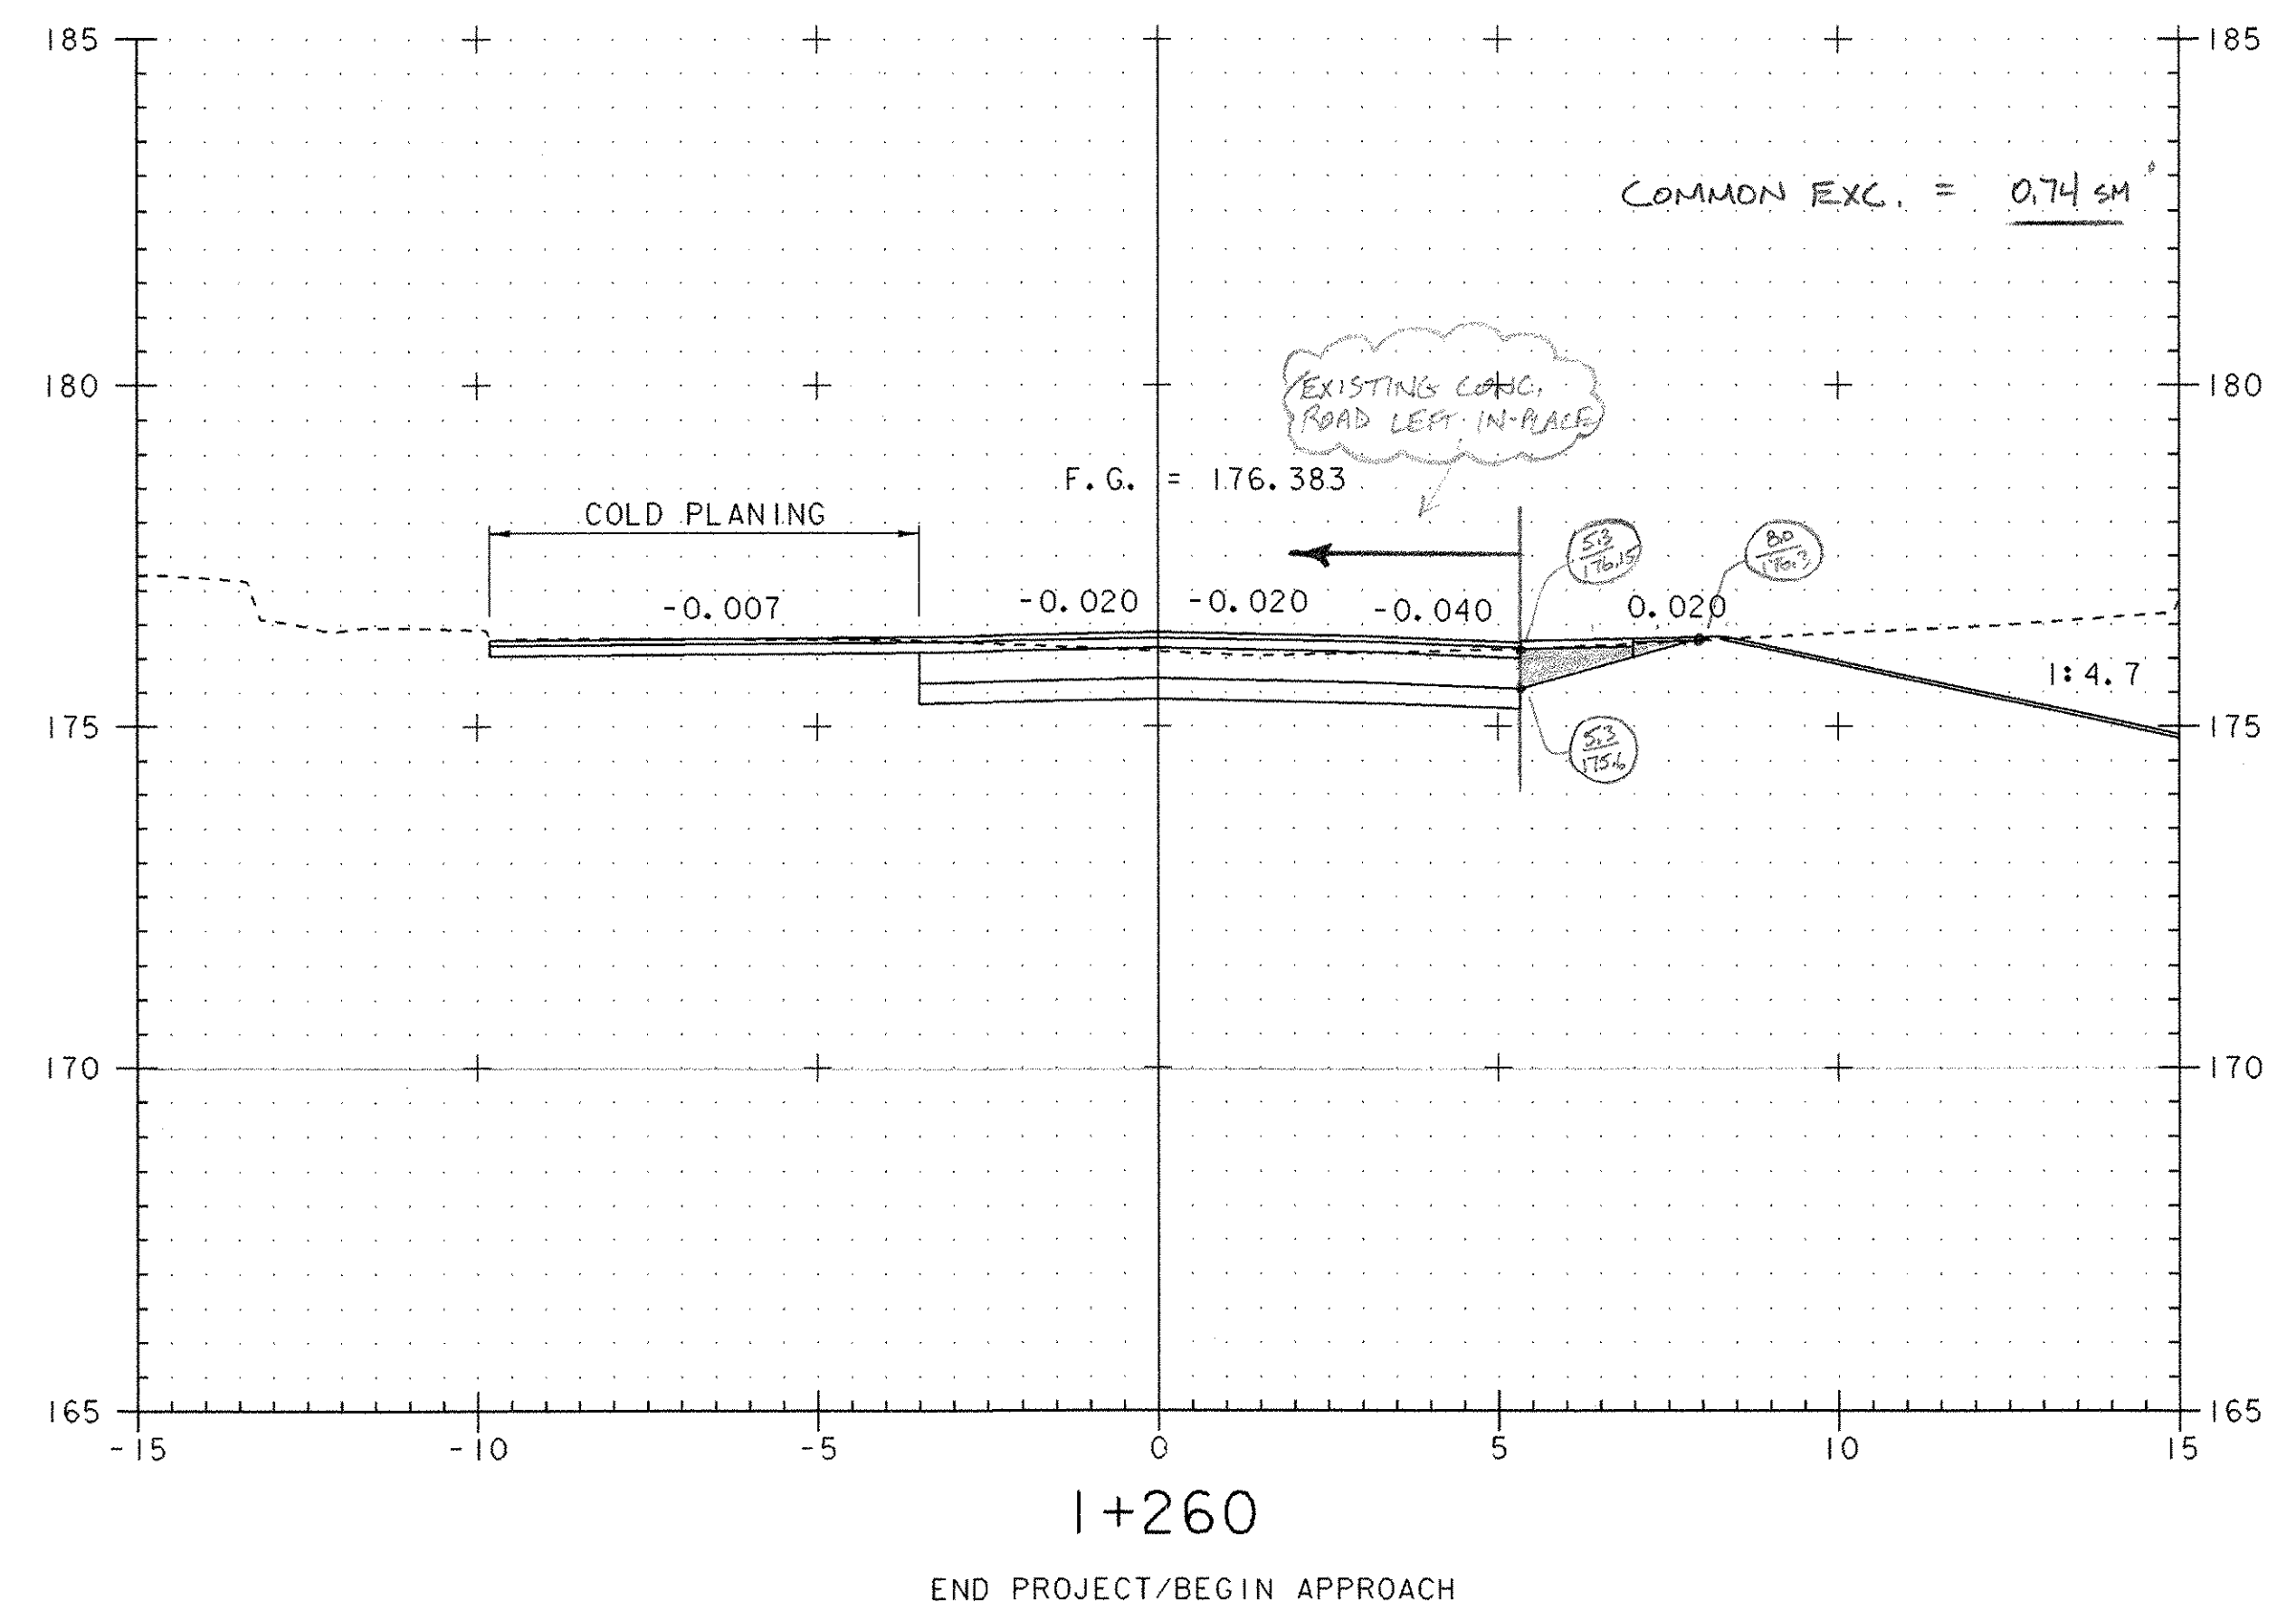

Handwritten notes:
PWP 4-9-07
JAP 6/17/07
PWP 8/22/07

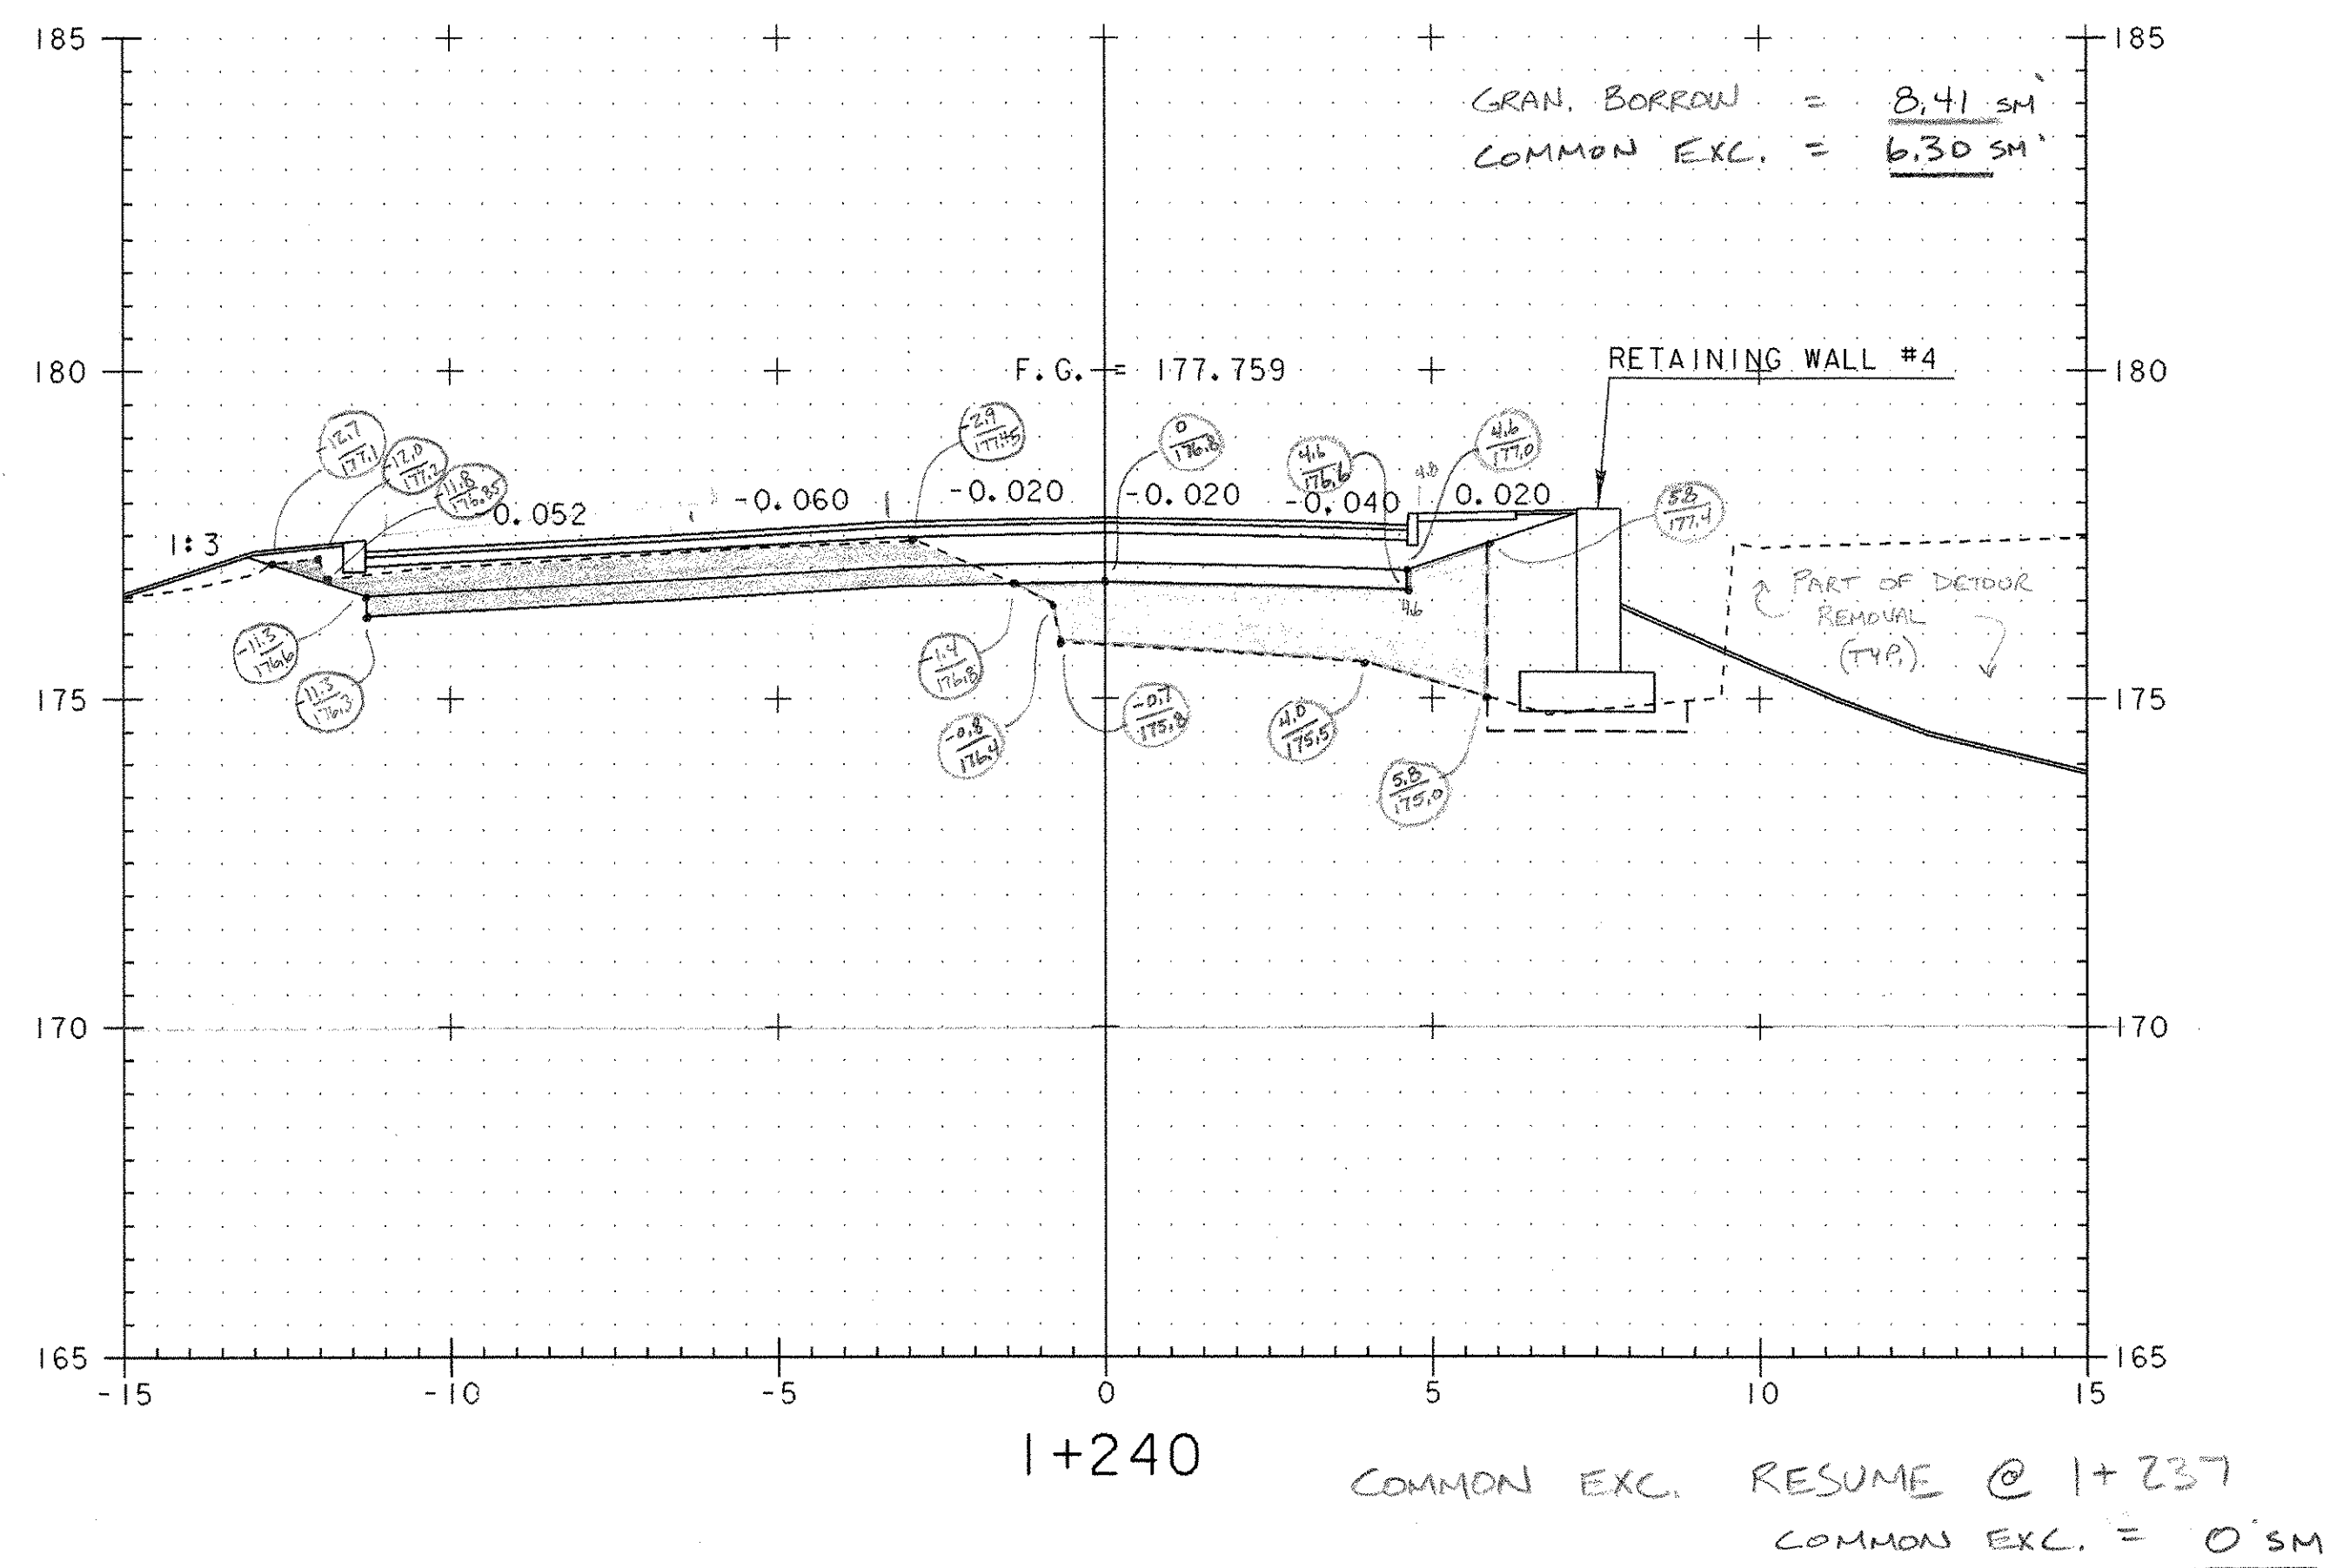

PROJECT: BETHEL	PROJECT NO. : BRF0241 (33) C/2
DESIGN FILE NAME: 02c180/Structures/s02c180xsec.dgn	PLOT DATE: 14-APR-2005
IPARM FILE NAME: s1250m16.i	
MAINLINE CROSS SECTIONS	
STA 1+230 Thru STA 1+260	SHEET: 89 OF 130