


RETAINING WALL #5
STA 2+040.500 (AFTER STEPS)
STA 2+049.500 (TO DRIVEWAY)

END APPROACH
END COLD PLANING
TH5 STA 2+050.000




BEGIN APPROACH
BEGIN COLD PLANING
TH5 STA 2+035.000

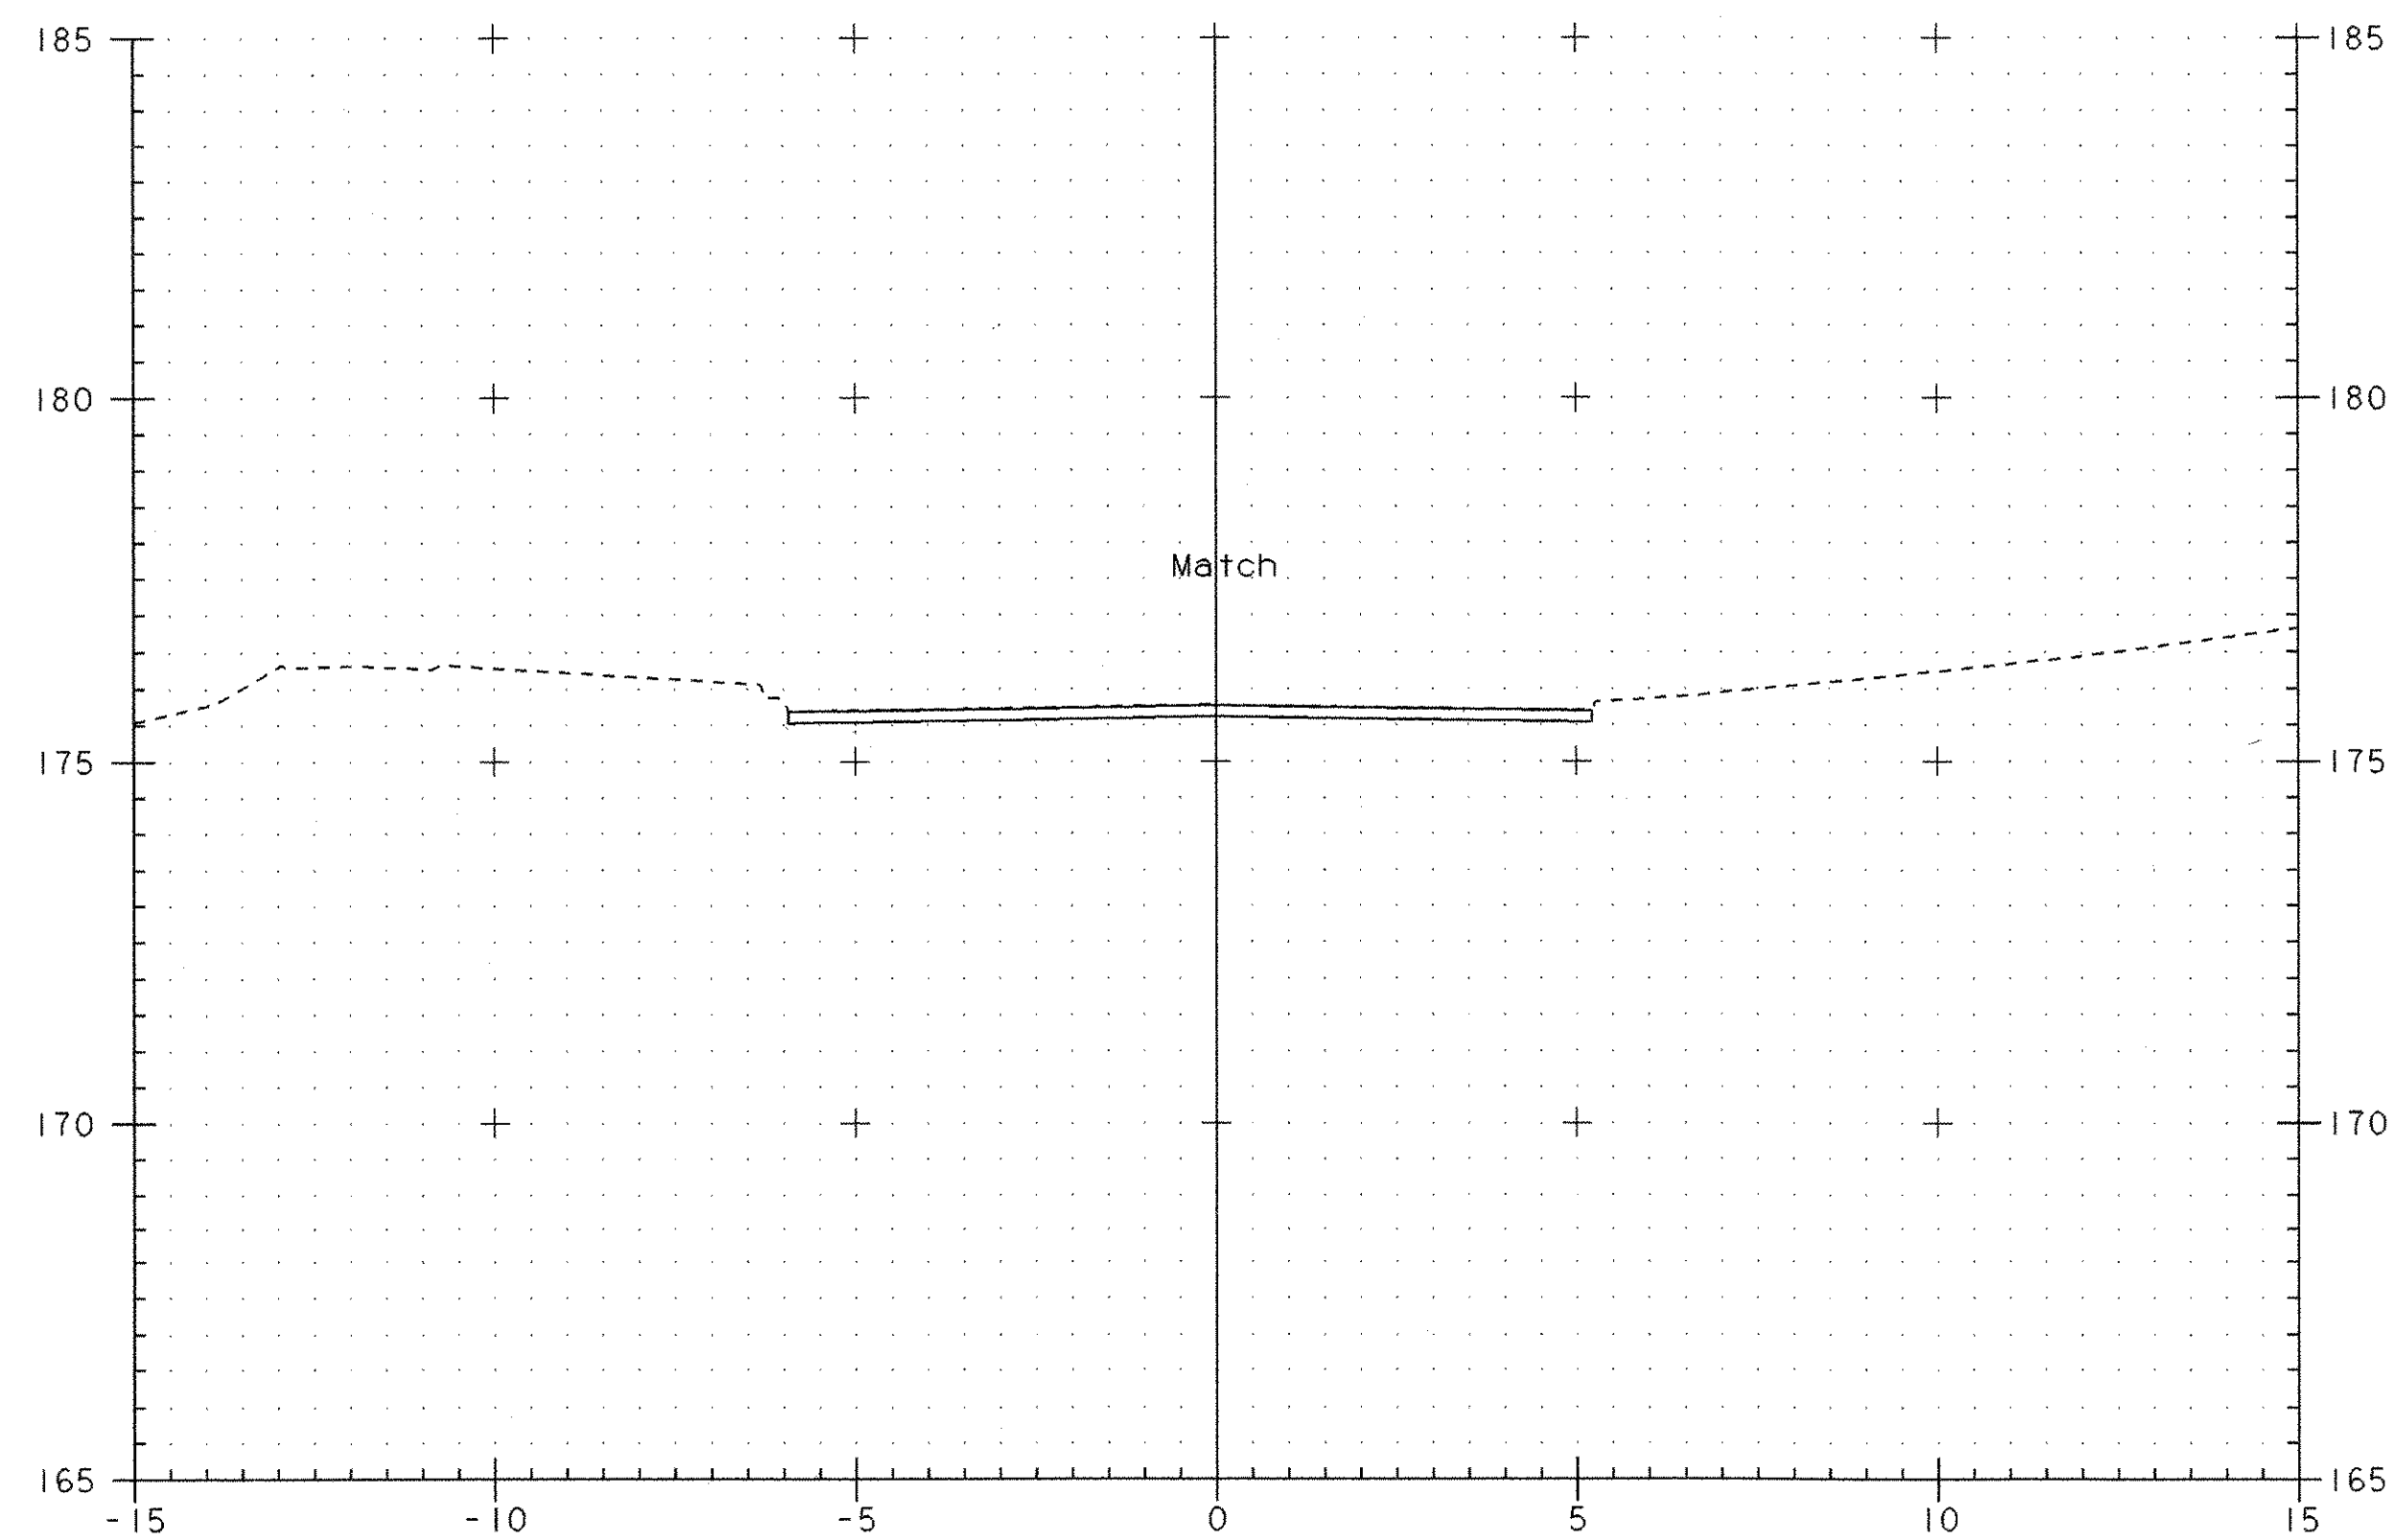

SUBBASE TAPER AT END PROJECT - TH5

NTS

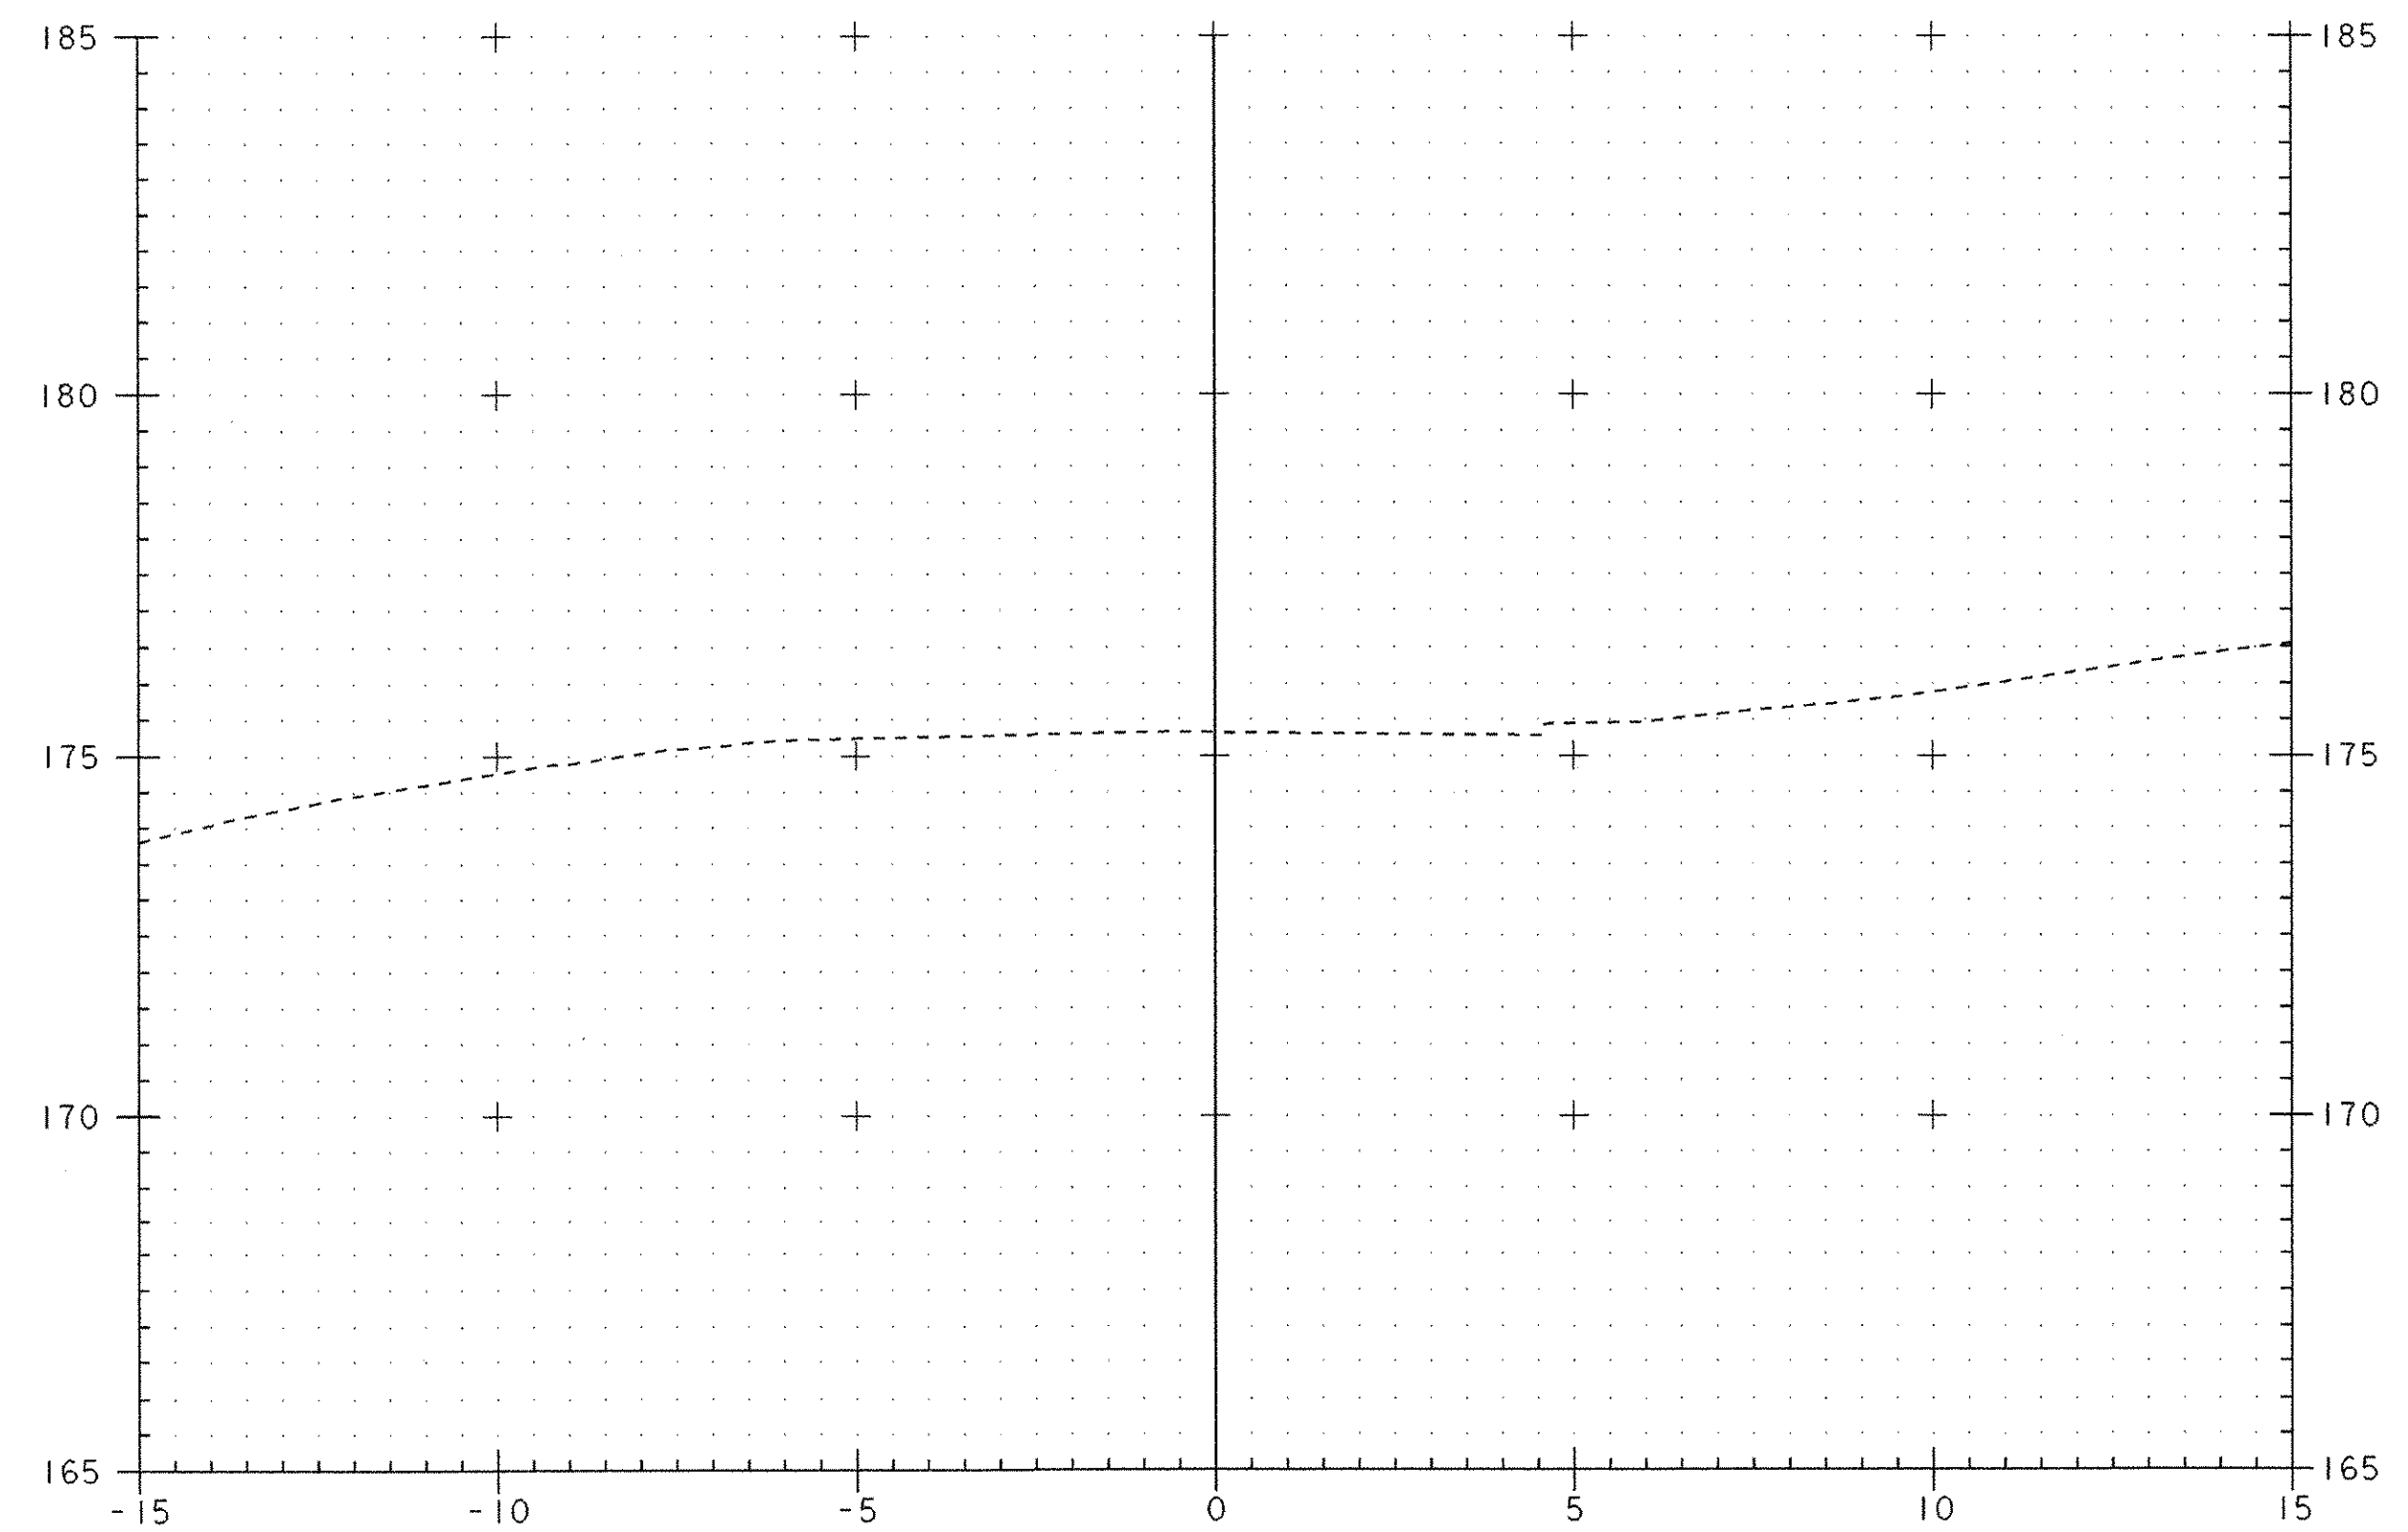

2+053

PROJECT: BETHEL	PROJECT NO. : BRF0241 (33) C/2
DESIGN FILE NAME: 02c180/Structures/s02c180xsec.dgn	PLOT DATE: 14-APR-2005
IPARM FILE NAME: sc180th52.i	
TOWN HIGHWAY 5 SECTIONS	
STA 2+040 Thru STA 2+053	SHEET: 93 OF 130