


AW
4-9-07

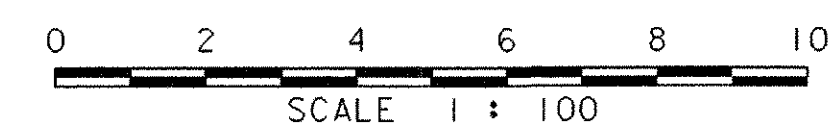

PROJECT: BETHEL	PROJECT NO. : BRF0241 (33) C/2
DESIGN FILE NAME: 02c180/Structures/s02c180xsec.dgn	PLOT DATE: 14-APR-2005
IPARM FILE NAME: sc180bm2.i	
BETHEL MILLS DRIVE SECTIONS	
STA 3+025 Thru STA 3+040	SHEET: 95 OF 130