
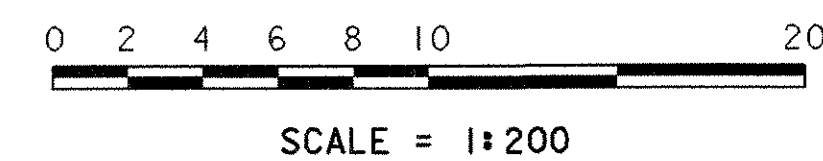


STA 4+026.000 LT (ABUTMENT 2)
 BEGIN STONE FILL TYPE III
 BEGIN GEOTEXTILE UNDER STONEFILL
 BEGIN GRUBBING MATERIAL
 BEGIN UNCLASSIFIED CHANNEL EXCAVATION

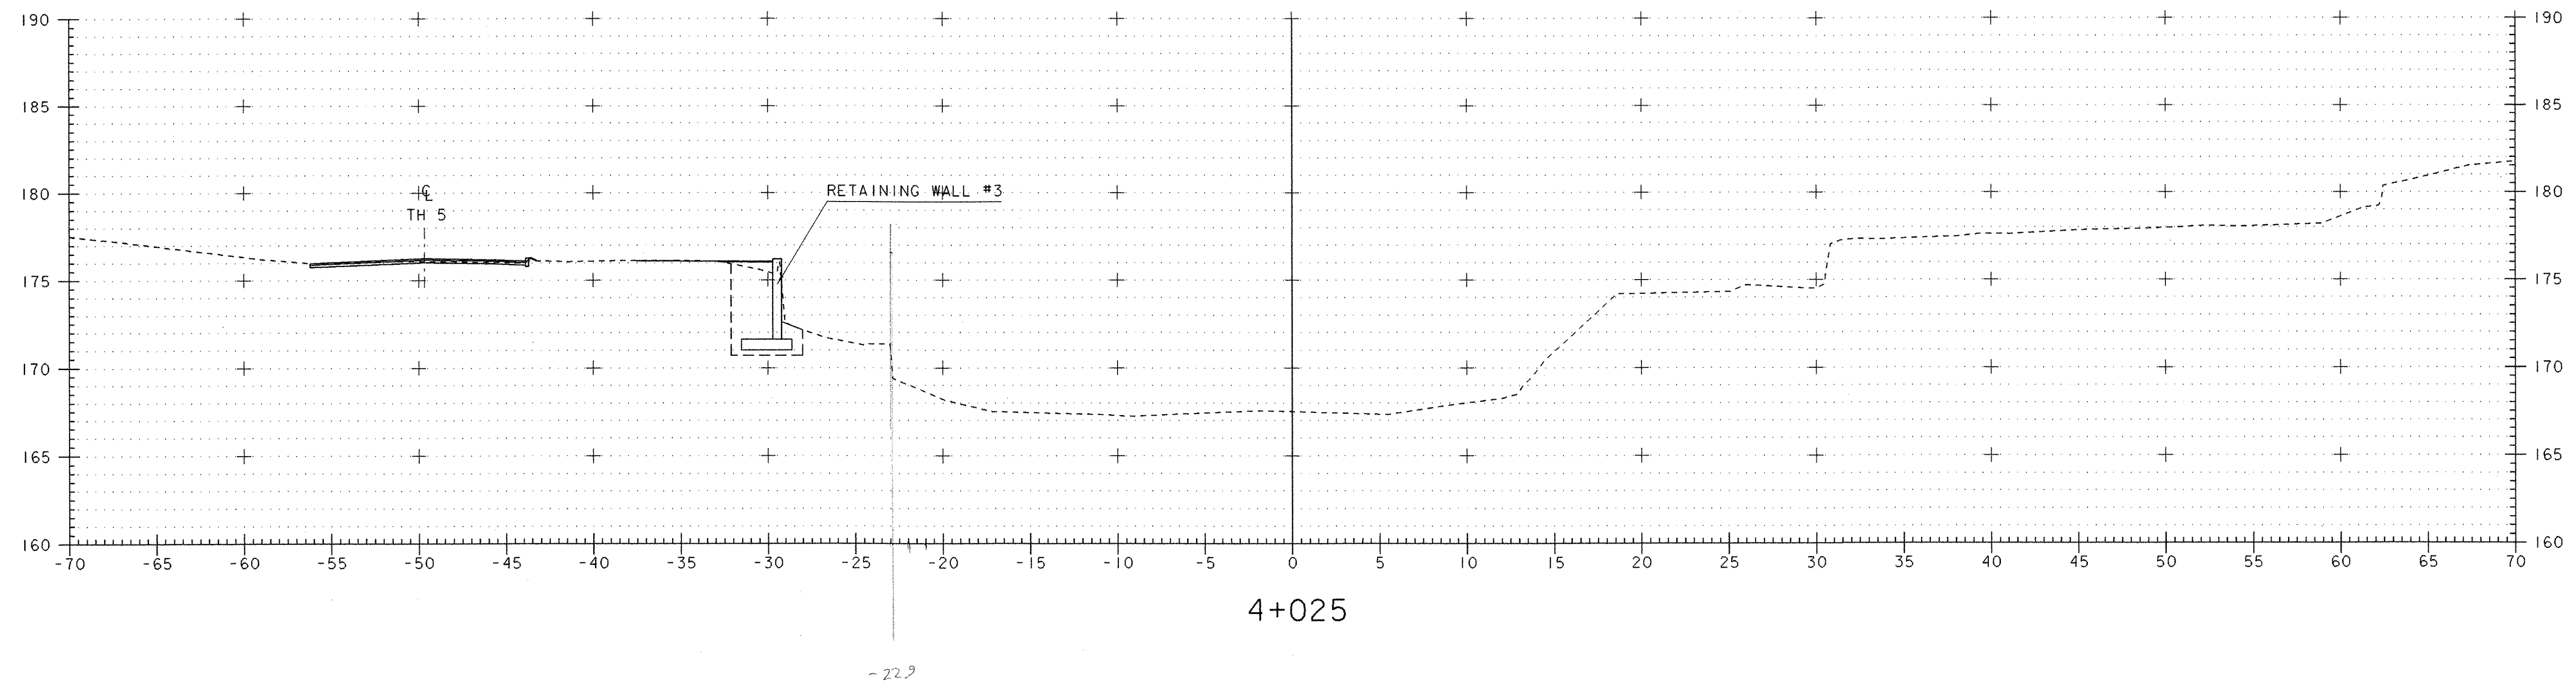

PROJECT: BETHEL	PROJECT NO. : BRF0241 (33) C/2
DESIGN FILE NAME: 02c180/Structures/s02c180xsec.dgn	PLOT DATE: 14-APR-2005
IPARM FILE NAME: sc180ch2.i	
CHANNEL CROSS SECTIONS STA 4+025 AND STA 4+030	SHEET: 98 OF 130