


4+032.8
 30% UNCLASS. CHAN. 13.32 SM
 STA 4+033.000 RT (PIER)

BEGIN STONE FILL TYPE III
 BEGIN GEOTEXTILE UNDER STONEFILL
 BEGIN GRUBBING MATERIAL

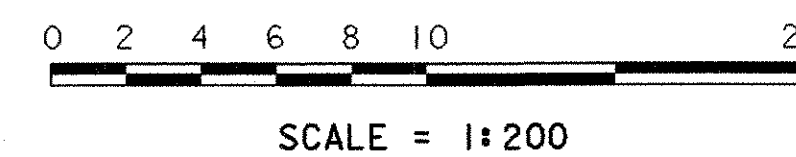

PROJECT: BETHEL	PROJECT NO. : BRF0241 (33) C/2
DESIGN FILE NAME: 02c180/Structures/s02c180xsec.dgn	PLOT DATE: 14-APR-2005
IPARM FILE NAME: sc180ch3.i	
CHANNEL CROSS SECTIONS	
STA 4+035 AND STA 4+040	SHEET: 99 OF 130

pal
 4-9-07

JHP 01/17/07