



(RT) (ABUT 1)
UNCLASS. CHAN. = 1.69 SM

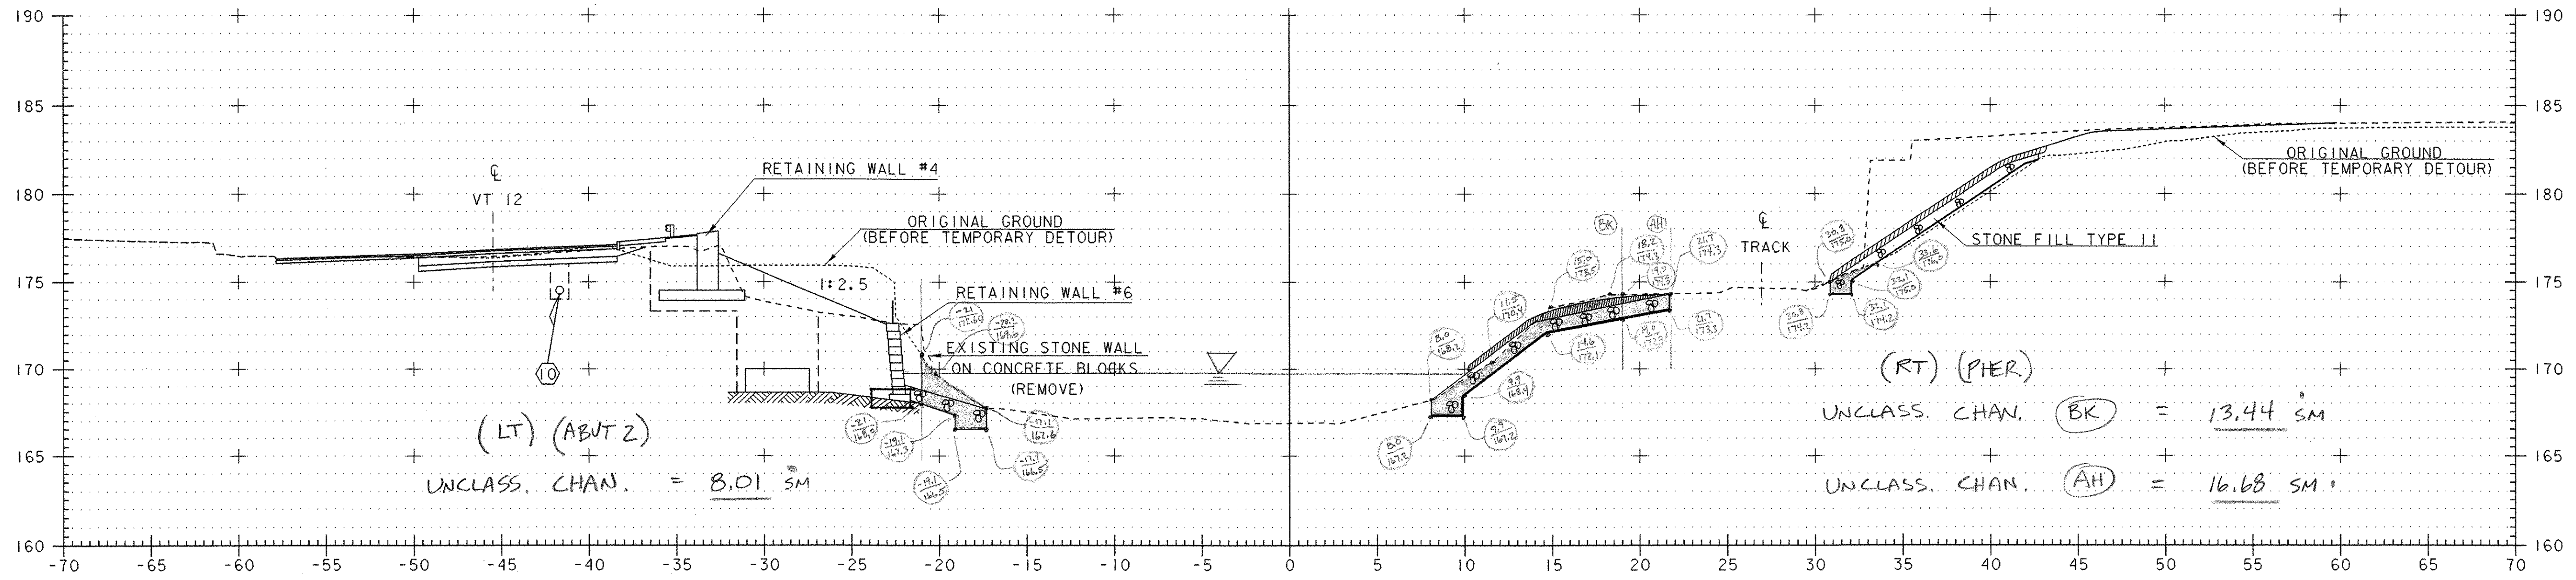


4+050

STA 4+047.000 RT (ABUTMENT 1)
BEGIN STONE FILL TYPE II
BEGIN GEOTEXTILE UNDER STONEFILL
BEGIN GRUBBING MATERIAL
BEGIN UNCLASSIFIED CHANNEL EXCAVATION

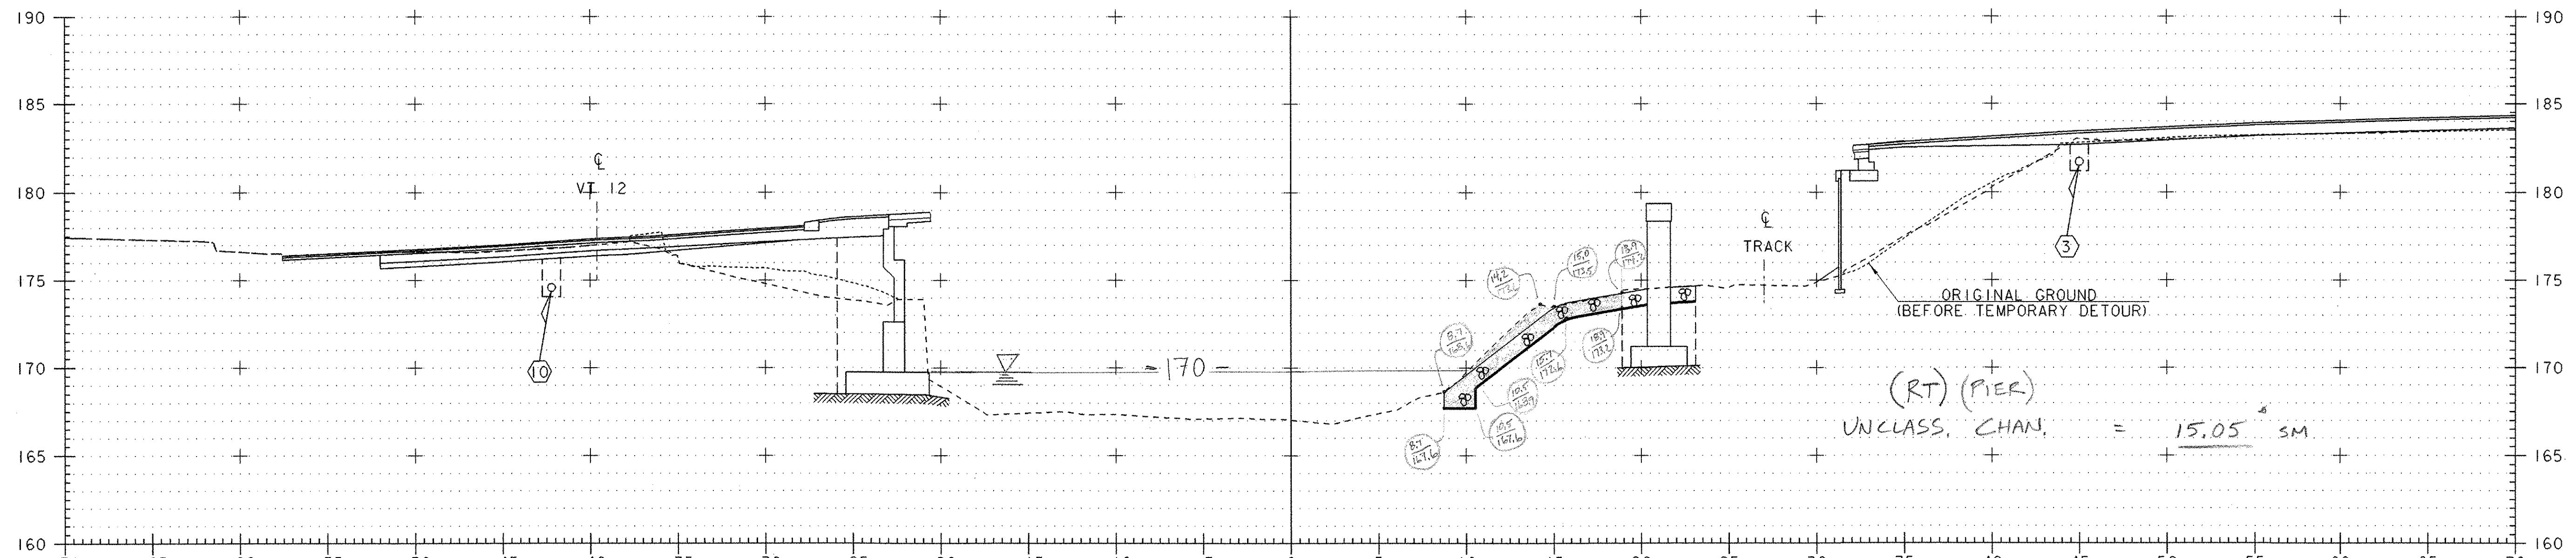

4+045

AKP 4-9-07 JHO 6/17/07

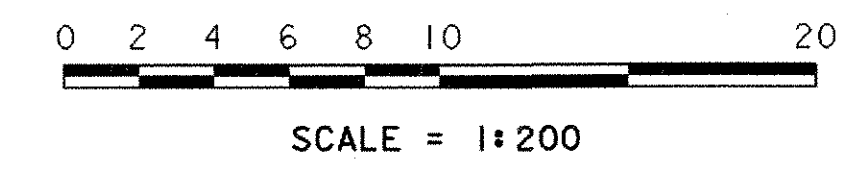

PROJECT: BETHEL	PROJECT NO. : BRF0241 (33) C/2
DESIGN FILE NAME: 02c180/Structures/s02c180xsec.dgn	PLOT DATE: 14-APR-2005
IPARM FILE NAME: sc180cht.i	
CHANNEL CROSS SECTIONS	
STA 4+045 AND STA 4+050	SHEET: 100 OF 130