



730
STA 4+068.000 LT (ABUTMENT 2)
END STONE FILL TYPE III
END GEOTEXTILE UNDER STONEFILL
END GRUBBING MATERIAL
END UNCLASSIFIED CHANNEL EXCAVATION

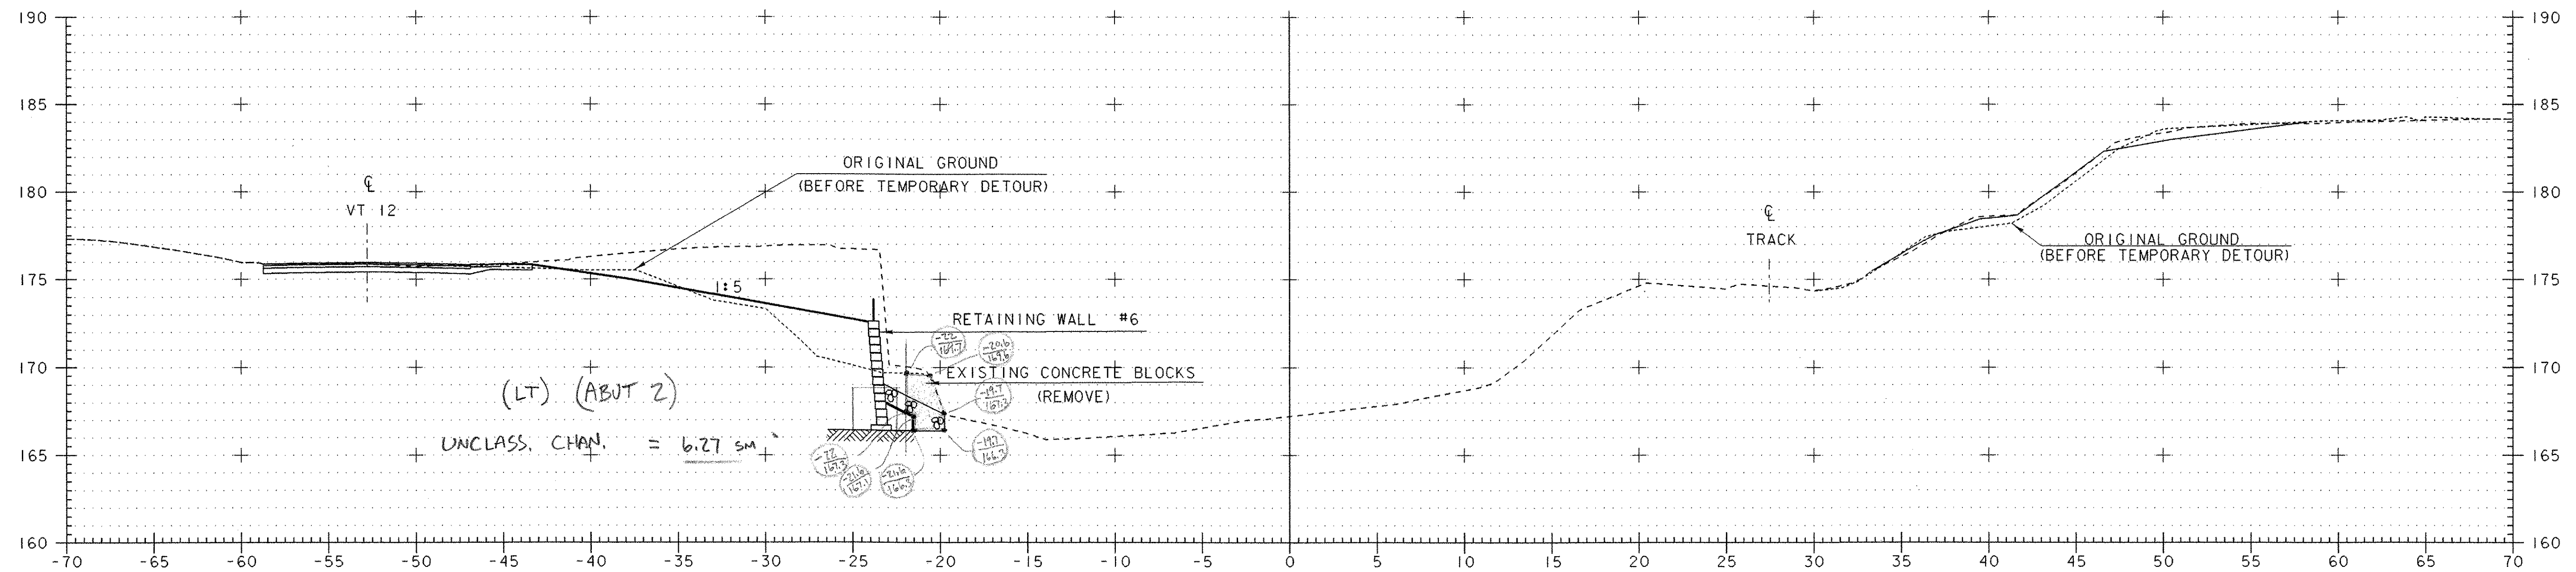

STA 4+064.500 RT (ABUTMENT 1)
END STONE FILL TYPE II
END GEOTEXTILE UNDER STONEFILL
END GRUBBING MATERIAL
END UNCLASSIFIED CHANNEL EXCAVATION

Paul
4-9-07

JHP
6/17/07

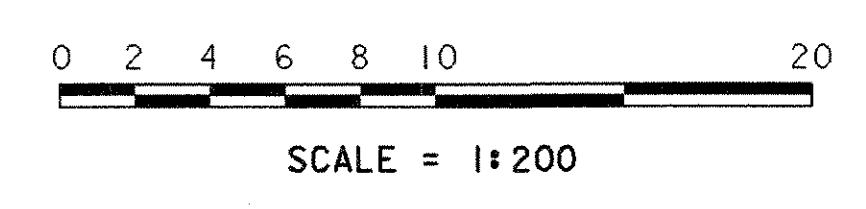

PROJECT: BETHEL	PROJECT NO. : BRF0241 (33) C/2
DESIGN FILE NAME: 02c180/Structures/s02c180xsec.dgn	PLOT DATE: 14-APR-2005
IPARM FILE NAME: sc180ch7.i	
CHANNEL CROSS SECTIONS	
STA 4+065 ANS STA 4+070	SHEET: 102 OF 130