



NOTE:
 FOR EROSION MATTING LOCATION
 SEE SHEET 116 APPLICATION
 NOTE B
 APPLY THE URBAN SEED FORMULA
 ON TOP SOIL TO ALL SLOPES
 GREATER THAN 1:1.5

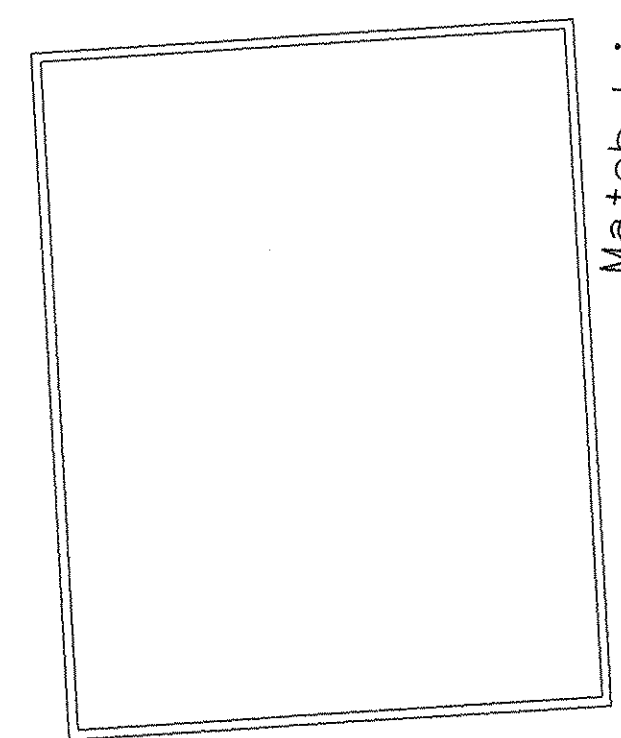

EROSION CONTROL
FINAL CONDITIONS - SHEET 1

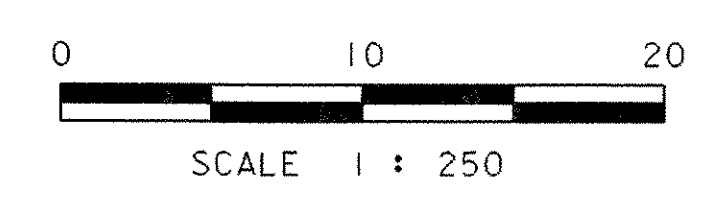

DATUM	
VERTICAL	NAVD 88
HORIZONTAL	NAD 83/92

PROJECT: BETHEL	PROJECT NO. : BRF0241 (33) C/2
DESIGN FILE NAME: 02c180/structures/s02c180bdr.dgn	PLOT DATE: 14-APR-2005
IPARM FILE NAME: sc180finalcond1.i	SURVEY DATE: 10/99
SURVEYED BY: ORVIS	DRAWN BY: J. L. SCHULTZ
SQUAD LEADER: C. P. WILLIAMS	SHEET: 109 OF 130
FINAL CONDITIONS SHEET 1	