


NOTE:
 FOR EROSION MATTING LOCATION
 SEE SHEET 116 APPLICATION
 NOTE B.
 APPLY THE URBAN SEED FORMULA
 ON TOP SOIL TO ALL SLOPES
 GREATER THAN 1:1.5

**EROSION CONTROL
 FINAL CONDITIONS - SHEET 2**

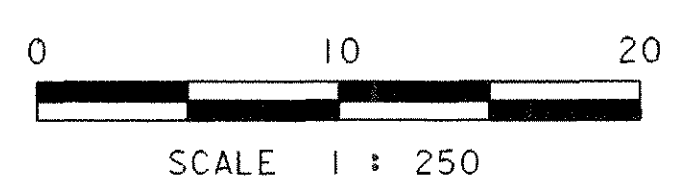

DATUM	
VERTICAL	NAVD 88
HORIZONTAL	NAD 83/92

PROJECT: BETHEL	PROJECT NO. : BRF0241 (33) C/2
DESIGN FILE NAME: 02c180/structures/s02c180bdr.dgn	IPARM FILE NAME: sc180finalcond2.i
SURVEYED BY: ORVIS	SURVEY DATE: 10/99
SQUAD LEADER: C. P. WILLIAMS	DRAWN BY: J. L. SCHULTZ
FINAL CONDITIONS SHEET 2	SHEET: 110 OF 130