

"CUT" PANEL DIMENSION METHOD

NOTE: "LEFT" CUT SHOWN, RIGHT CUT MIRROR IMAGE


ALL PANELS SHOWN BACKFACE

FOR SECTIONS A-A THRU H-H; K-K THRU M-M, P-P, AND R-R THRU U-U SEE SHEET S2  
 FOR DETAILS N, O AND P, SEE SHEET S3  
 ALL DOWELS ARE 450mm IN LENGTH WITH 300mm EMBEDDED

*No Add Details*  
*OK*  
*2' tall 10" thick*

RECEIVED  
 OK'D BY KMY OK'D BY M.G.  
 JUL 28 2005  
 SUBMITTED BY OPW APPROVED [Signature]  
 DATE 8/31/05

CERTIFIED WITH RESPECT TO THE INTERNAL STABILITY OF REINFORCED EARTH STRUCTURES ONLY

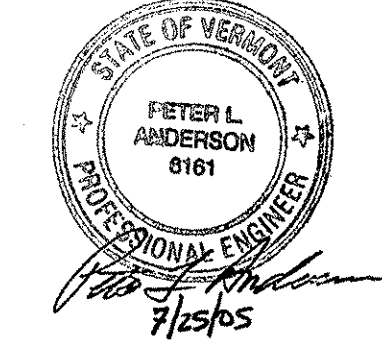

VT AOT PROJ. NO. BRF 0241 (33) C/2

C:\SHARED\11843\SHOPS\11843\_S04.DWG

This drawing contains information proprietary to The Reinforced Earth Company, and is being furnished for the use of VT AOT only in connection with this project, and the information contained herein is not to be transmitted to any other organization unless specifically authorized in writing by The Reinforced Earth Company. The Reinforced Earth Company is exclusive licensee in the United States under patents issued to Henri Vidal, and the furnishing of this drawing does not constitute an expressed or implied license under the Vidal patents.

The design contained on these drawings is based on information provided by the owner. On the basis of this information, The Reinforced Earth Company has designed, and is responsible for the internal stability of the structure only. External stability, including foundation and slope stability, is the responsibility of the owner.

**The Reinforced Earth Company**  
 8614 Westwood Center Drive Suite 1100, Vienna, Virginia 22182 (703) 821-1175

"REINFORCED EARTH" is the registered trademark of The Reinforced Earth Company.

DESIGNED BY:	JMKC	PROJECT ENGR:	JMKC	CHECKED BY:	KPB	ENG. MANAGER:		REV.	DATE	DESCRIPTION	DRAWING COVERS	PROJECT NAME	BRIDGE IMPROVEMENT VT 12 OVER NEW ENGLAND CENTRAL RAILROAD	DATE	7/21/2005
LOCATION:		OWNER:	VT AOT	SCALE:	1:60 per	DRAWING NO.:	S4 OF S8	PANEL CASTING DRAWINGS			AS SHOWN	CONTRACT NO.:	11843		