


5+ 990 SAME AS  
5+ 988

180


175

170

165

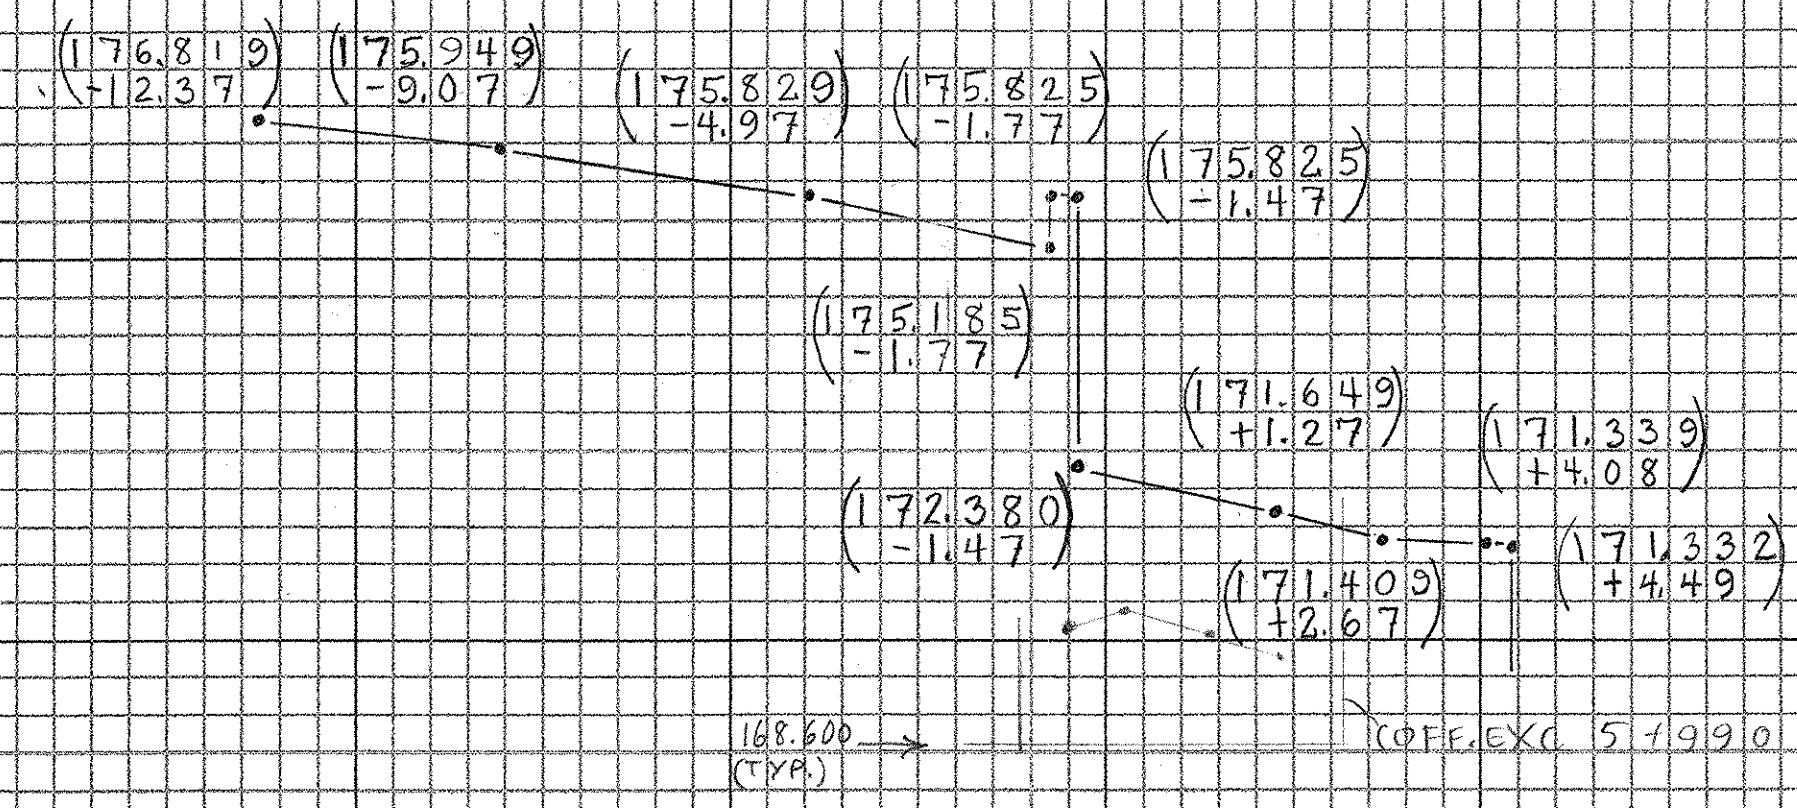

5+ 988

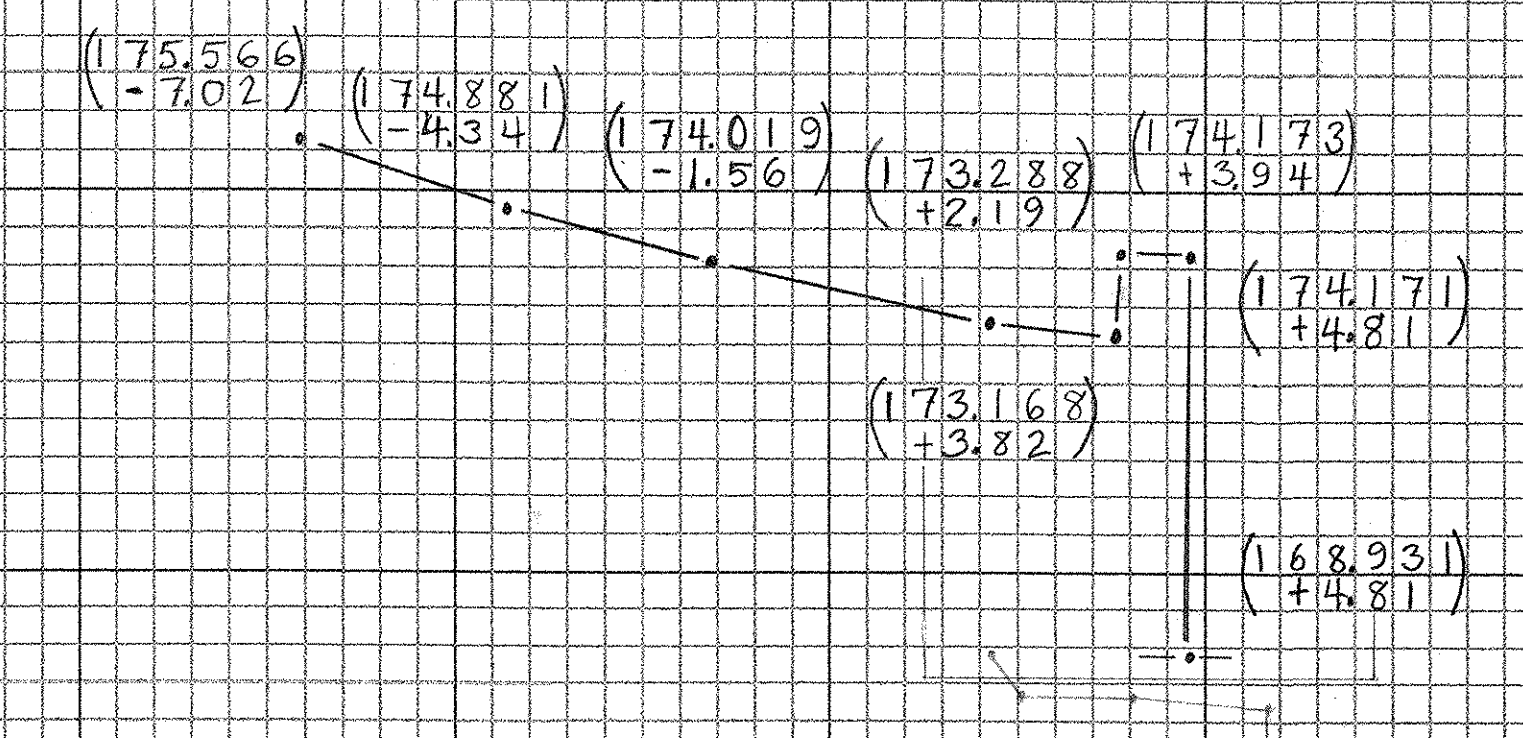


5+ 996.5

180


175

170

165

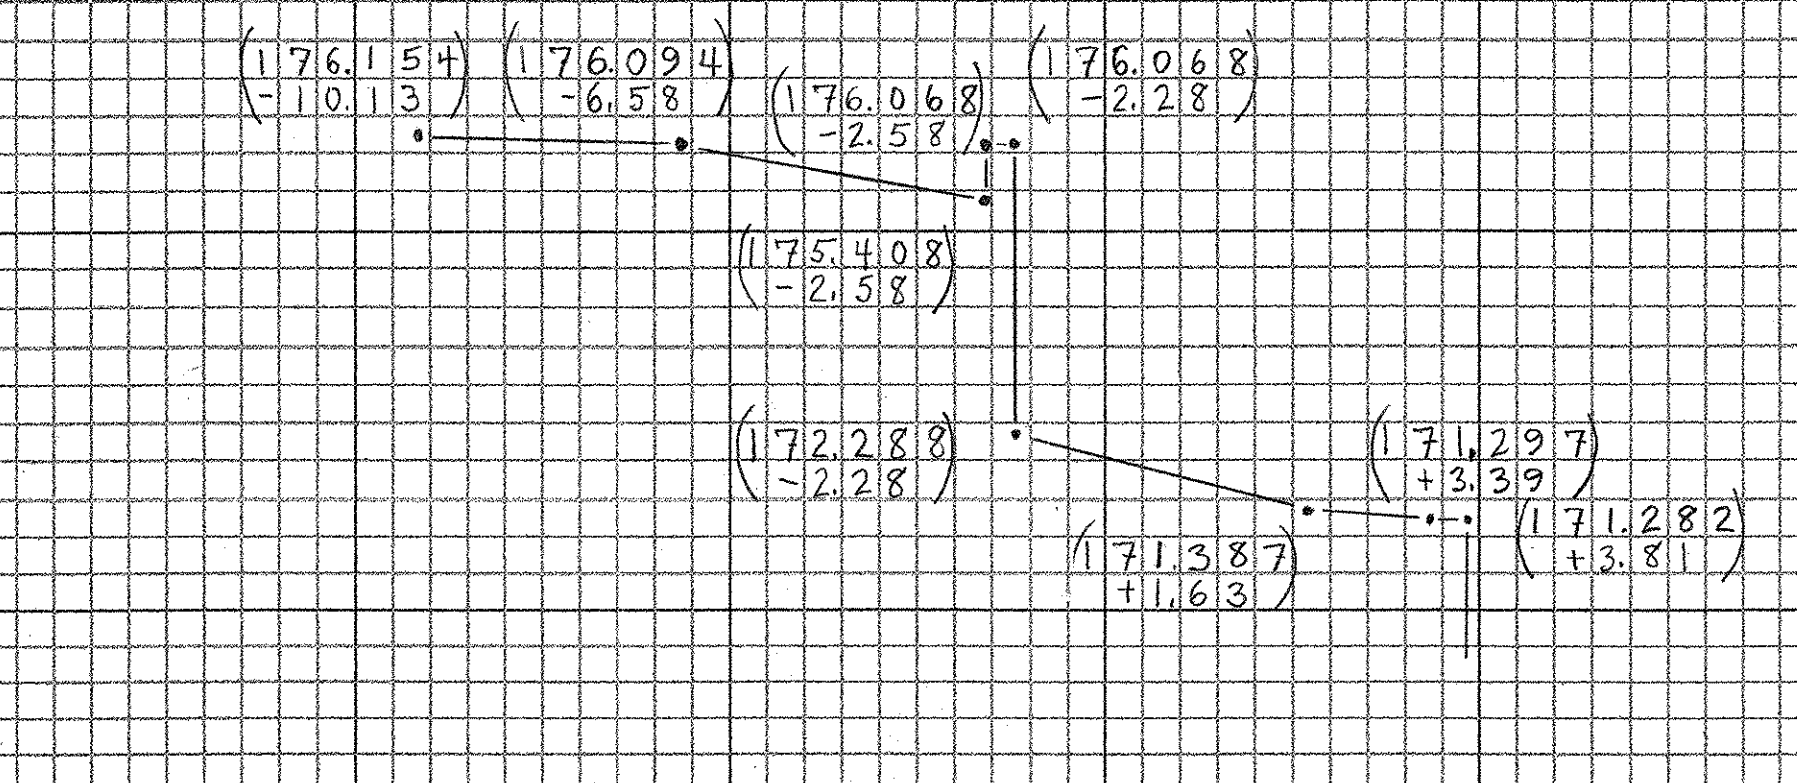

5+ 982

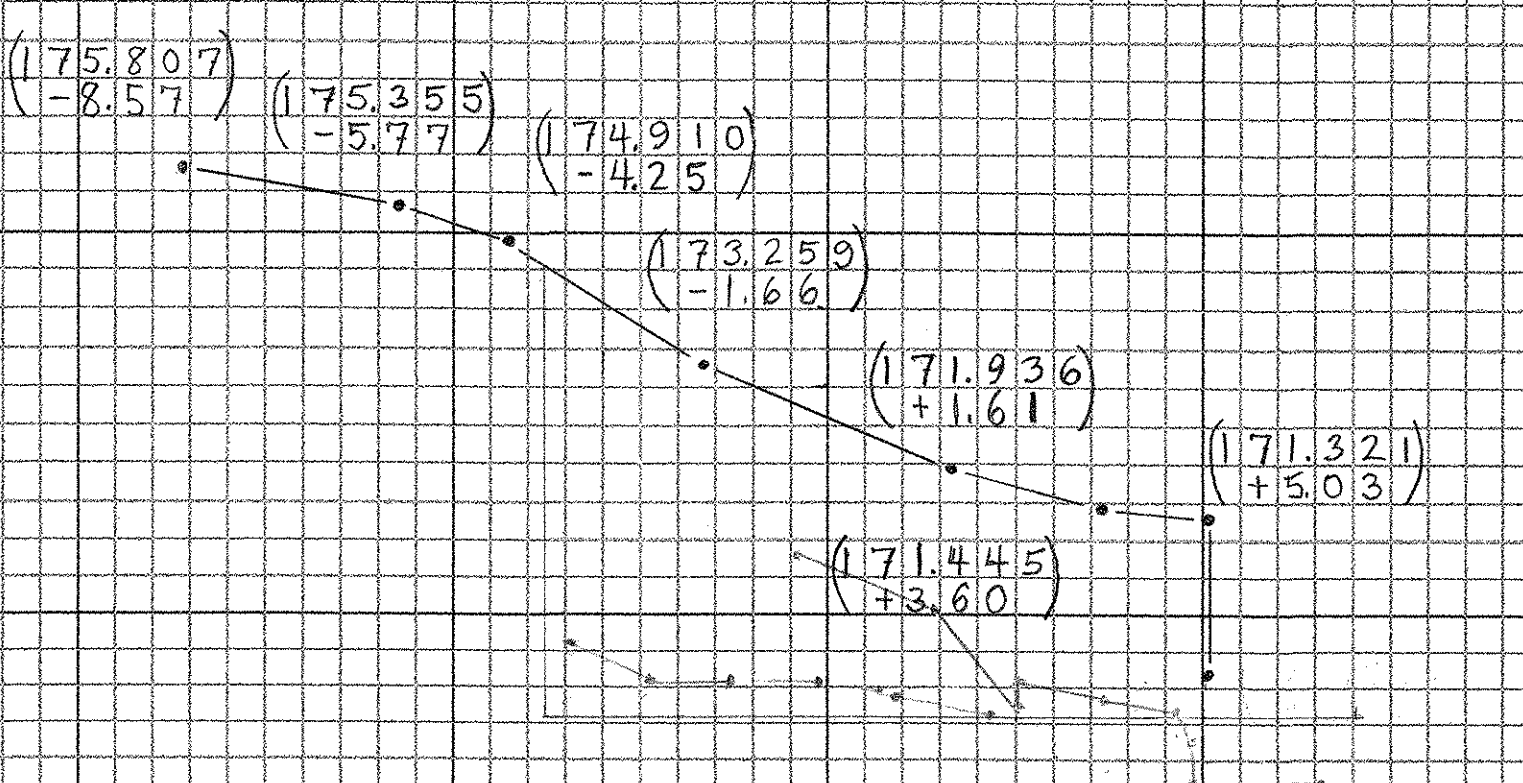

5+ 993



CROSS SECTION SHEET

PROJECT NAME: BETHEL  
 PROJECT NUMBER: BRF 0241 (33) C/2  
 FILE NAME: ABUT.2 X SECTIONS PLOT DATE: 07-JUN-2000 13:  
 PROJECT LEADER: W.R. STODDARD DRAWN BY: E. WESTBERG  
 DESIGNED BY: CHECKED BY:  
 const: g:/common/cadd/m-xsection.dgn SHEET 189 OF 2