


CONSTRUCT DRIVE	
LEFT	RIGHT
10+055	10+080
10+220	10+160
10+269	10+203
10+300	10+283
10+344	10+286
10+374	10+371

Granite Slope Edding	
LEFT	RIGHT
Sta 10+095.5 to 10+150.7	RT
Sta 10+168.3 to 10+198.7	RT
Sta 10+208.3 to 10+258.4	RT
Sta 10+328.5 to 10+363.7	LT
Sta 10+367.8 to 10+381.1	RT
Sta 10+392.2 to 10+402.2	LT
Sta 10+424.5 to 10+513.6	RT
Sta 10+524.8 to 10+565.4	RT
Sta 10+549.8 to 10+568.3	LT
Sta 10+577.4 to 10+589.8	LT
Sta 10+577.4 to 10+405.0	LT
10+256 - 10+263.4	LT
10+359 - 10+368.0	LT

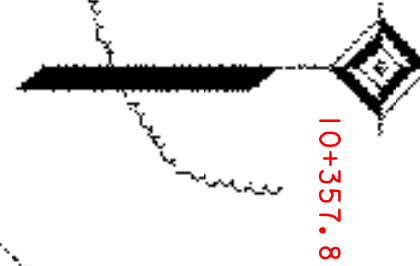

DATUM
VERTICAL NGVD 1929
HORIZONTAL NAD 1927

NOTE:
THE RELOCATION OF UTILITIES (POLES ANCHORS, ETC.) WILL BE PERFORMED BY THE UTILITY COMPANY. THE EXISTING UNDERGROUND TELEPHONE LINE WILL BE ABANDONED IN PLACE. REMOVAL AND DISPOSAL OF LINES WILL BE THE CONTRACTORS RESPONSIBILITY.

GRAPHIC SCALE
(IN FEET)
1 : 500

THE LOUIS BERGER GROUP, INC.

ROUTE 121 LAYOUT PLAN - 100% DESIGN
PROJECT: GRAFTON-ROCKINGHAM, ROUTE 121
PROJECT NO.: STP 0128(4)S
DESIGN FILE NAME:
P/ARM FILE NAME:
SURVEYED BY:
SQUAD LEADER:
PLOT DATE: 12/08/03
SURVEY DATE:
DRAWN BY:
SHEET: 11 OF 118

SEE WATER LINE SKETCH BELOW