


HIGH POINT ELEV = 190.369  
 HIGH POINT STA = 10+729.819  
 PM STA = 10+724.750  
 PM ELEV = 191.330  
 A.D. = -8.656  
 K = 10.397  
 90.000m VC

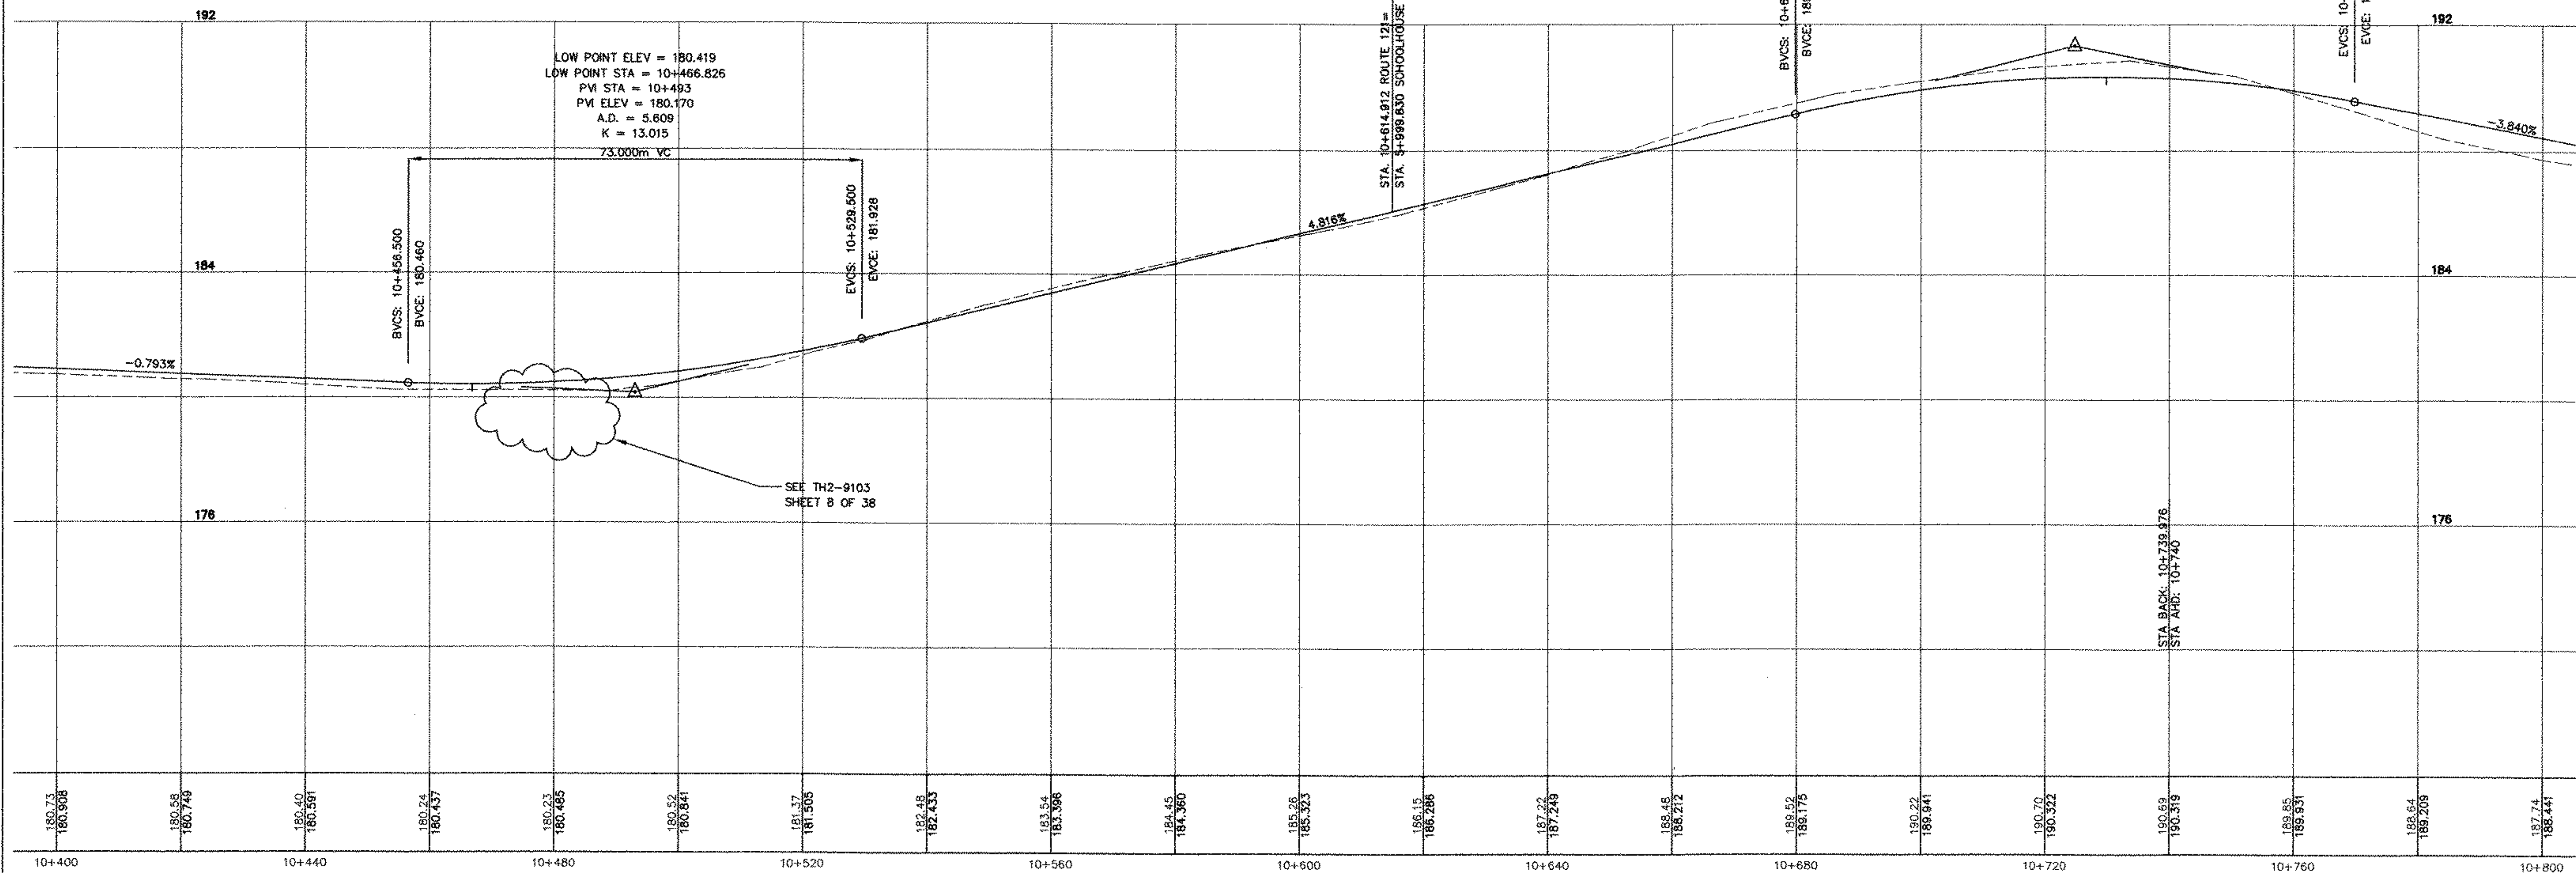

LOW POINT ELEV = 180.419  
 LOW POINT STA = 10+466.826  
 PM STA = 10+493  
 PM ELEV = 180.170  
 A.D. = 5.609  
 K = 13.015  
 73.000m VC

STA. 10+614.912 ROUTE 121 =  
 STA. 3+998.630 SCHOOLHOUSE ROAD

STA. BACK: 10+739.976  
 STA. AHD: 10+740

SEE TH2-9103  
 SHEET 8 OF 38

GRAPHIC SCALE



DATUM	
VERTICAL	NGVD 1929
HORIZONTAL	NAD 1927

Y: /1261/CADD/PLANS/PROFILE-ROUTE 121-C2.DWG

ROUTE 121 PROFILE

PROJECT: GRAFTON-ROCKINGHAM, ROUTE 121	PROJECT NO. : STP 0126(4)S
DESIGN FILE NAME: IPARM FILE NAME: SURVEYED BY: SQUAD LEADER:	PLOT DATE: 12/08/03 SURVEY DATE: DRAWN BY: SHEET: 20 OF 116