


GRAPHIC SCALE

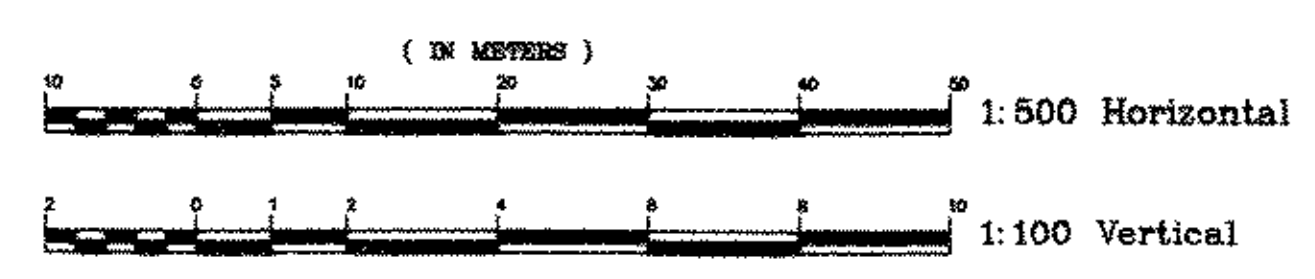

DATUM
 VERTICAL NGVD 1929
 HORIZONTAL NAD 1927

V: /1261/CADD/PLANS/PROFILE-ROUTE 121-C2.DWG

THE LOUIS BERGER GROUP, INC.

ROUTE 121 PROFILE	
PROJECT: GRAFTON-ROCKINGHAM, ROUTE 121	PROJECT NO. : STP 0126(4)S
DESIGN FILE NAME: IPARM FILE NAME: SURVEYED BY: SQUAD LEADER:	PLOT DATE: 12/08/03 SURVEY DATE: DRAWN BY: SHEET: 24 OF 116