


DATUM	
VERTICAL	NGVD 1929
HORIZONTAL	NAD 1927

V:/1261/CADD/PLANS/PROFILE--ROUTE 121--C2.DWG

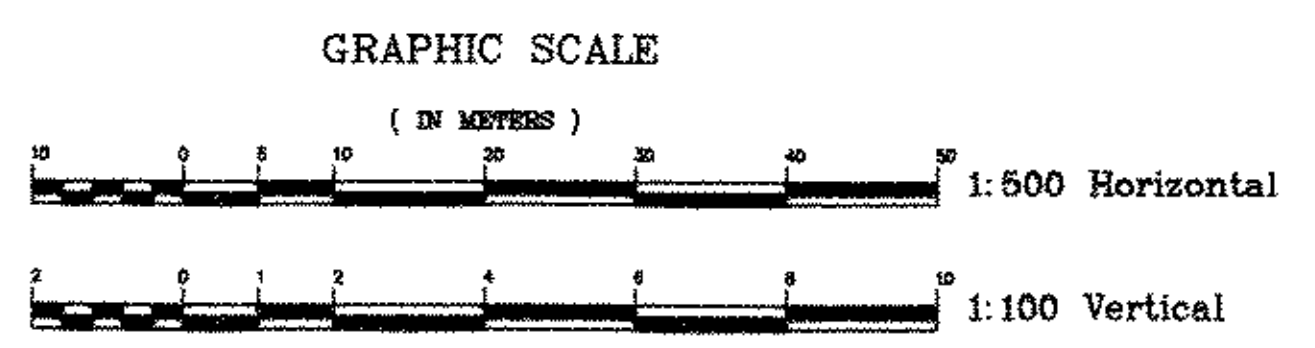

THE LOUIS BERGER GROUP, INC.

ROUTE 121 PROFILE	
PROJECT: GRAFTON-ROCKINGHAM, ROUTE 121	PROJECT NO. : STP 0126(4)S
DESIGN FILE NAME: IPARM FILE NAME: SURVEYED BY: SQUAD LEADER:	PLOT DATE: 12/08/03 SURVEY DATE: DRAWN BY: SHEET: 25 OF 116