


- NOTE**
- 1) TRAFFIC CONTROL SIGNS AT THE END OF CONTRACT #2 ARE TO BE INSTALLED UPON COMPLETION OF CONTRACT #1.
 - 2) REFER TO VTRANS DESIGN STANDARD E-100M FOR ADDITIONAL DETAIL.

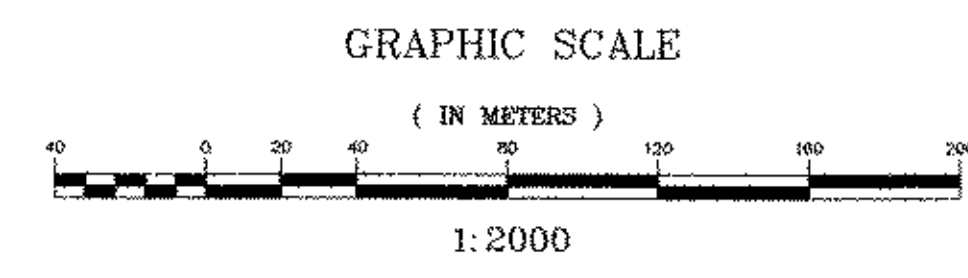

DATUM	
VERTICAL	NGVD 1929
HORIZONTAL	NAD 1927

v: /1261/CADD/PLANS/TCP-SIGNS-C2.DWG

TRAFFIC CONTROL SIGNS - CONTRACT #2	
PROJECT: GRAFTON-ROCKINGHAM, ROUTE 121	PROJECT NO. : STP 0126(4)S
DESIGN FILE NAME: IPARM FILE NAME: SURVEYED BY: SQUAD LEADER:	PLOT DATE: 12/08/03 SURVEY DATE: DRAWN BY: SHEET: 36 OF 116