


- 1.) WORK IN CAMBRIDGEPORT TO BEGIN AFTER COMPLETION OF WEAVER BROOK BRIDGE. BEGIN CONSTRUCTION AT WEAVER BORRK BRIDGE AND WORK WEST, RIGHT SIDE FIRST, THEN LEFT SIDE.
- 2.) CONSTRUCT ROADWAY UTILIZING ALTERNATING ONE WAY TRAFFIC.
- 3.) MAINTAIN ACCESS TO DRIVEWAYS THROUGHOUT CONSTRUCTION.
- 4.) ROADWAY MUST BE CONSTRUCTED TO AT LEAST TOP OF SUBBASE AT THE END OF EVERY WORK DAY.

- 1.) WORK TO BEGIN AFTER COMPLETION OF WEAVER BROOK BRIDGE.
- 2.) CONSTRUCT ROADWAY UTILIZING ALTERNATING ONE WAY TRAFFIC.
- 3.) MAINTAIN ACCESS TO DRIVEWAYS THROUGHOUT CONSTRUCTION.
- 4.) ROADWAY MUST BE CONSTRUCTED TO AT LEAST TOP OF SUBBASE AT THE END OF EVERY WORK DAY.

- LEGEND**
- Construction completed in Phase 1
  - Construction after completion of Weaver Brook Bridge
  - Construction concurrent with Weaver Brook Bridge

DATUM	
VERTICAL	NGVD 1929
HORIZONTAL	NAD 1927

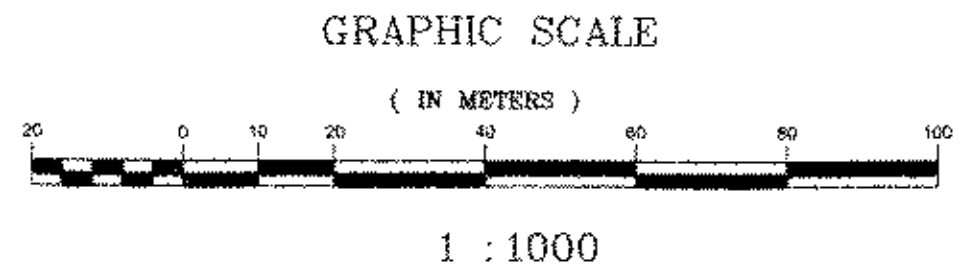

ROUTE 121 TRAFFIC CONTROL PLAN	
PROJECT: GRAFTON-ROCKINGHAM, ROUTE 121	PROJECT NO. : STP 0126(4)S
DESIGN FILE NAME: IPARM FILE NAME: SURVEYED BY: SQUAD LEADER:	PLOT DATE: 12/08/03 SURVEY DATE: DRAWN BY: SHEET: 40 OF 116