




LEGEND

- SILT FENCE
- — — HAY BALES
- ▨ GEOTEXTILE FOR STEEP SLOPE

GRAPHIC SCALE

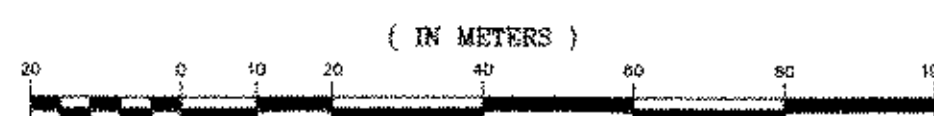

1 : 1000

DATUM	
VERTICAL	NGVD 1929
HORIZONTAL	NAD 1927

V: /1261/CADD/PLANS/EROSION_CONTROL-C2.DWG

ROUTE 121 EROSION CONTROL PLAN

PROJECT: GRAFTON-ROCKINGHAM, ROUTE 121	PROJECT NO. : STP 0126(4)S
DESIGN FILE NAME: IFARM FILE NAME: SURVEYED BY: SQUAD LEADER:	PLOT DATE: 12/08/03 SURVEY DATE: DRAWN BY: SHEET: 46 OF 116



THE LOUIS BERGER GROUP, INC.