


- LEGEND**
- SILT FENCE
 - HAY BALES
 - ▨▨▨▨ GEOTEXTILE FOR STEEP SLOPE

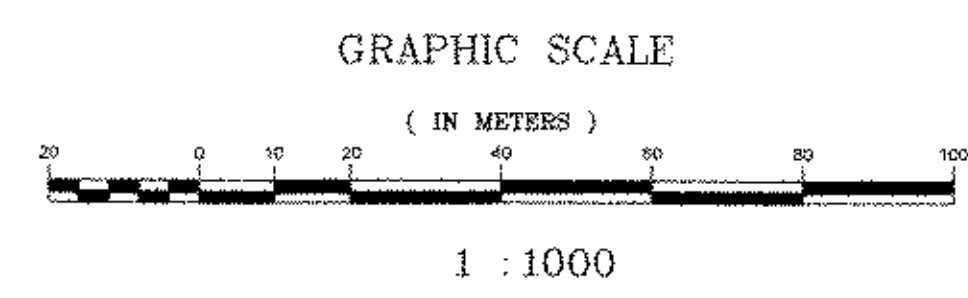

DATUM
 VERTICAL NGVD 1929
 HORIZONTAL NAD 1927

V: /1261/CADD/PLANS/EROSION_CONTROL-C2.DWG

THE LOUIS BERGER GROUP, INC.

ROUTE 121 EROSION CONTROL PLAN	
PROJECT: GRAFTON-ROCKINGHAM, ROUTE 121	PROJECT NO. : STP 0126(4)S
DESIGN FILE NAME: IPARM FILE NAME: SURVEYED BY: SQUAD LEADER:	PLOT DATE: 12/08/03 SURVEY DATE: DRAWN BY: SHEET: 47 OF 116