


LEGEND

- S — S — SILT FENCE
- - - - HAY BALES
- ▨ GEOTEXTILE FOR STEEP SLOPE

GRAPHIC SCALE

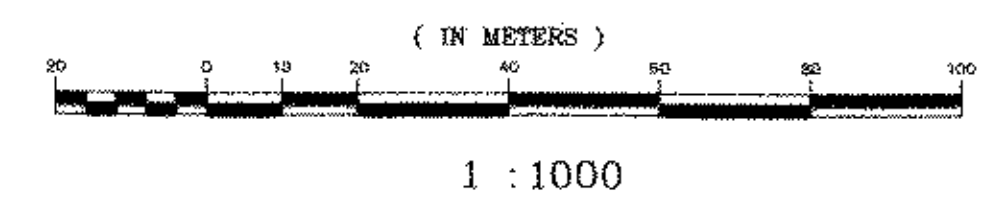

DATUM	
VERTICAL	NGVD 1929
HORIZONTAL	NAD 1927

V: /1281/CADD/PLANS/EROSION_CONTROL--C2.DWG

THE LOUIS BERGER GROUP, INC.

ROUTE 121 EROSION CONTROL PLAN	
PROJECT: GRAFTON-ROCKINGHAM, ROUTE 121	PROJECT NO. : STP 0126(4)S
DESIGN FILE NAME: IPARM FILE NAME: SURVEYED BY: SQUAD LEADER:	PLOT DATE: 12/08/03 SURVEY DATE: DRAWN BY: SHEET: 48 OF 116