


Hatch	Letter	KEY TO REVEGETATION TYPES
	(A)	VTRANS 'URBAN' GRASS MIX
	(B)	VTRANS 'RURAL' GRASS MIX
	(C)	BIDENDEMEERING IN STONE RIP RAP
	(D)	WILDFLOWERS
	(E)	WETLAND BUFFERS
	(F)	WETLANDS

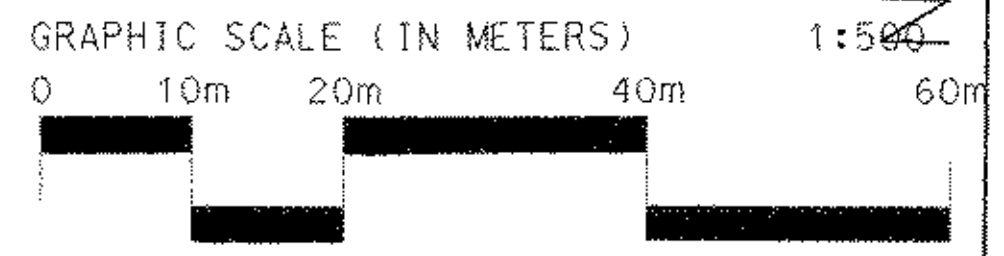

DATUM	
VERTICAL	
HORIZONTAL	

ROCKINGHAM
GRAFTON

ROUTE 121 LANDSCAPE PLAN - 100% DESIGN	
PROJECT: GRAFTON-ROCKINGHAM, ROUTE 121	PROJECT NO. : STP 0126(4)S
DESIGN FILE NAME: CONTRACT2.DGN IPARM FILE NAME: SURVEYED BY: SQUAD LEADER:	PLOT DATE: 12/08/03 SURVEY DATE: DRAWN BY: JTO SHEET: 49 OF 116