
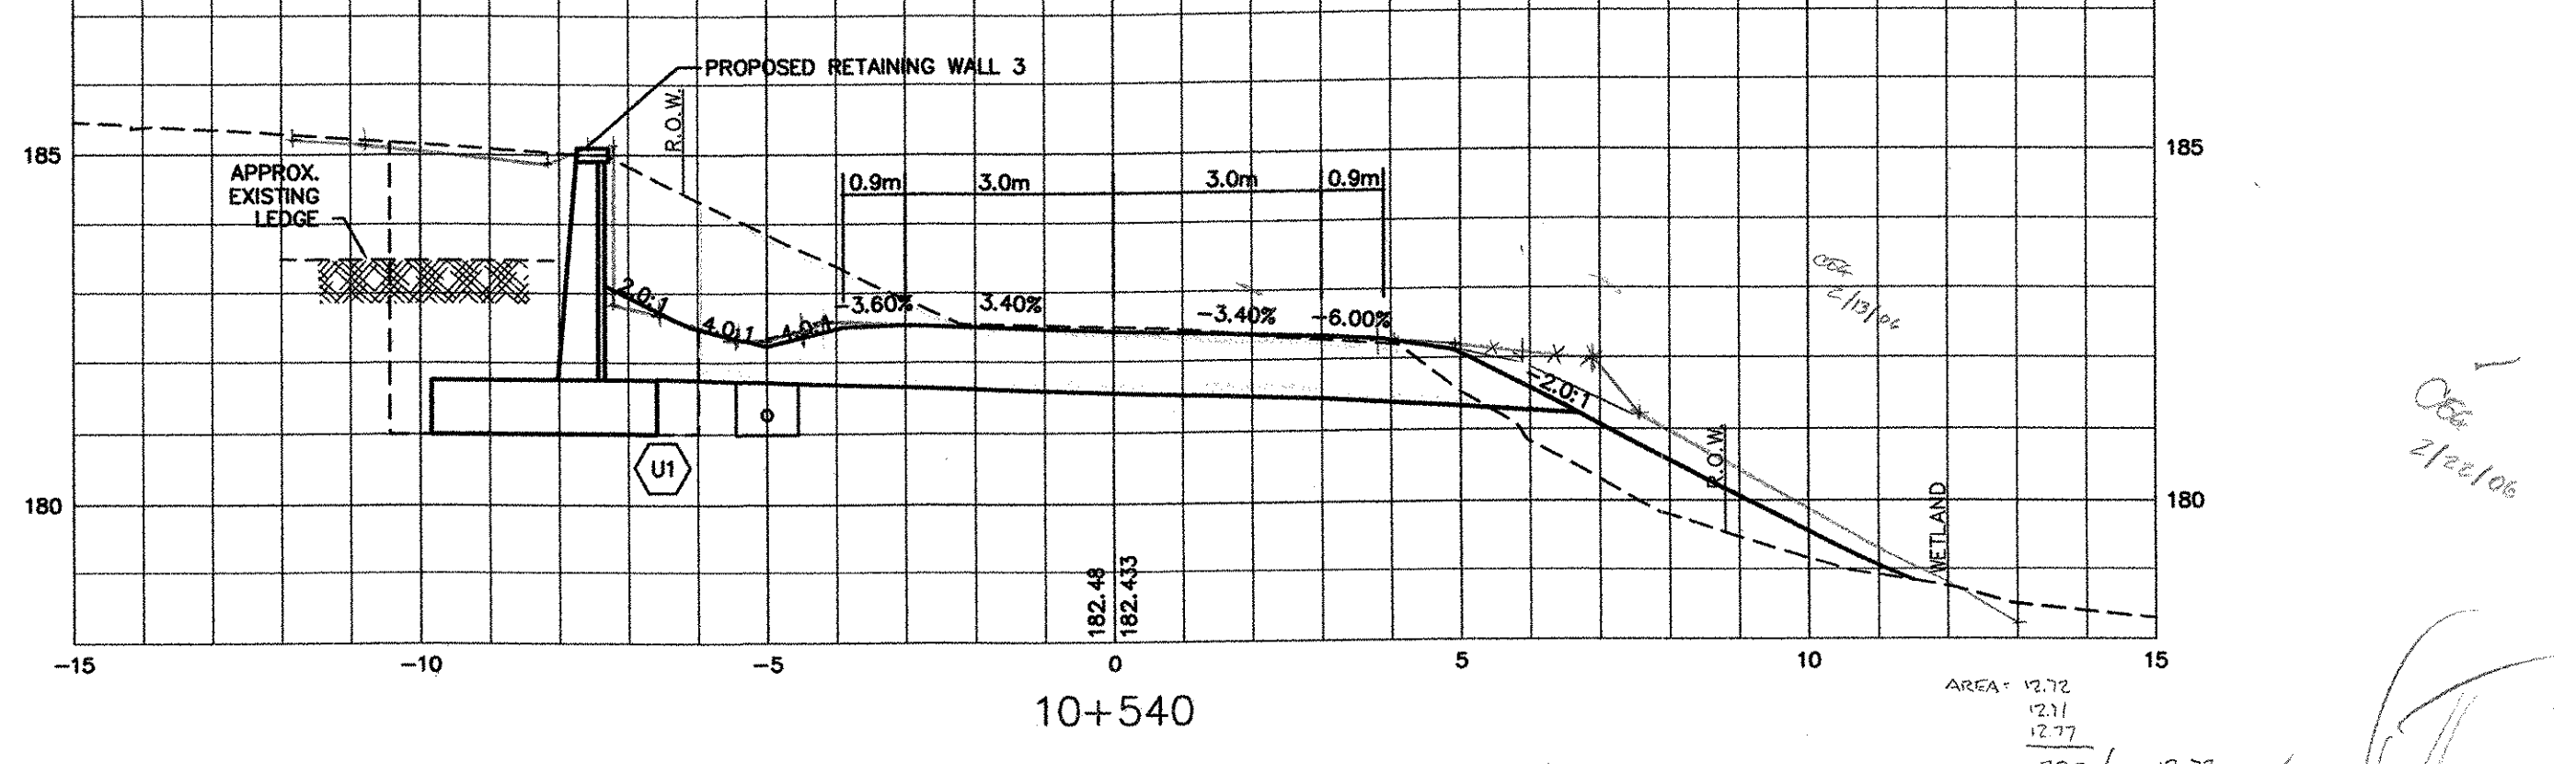
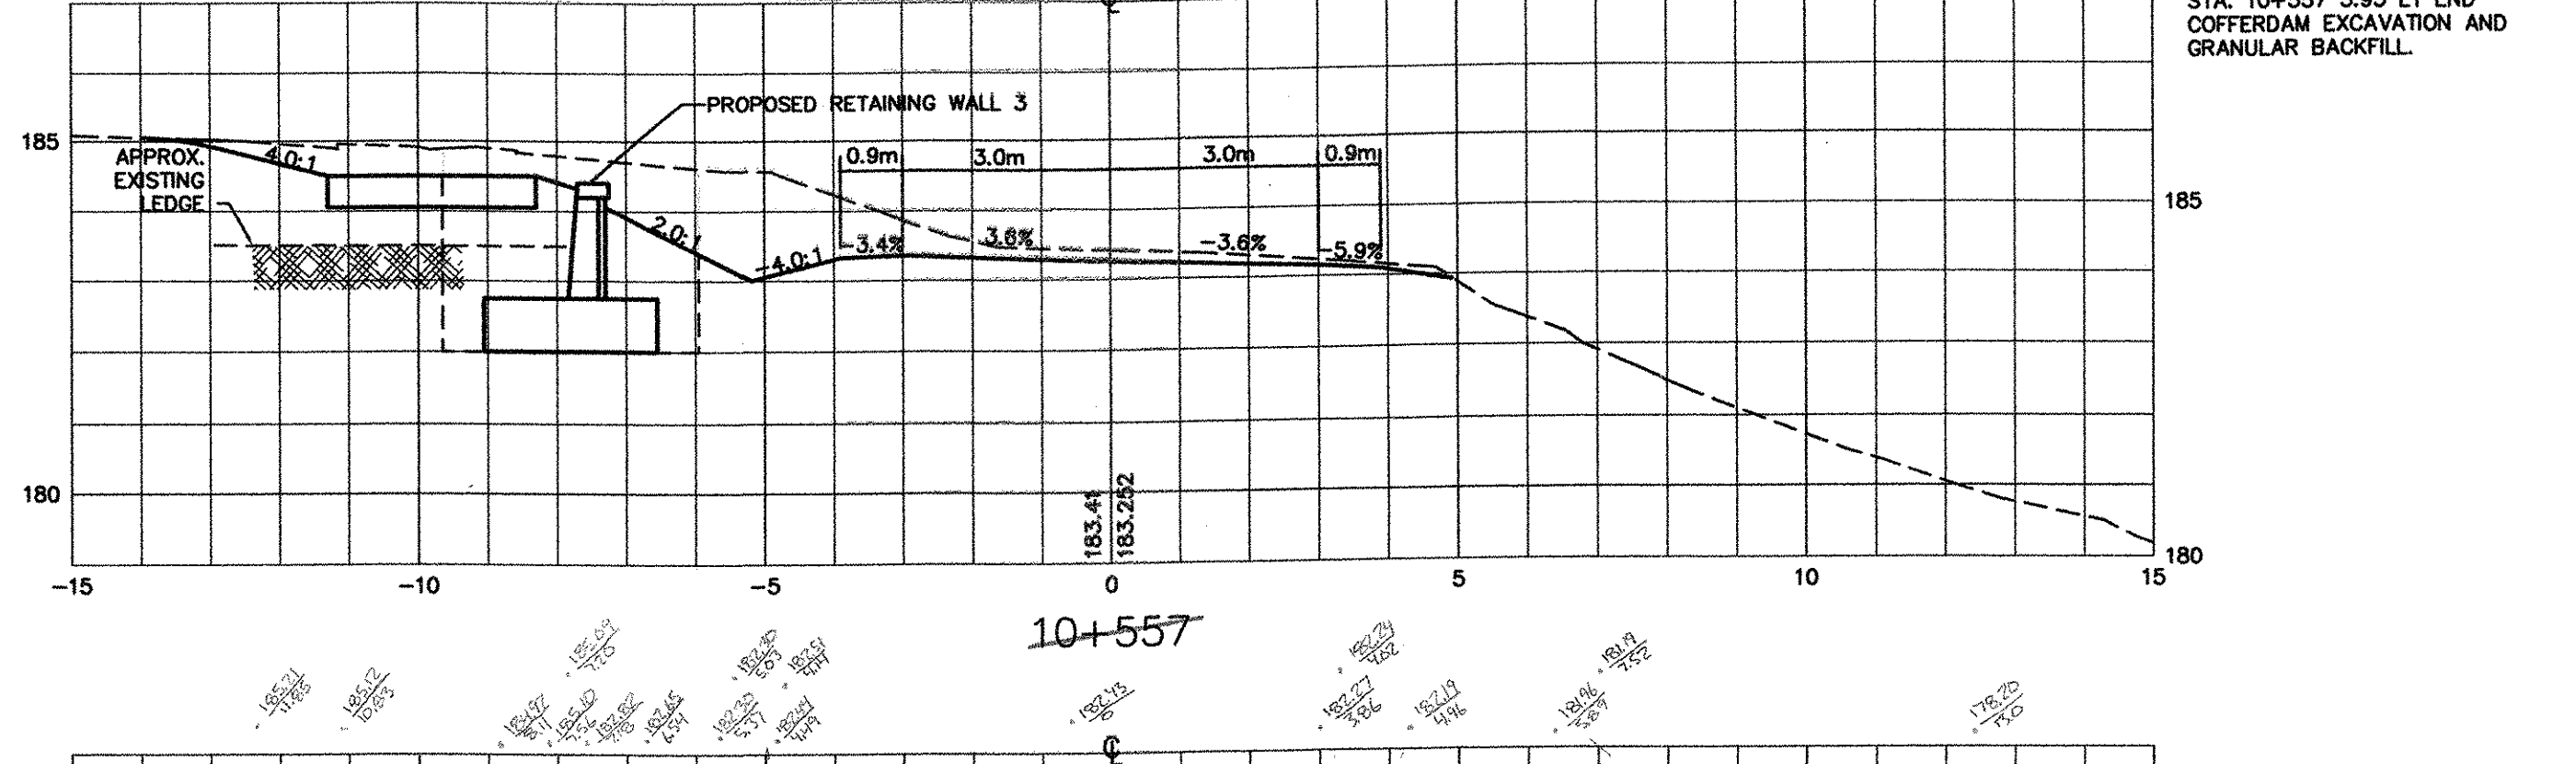
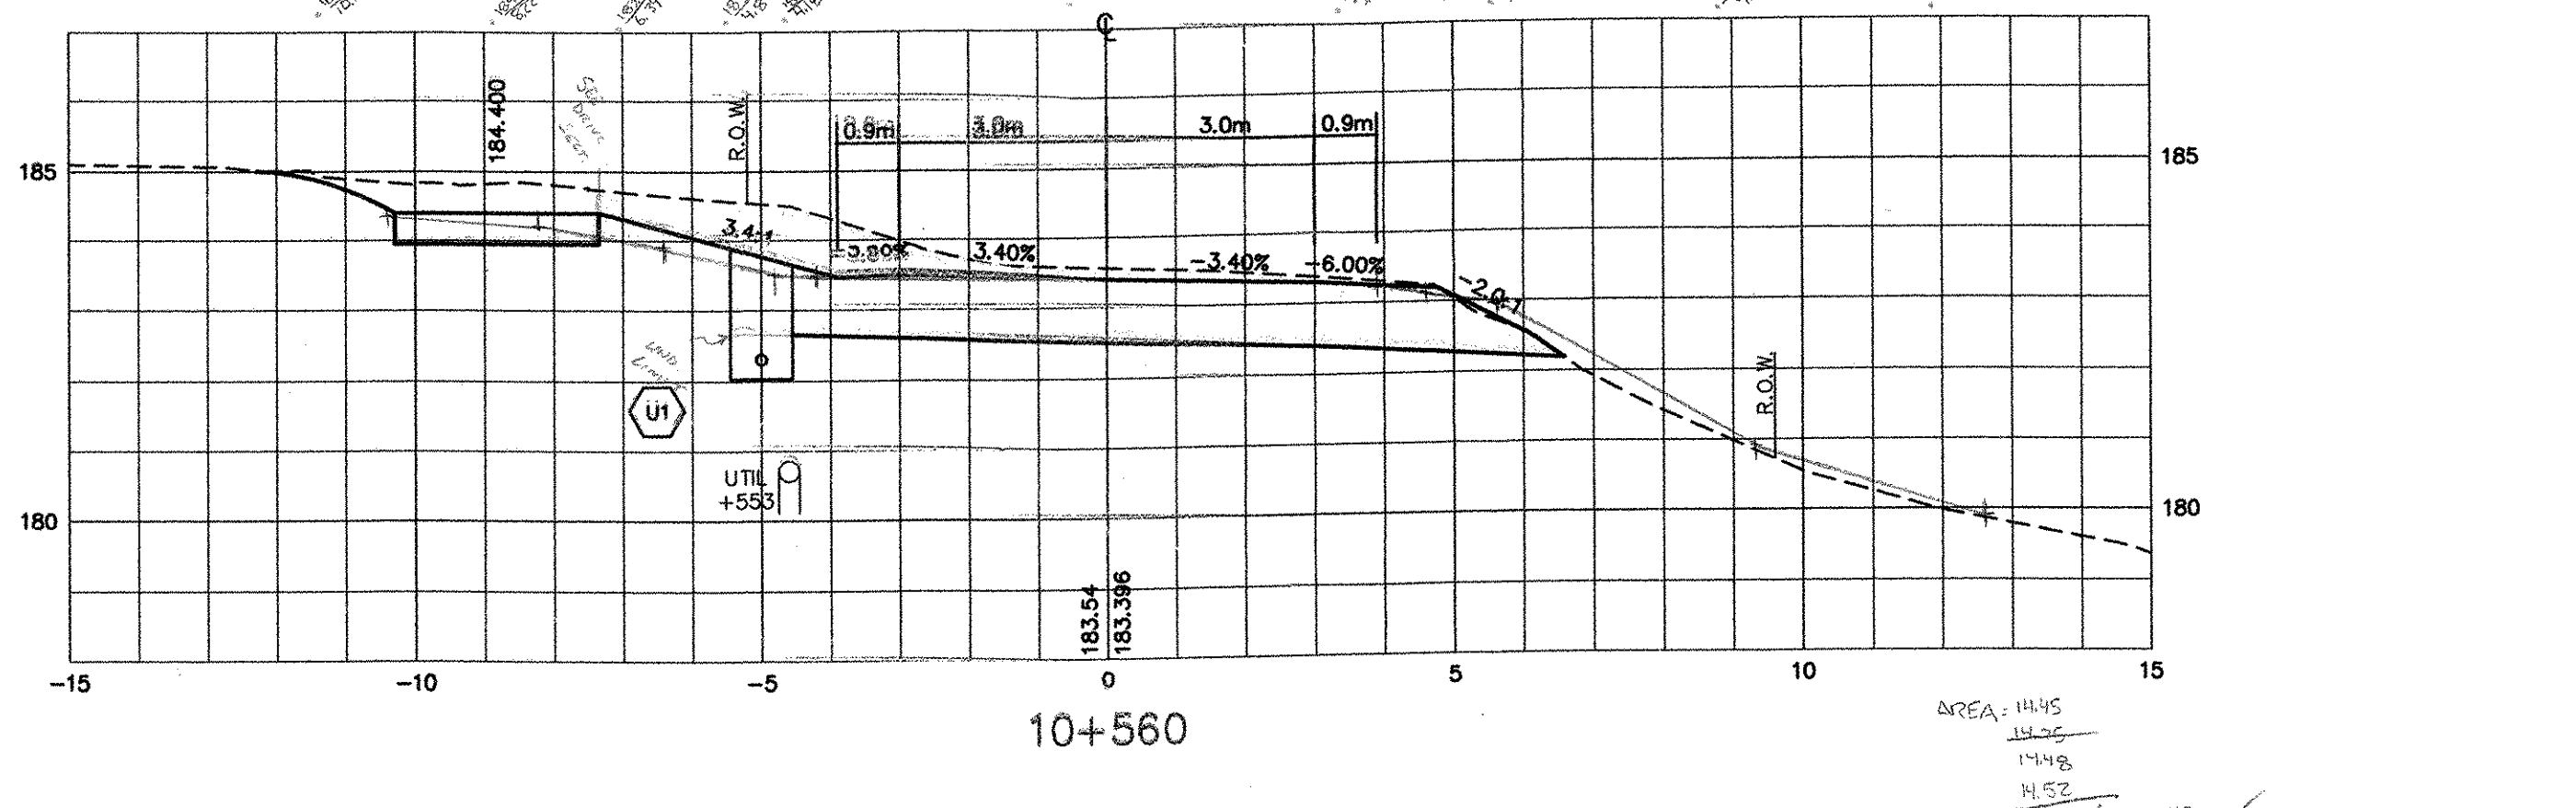
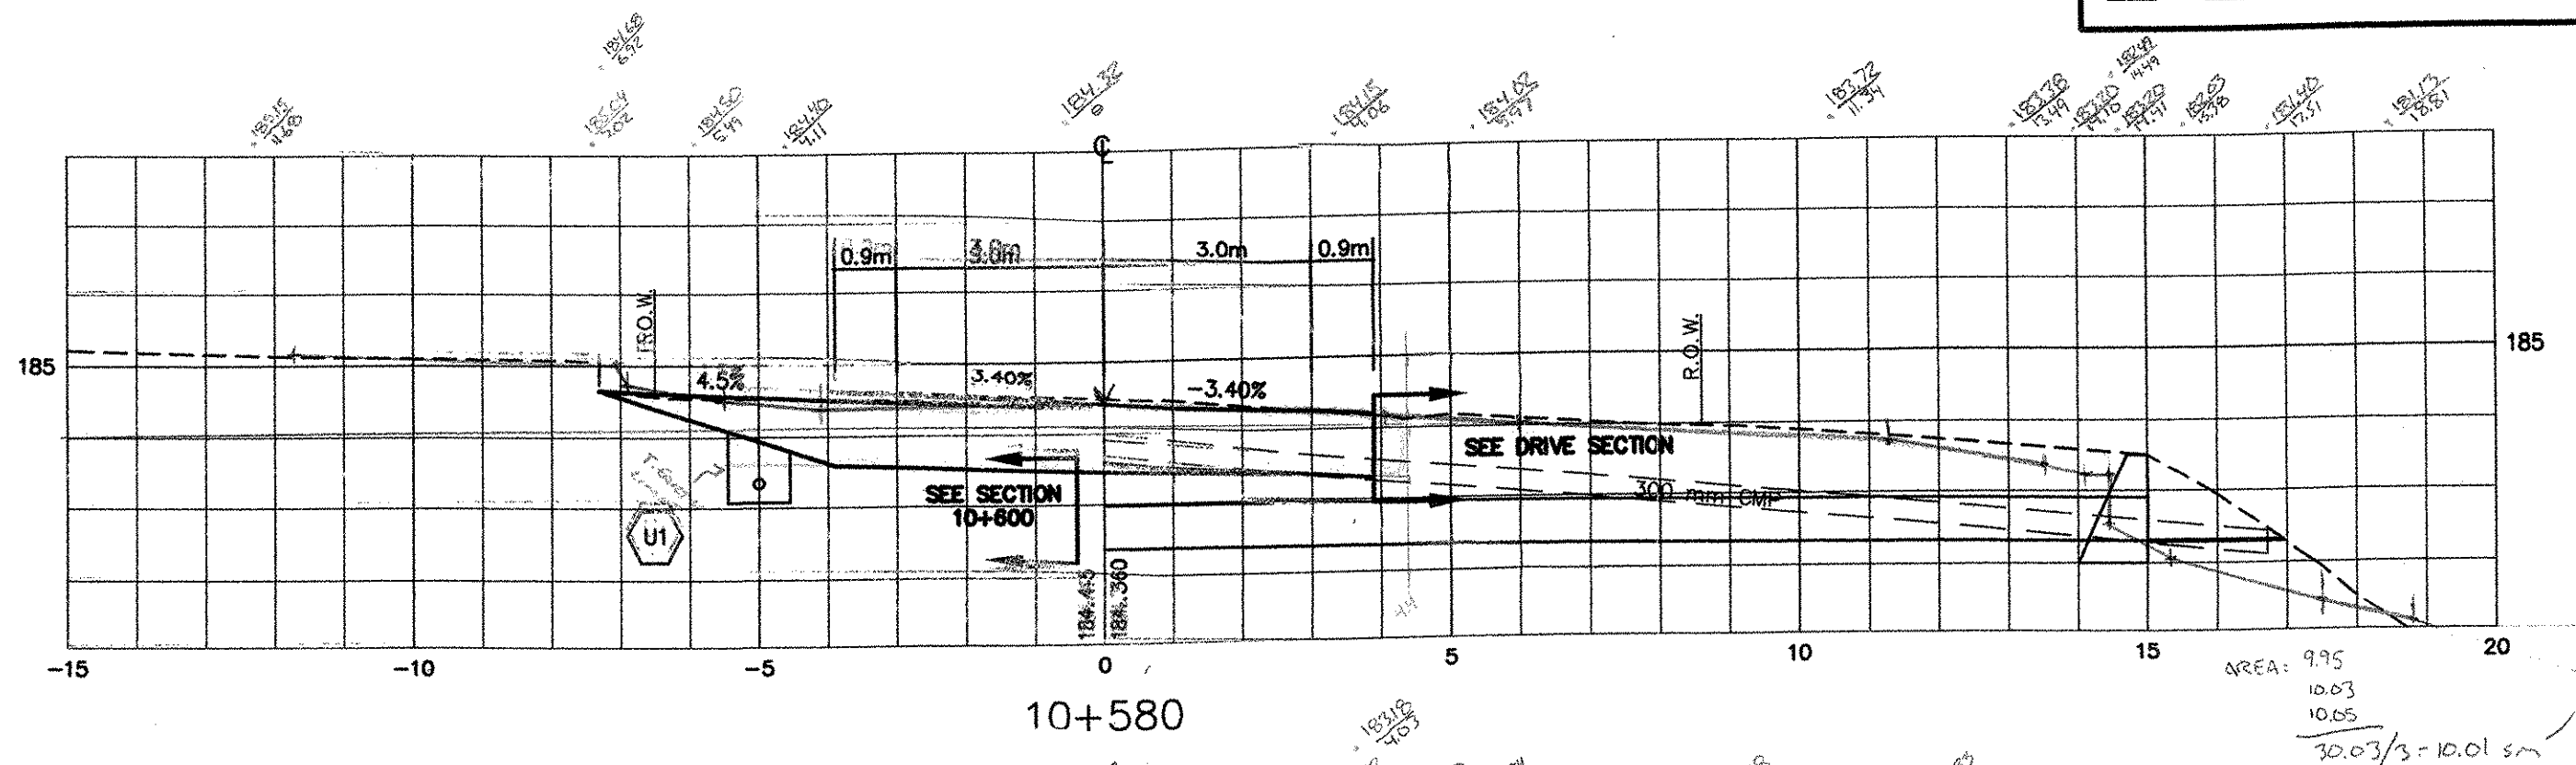
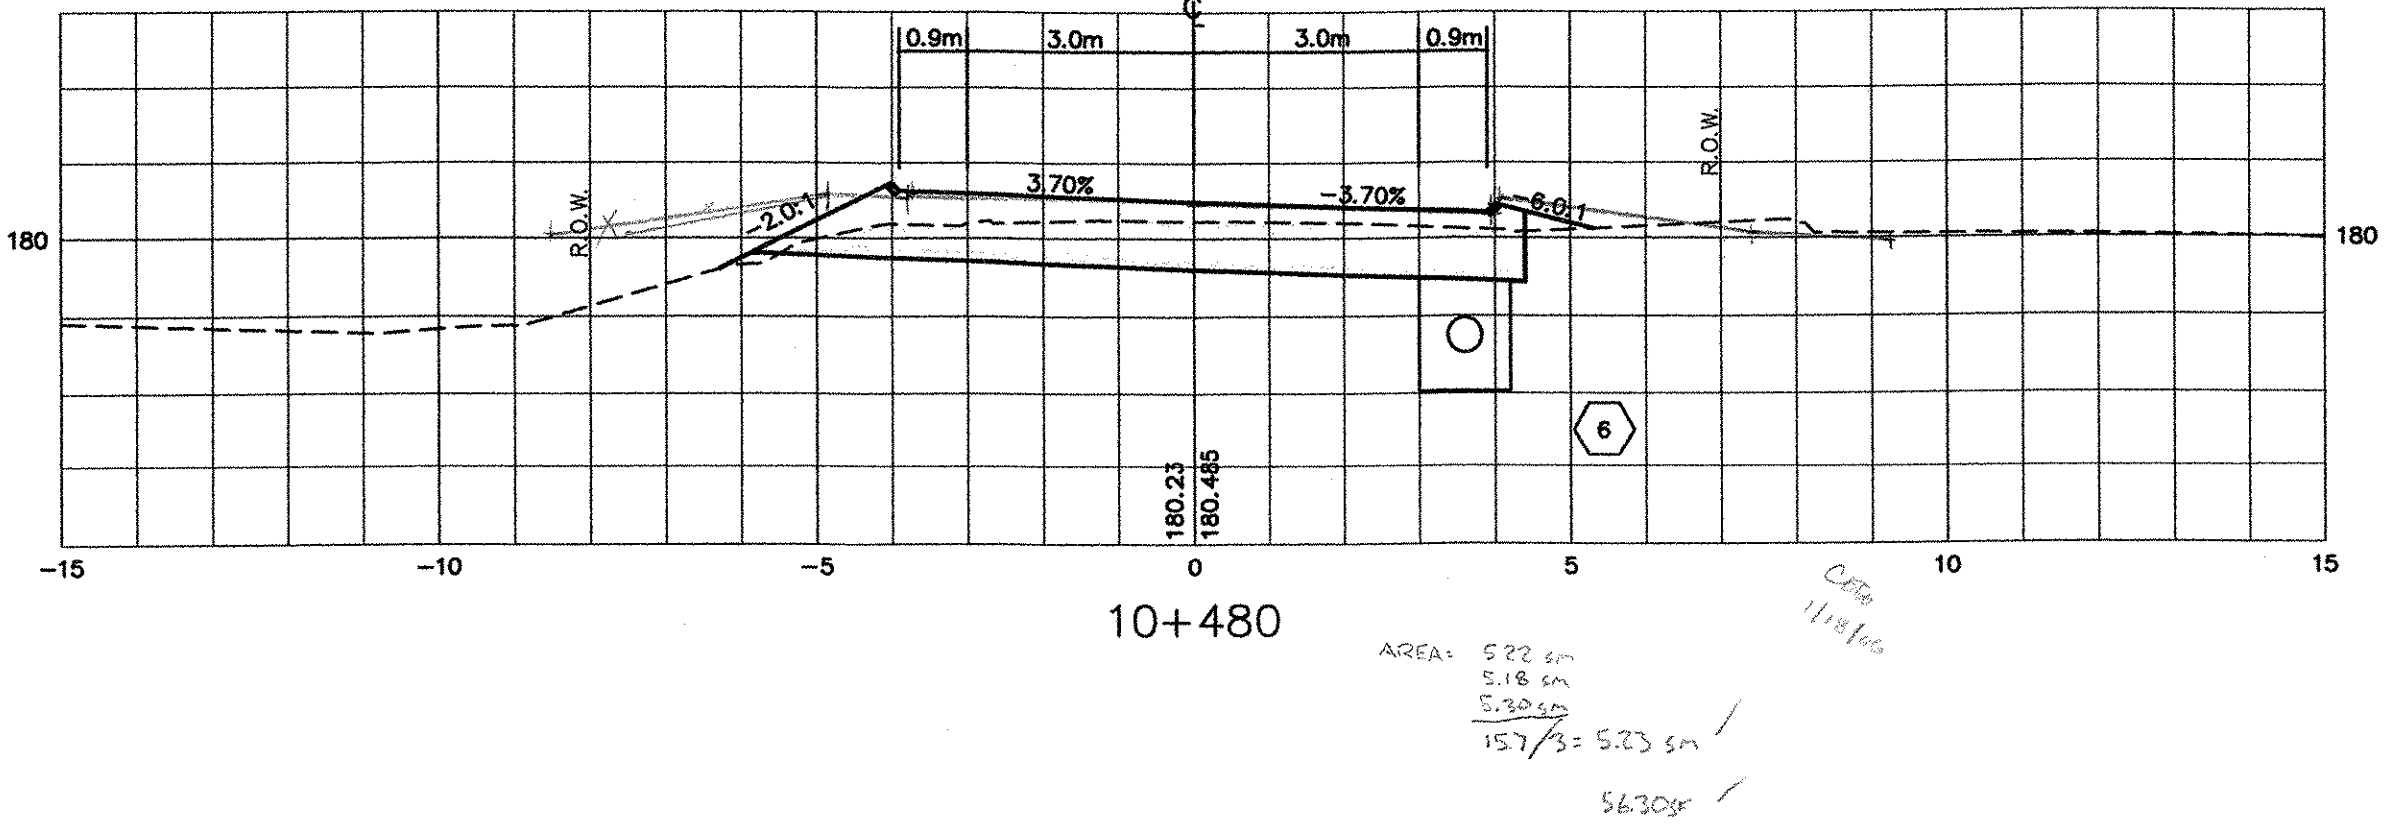
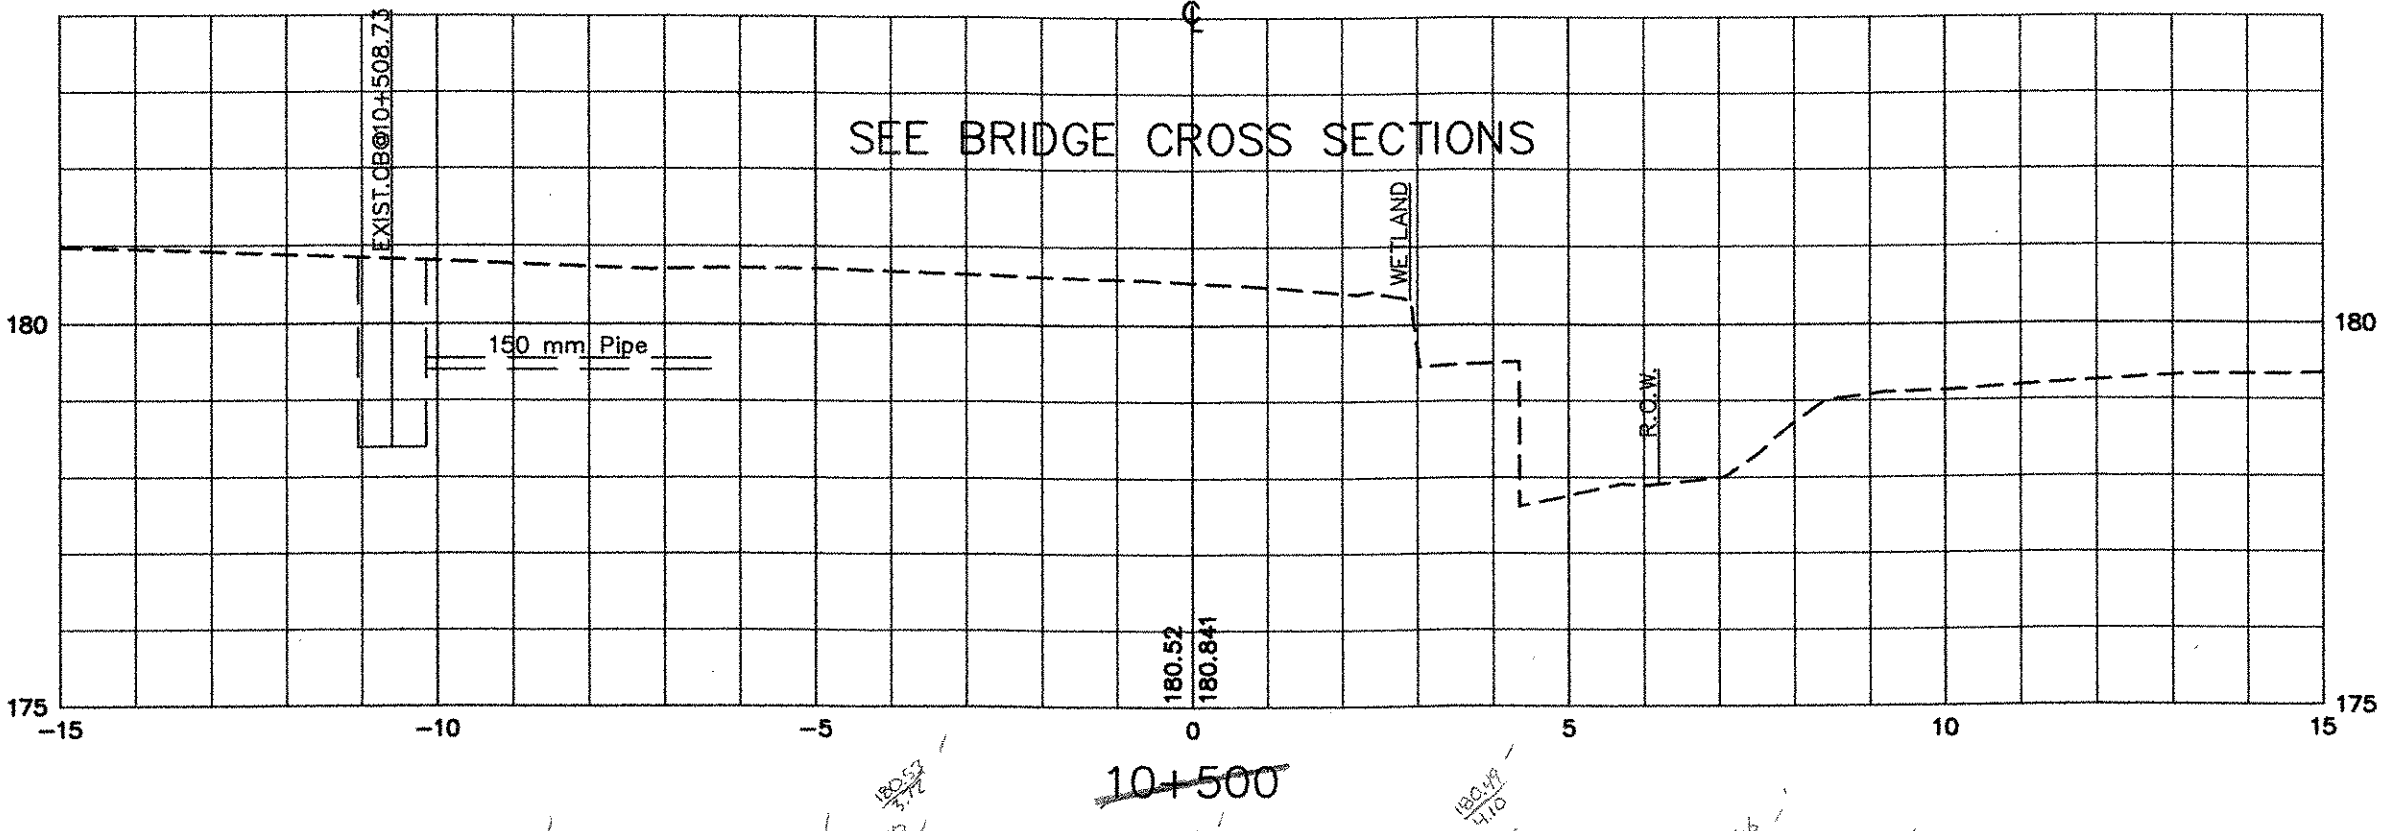
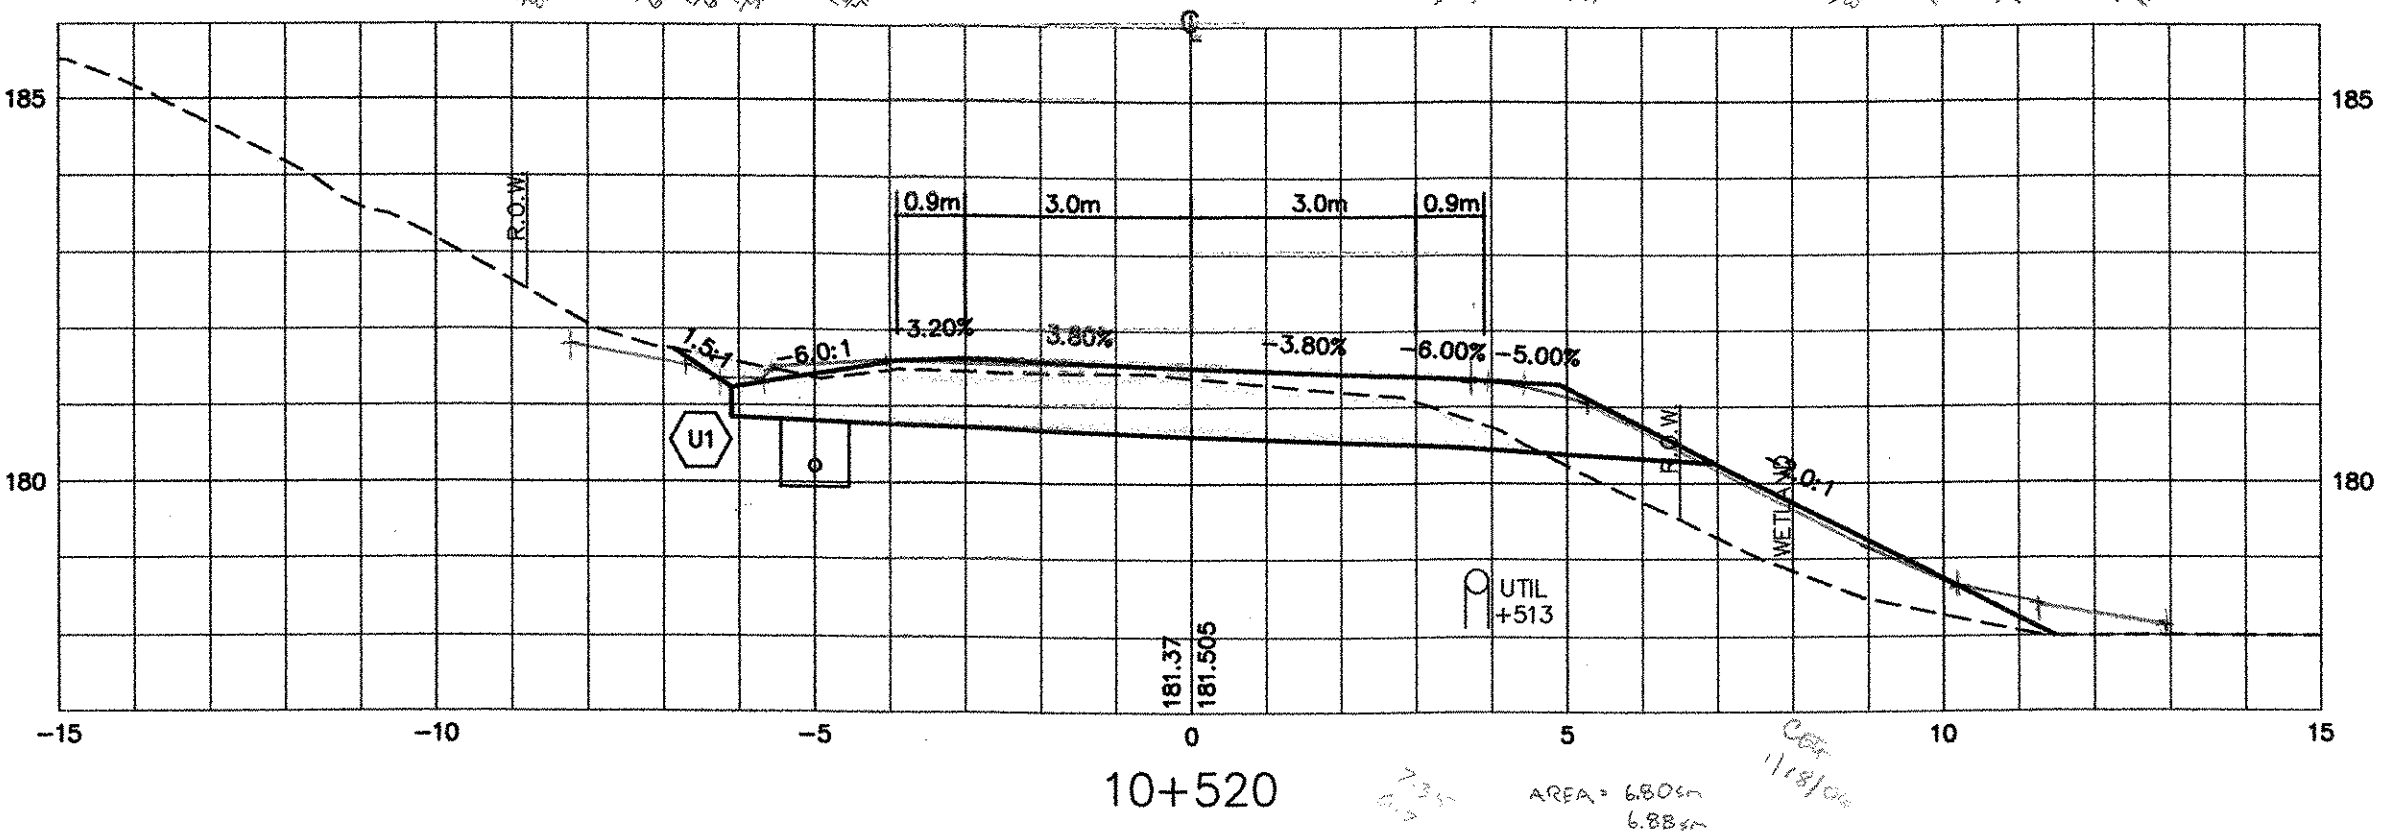


STA. 10+525 5.95 LT  
BEGIN COFFERDAM  
EXCAVATION AND  
GRANULAR BACKFILL.

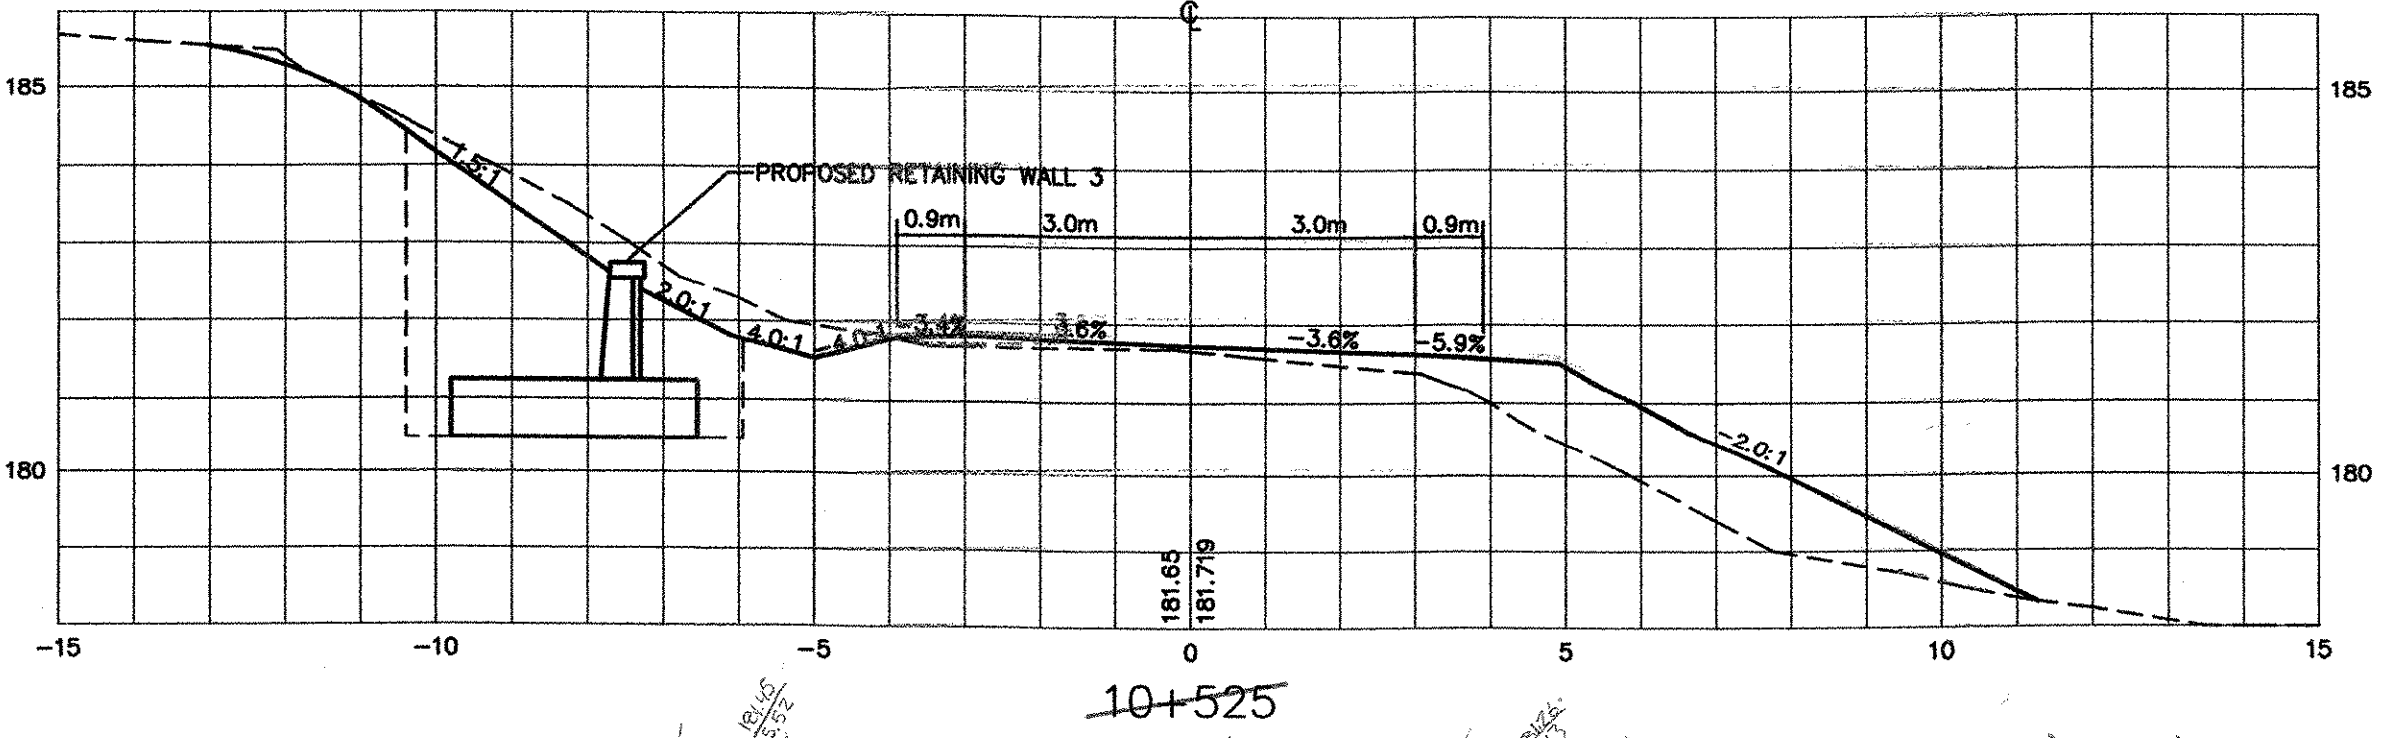

ROUTE 121 CROSS SECTIONS	
PROJECT: GRAFTON-ROCKINGHAM, ROUTE 121	PROJECT NO. : STP 0126(4)S
DESIGN FILE NAME: IPARM FILE NAME: SURVEYED BY: SQUAD LEADER:	PLOT DATE: 12/08/03 SURVEY DATE: DRAWN BY: SHEET: 62 OF 116

DATUM  
VERTICAL NGVD 1929  
HORIZONTAL NAD 1927

V:/1261/CADD/PLANS/SECTIONS-FINAL-ROUTE121-C2A.DWG

THE LOUIS BERGER GROUP, INC.