


DATUM  
 VERTICAL NGVD 1929  
 HORIZONTAL NAD 1927

V: /1261/CADD/PLANS/SECTIONS-FINAL-ROUTE121-C2A.DWG

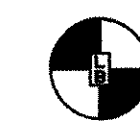

THE LOUIS BERGER GROUP, INC.

**ROUTE 121 CROSS SECTIONS**

PROJECT: GRAFTON-ROCKINGHAM, ROUTE 121	PROJECT NO. : STP 0126(4)S
DESIGN FILE NAME: IPARM FILE NAME: SURVEYED BY: SQUAD LEADER:	PLOT DATE: 12/08/03 SURVEY DATE: DRAWN BY: SHEET: 68 OF 116

*Handwritten note:* 1' of 2' slope

*Handwritten signature:* J.T. 2/12/04