


AREA: 15.79
15.85
15.82
42.49/3 = 15.83

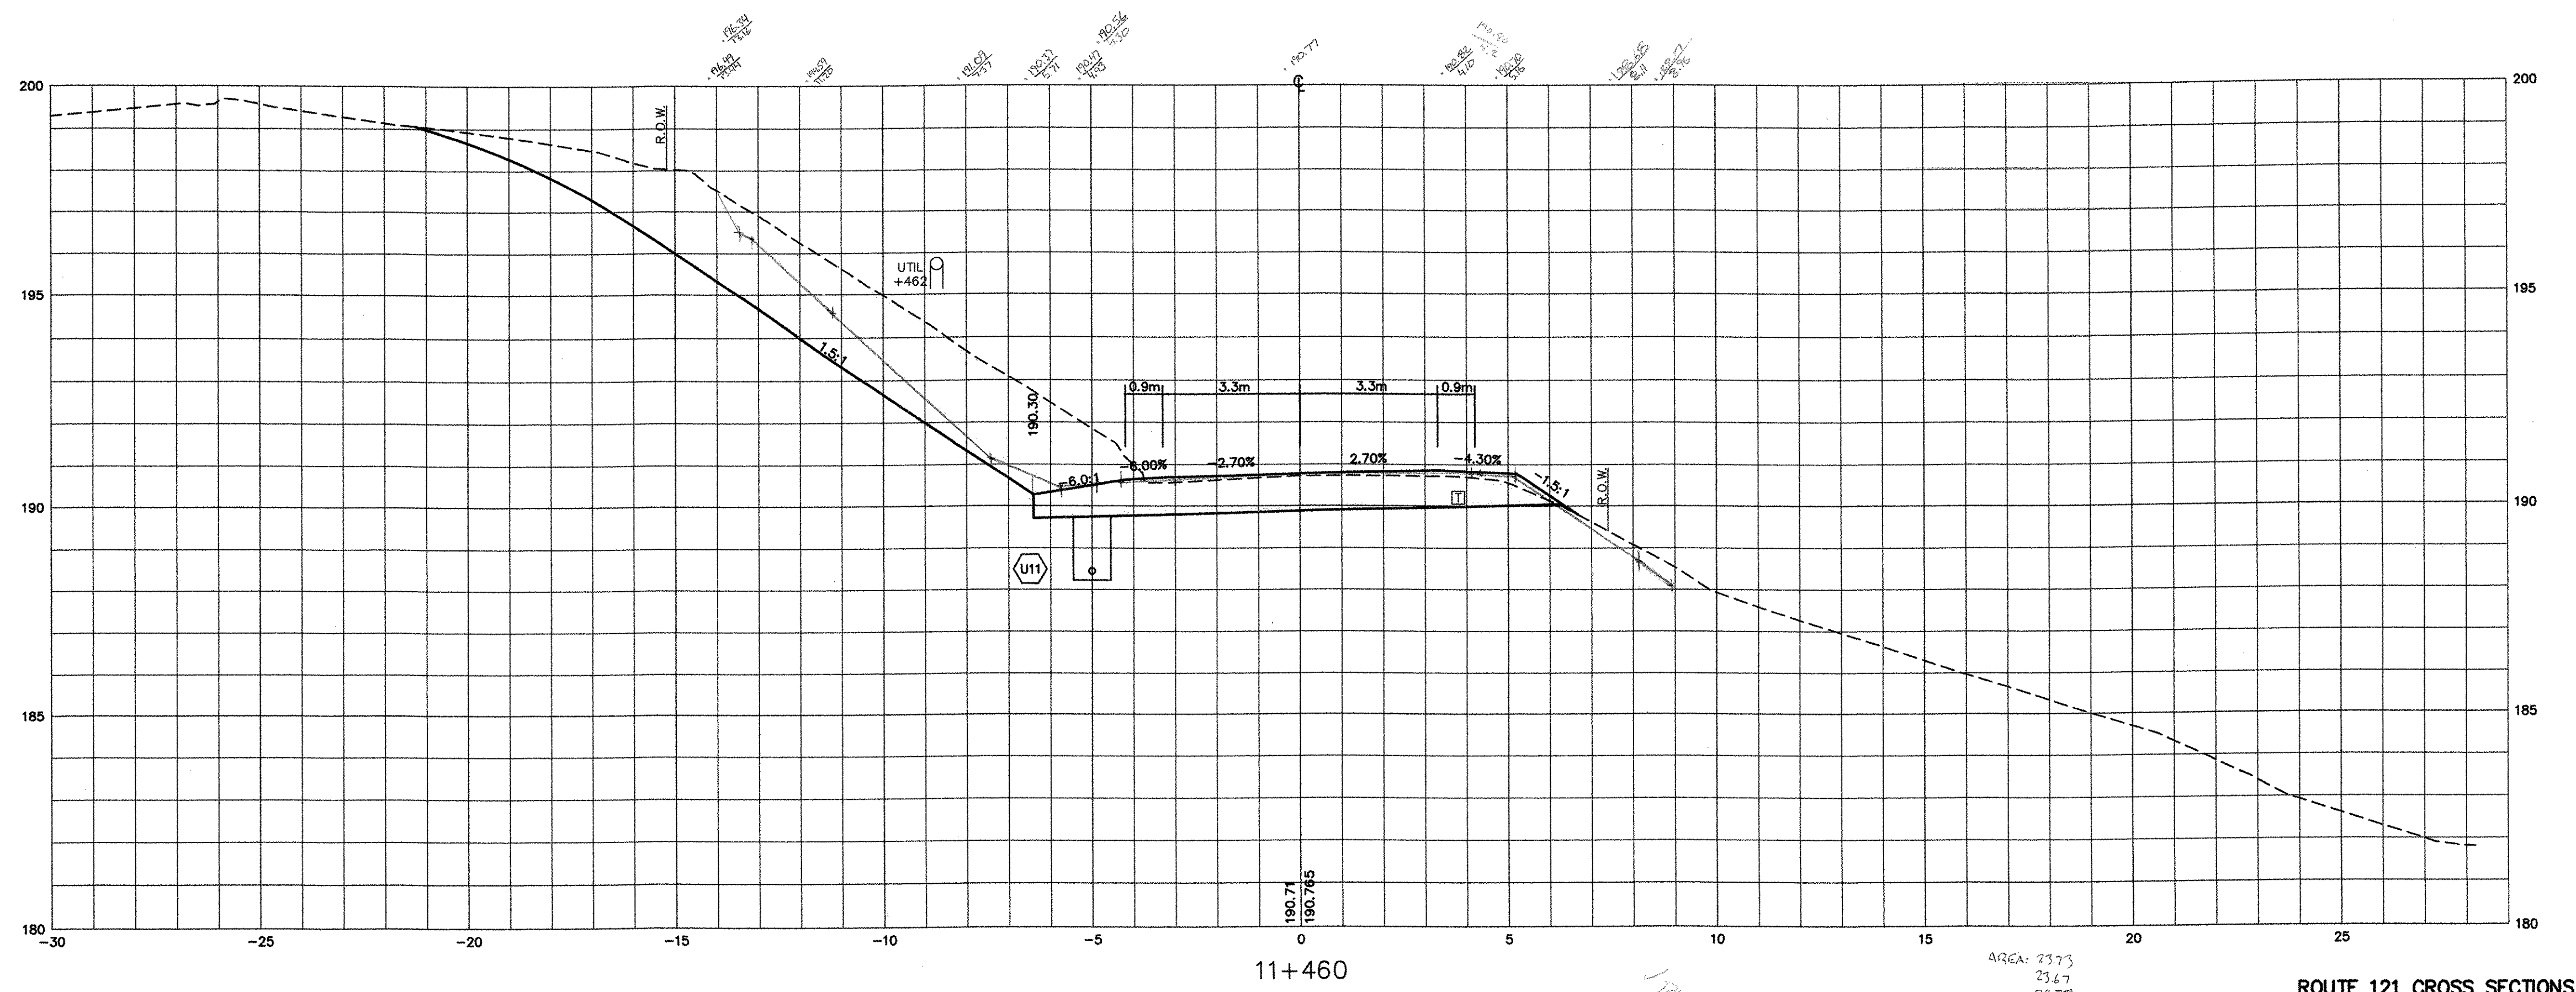

AREA: 23.73
23.67
23.72
71.12/3 = 23.71

0.00
2/23/04

DATUM
VERTICAL NGVD 1929
HORIZONTAL NAD 1927

V: /1261/CADD/PLANS/SECTIONS-FINAL-ROUTE121-C2B.DWG

THE LOUIS BERGER GROUP, INC.

ROUTE 121 CROSS SECTIONS	
PROJECT: GRAFTON-ROCKINGHAM, ROUTE 121	PROJECT NO. : STP 0126(4)S
DESIGN FILE NAME: IPARM FILE NAME: SURVEYED BY: SQUAD LEADER:	PLOT DATE: 12/08/03 SURVEY DATE: DRAWN BY: SHEET: 72 OF 116