


AREA = 18.57
 18.56
 18.60
 $55.75/3 = 18.58 \text{ m}$

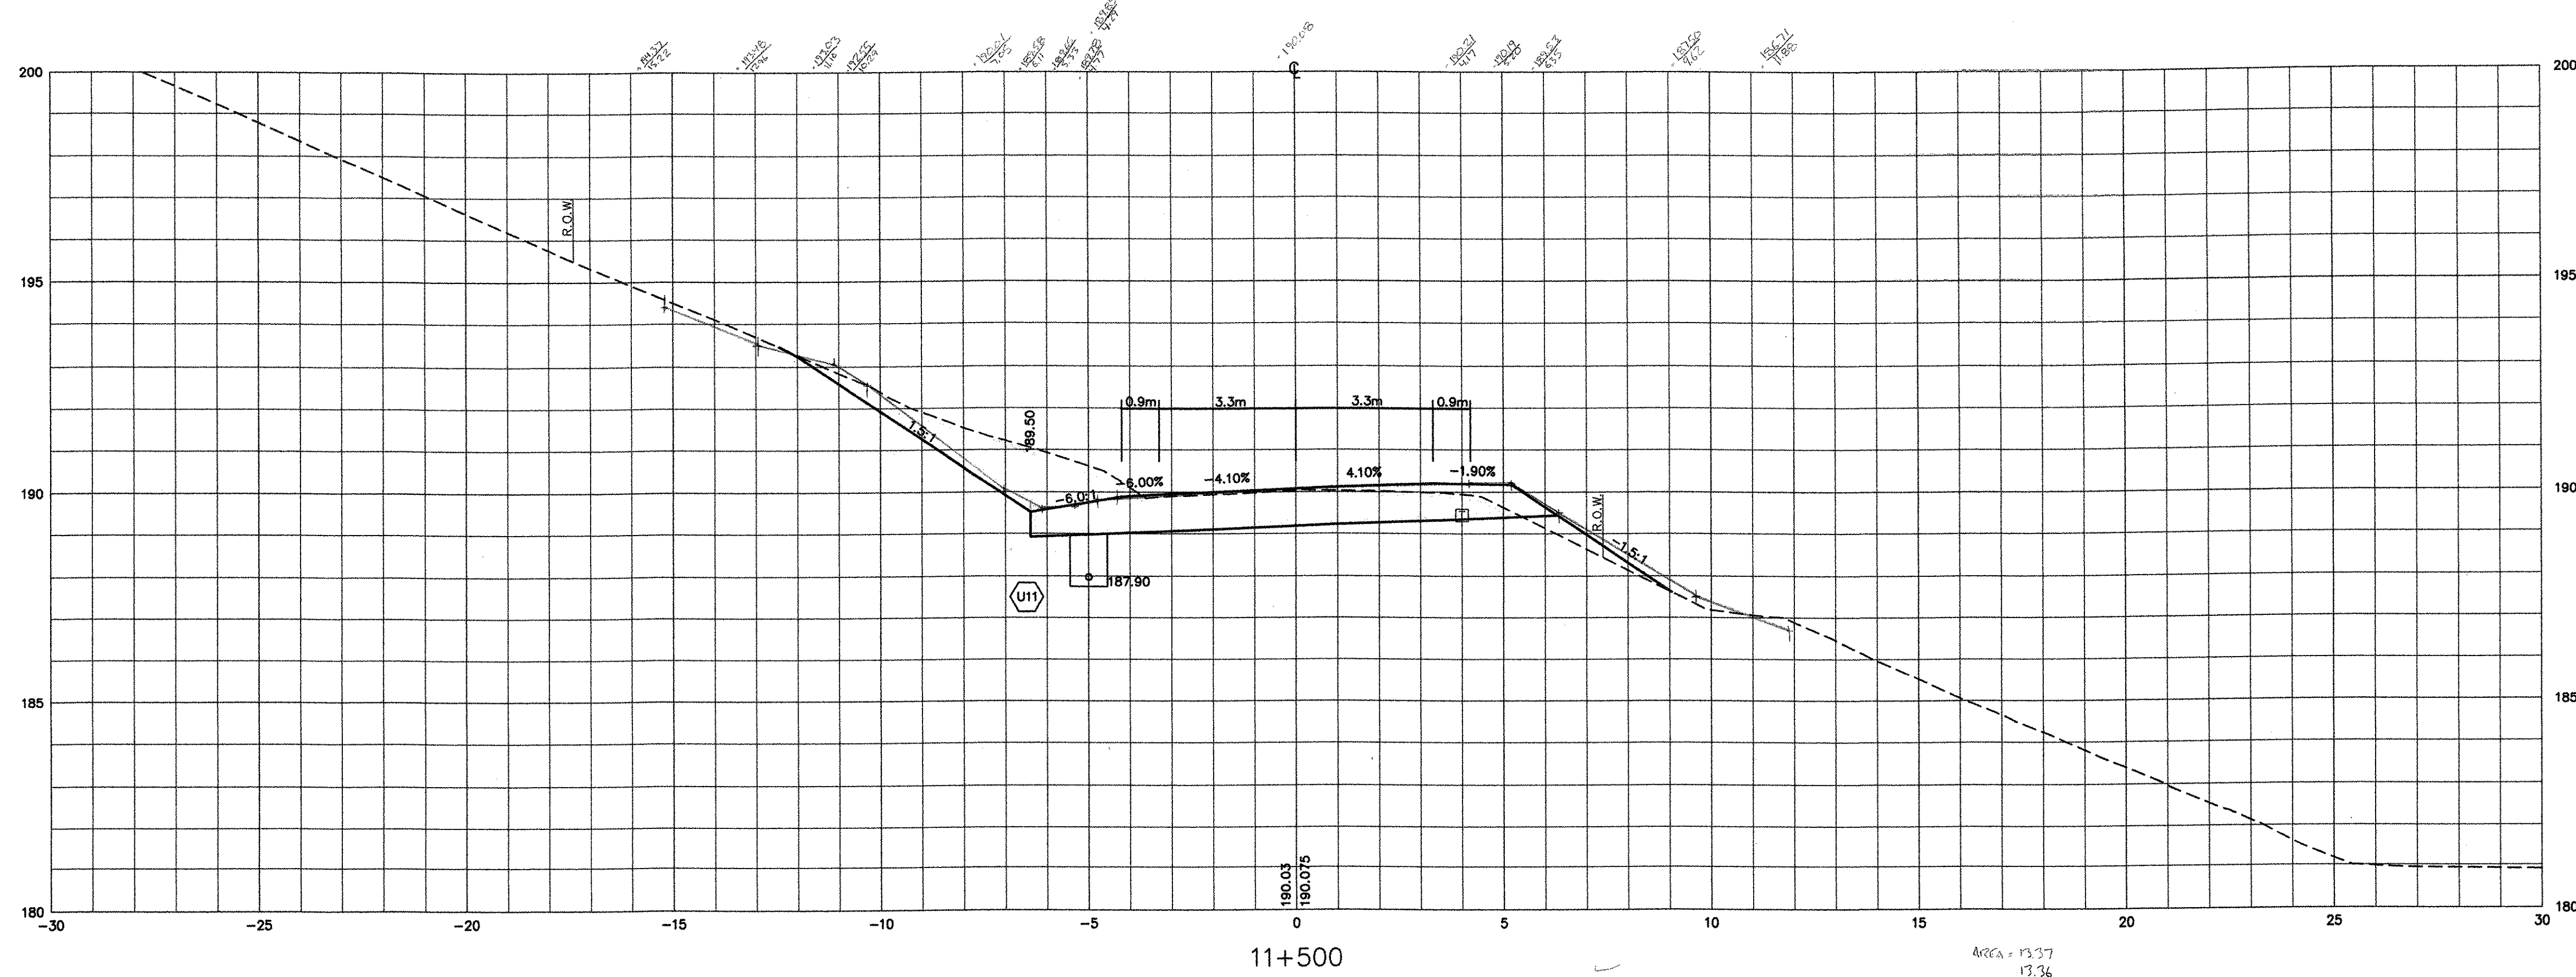

AREA = 13.37
 13.36
 13.42
 $40.15/3 = 13.38 \text{ m}$

Handwritten: Ved
 C&G
 2/12/100

DATUM	
VERTICAL	NGVD 1929
HORIZONTAL	NAD 1927

V: /1261/CADD/PLANS/SECTIONS-FINAL-ROUTE121-C2B.DWG

THE LOUIS BERGER GROUP, INC.

ROUTE 121 CROSS SECTIONS	
PROJECT: GRAFTON-ROCKINGHAM, ROUTE 121	PROJECT NO. : STP 0126(4)S
DESIGN FILE NAME: IPARM FILE NAME: SURVEYED BY: SQUAD LEADER:	PLOT DATE: 12/08/03 SURVEY DATE: DRAWN BY: SHEET: 73 OF 116