


12+380

AREA = 410
413
415
 $12.38/3 = 413.2$

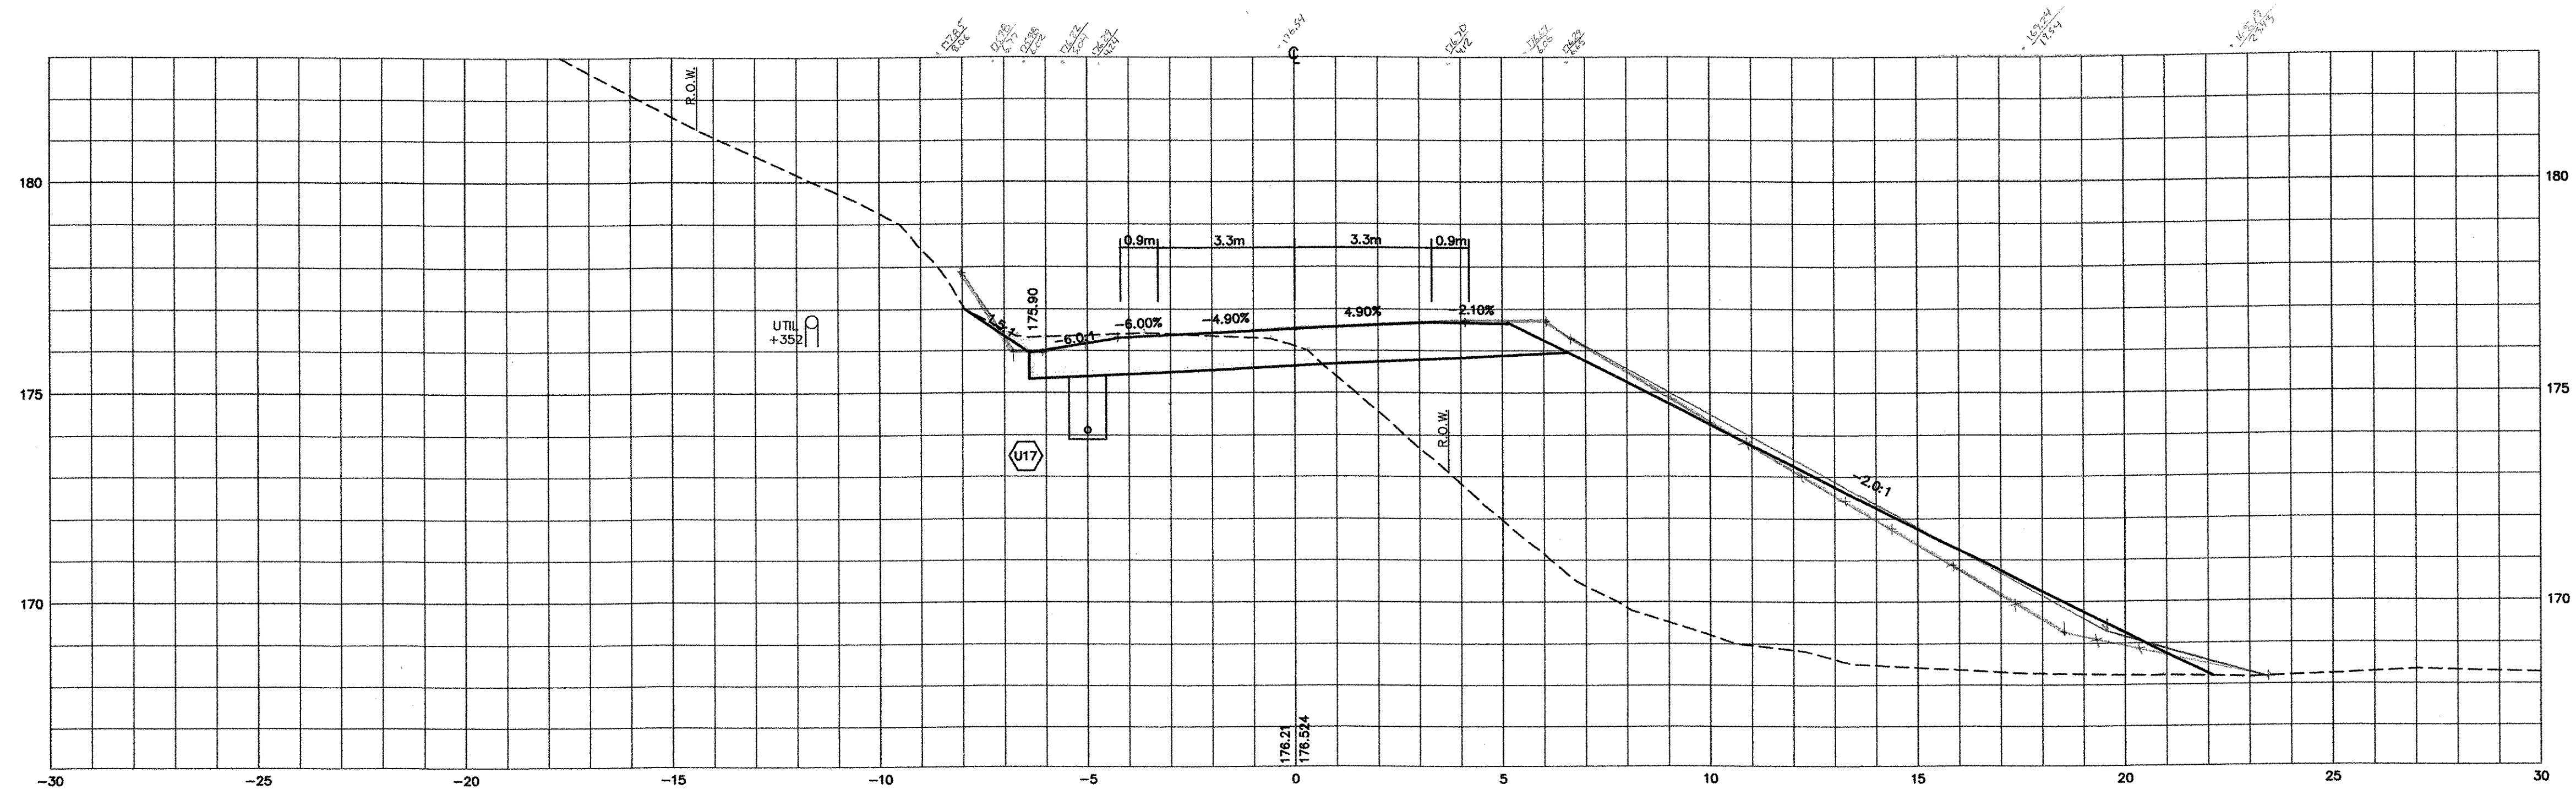

12+360

AREA = 596
600
594
 $12.36/3 = 597.2$

Plot
12/08/03
12:11:00

DATUM	
VERTICAL	NGVD 1929
HORIZONTAL	NAD 1927

V: /1261/CADD/PLANS/SECTIONS-FINAL-ROUTE121-C2C.DWG



THE LOUIS BERGER GROUP, INC.

ROUTE 121 CROSS SECTIONS

PROJECT: GRAFTON-ROCKINGHAM, ROUTE 121	PROJECT NO. : STP 0126(4)S
DESIGN FILE NAME: IPARM FILE NAME: SURVEYED BY: SQUAD LEADER:	PLOT DATE: 12/08/03 SURVEY DATE: DRAWN BY: SHEET: 90 OF 116