


AREA = 1.49
1.49
1.51
4.49/3 = 1.50m

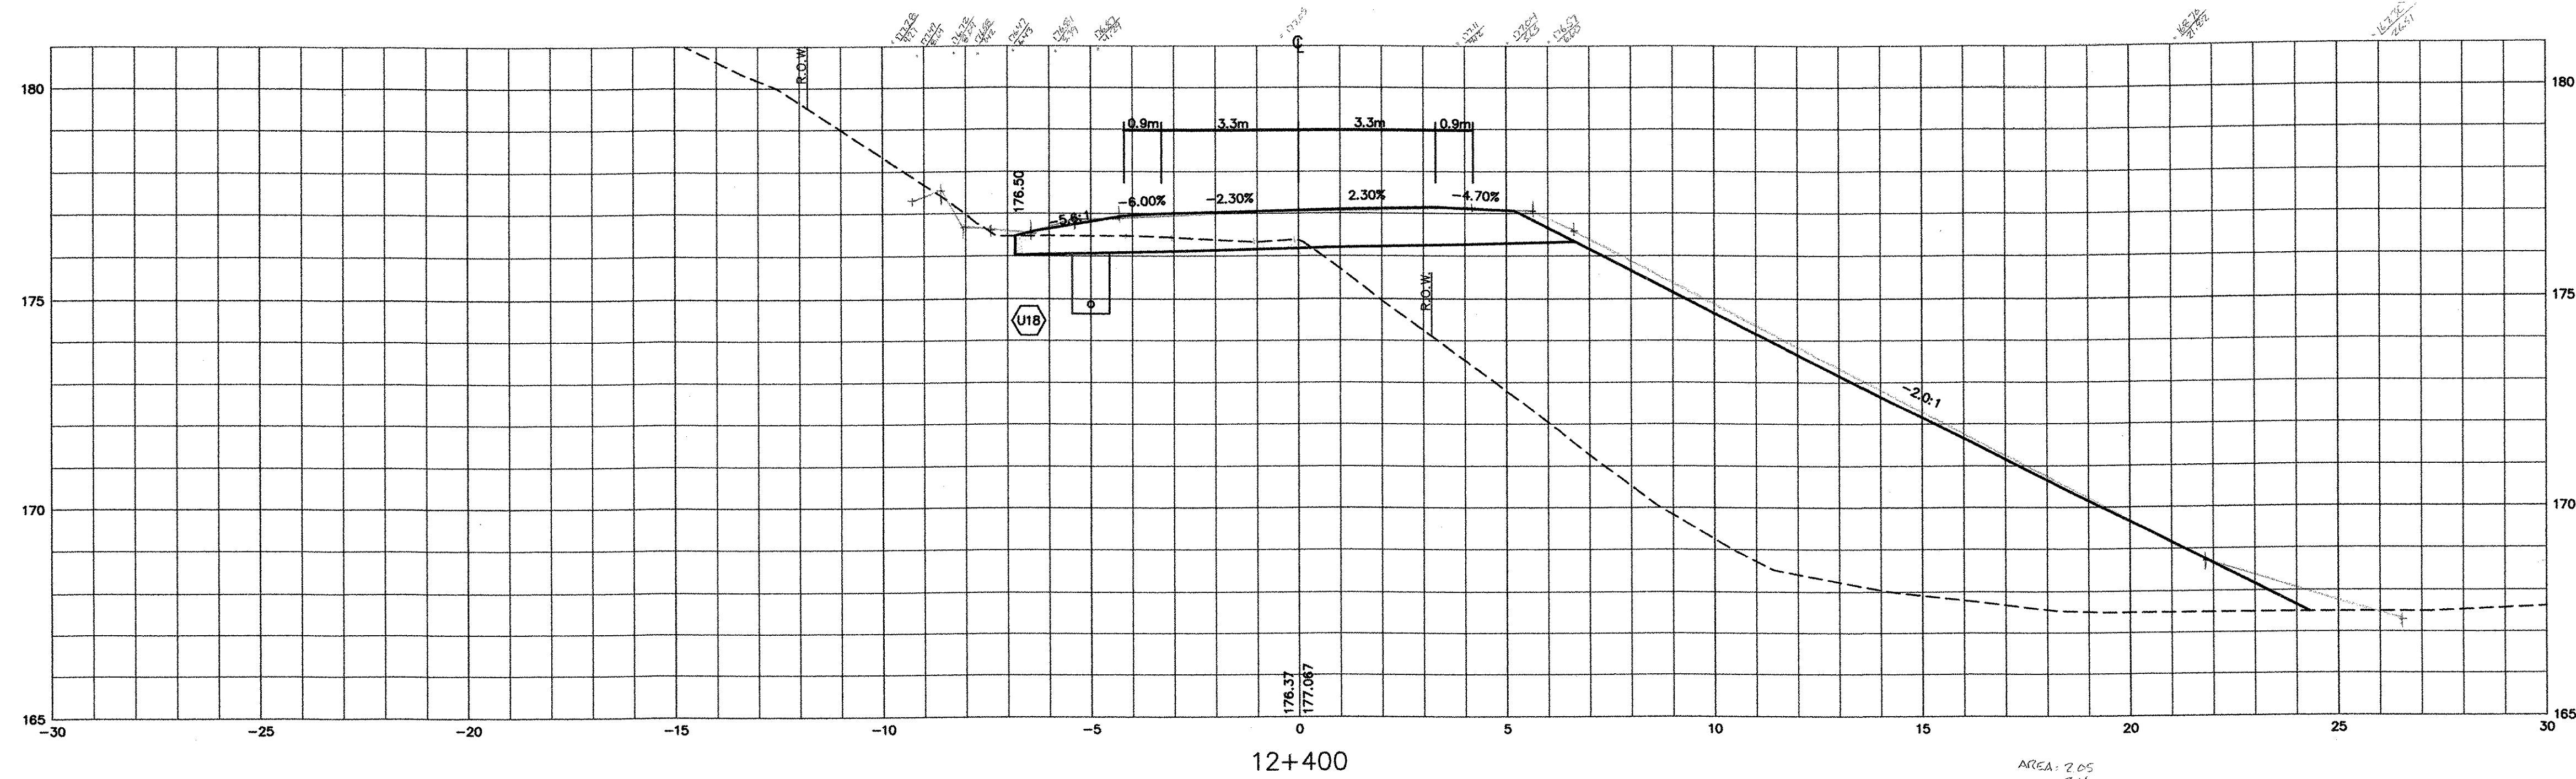

AREA = 2.05
2.16
2.07
2.20/3 = 2.09m

Handwritten notes and signatures:
J. P. ...
C. ...
2/21/06

DATUM
VERTICAL NGVD 1929
HORIZONTAL NAD 1927

V:/1261/CADD/PLANS/SECTIONS-FINAL-ROUTE121-C2C.DWG

THE LOUIS BERGER GROUP, INC.

ROUTE 121 CROSS SECTIONS	
PROJECT: GRAFTON-ROCKINGHAM, ROUTE 121	PROJECT NO. : STP 0126(4)S
DESIGN FILE NAME: IPARM FILE NAME: SURVEYED BY: SQUAD LEADER:	PLOT DATE: 12/08/03 SURVEY DATE: DRAWN BY: SHEET: 91 OF 116