


AREA: 14.51
14.50
49.7/3 = 14.57

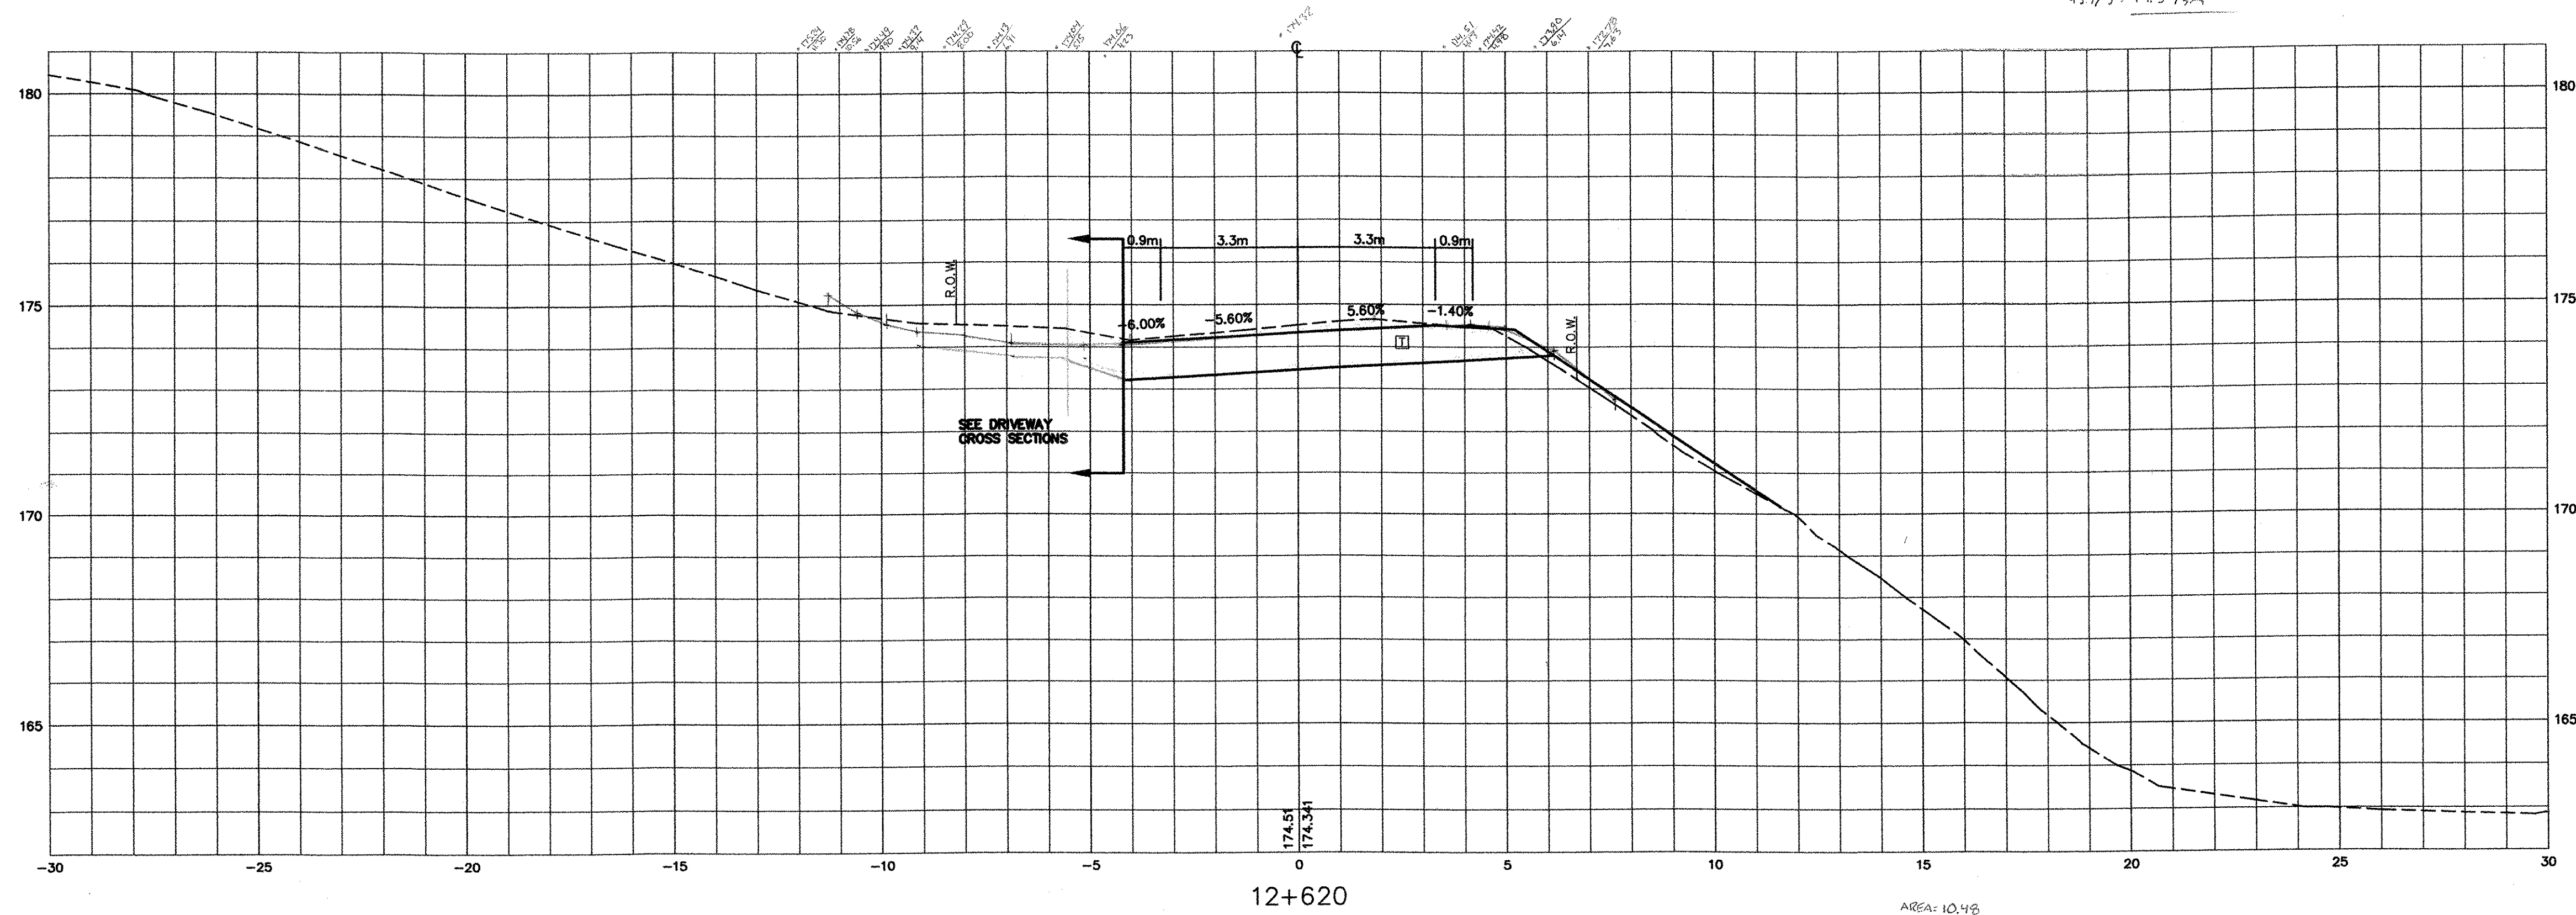

AREA: 10.46
10.35
10.51
31.34/3 = 10.45

1/2/03
2/21/03
2/21/03

OT 2/21/03

DATUM
VERTICAL NGVD 1929
HORIZONTAL NAD 1927

V: /1261/CADD/PLANS/SECTIONS-FINAL-ROUTE121-C2C.DWG



THE LOUIS BERGER GROUP, INC.

ROUTE 121 CROSS SECTIONS

| | |
|--|--|
| PROJECT: GRAFTON-ROCKINGHAM, ROUTE 121 | PROJECT NO. : STP 0126(4)S |
| DESIGN FILE NAME: IPARM FILE NAME: SURVEYED BY: SQUAD LEADER: | PLOT DATE: 12/08/03 SURVEY DATE: DRAWN BY: SHEET: 97 OF 116 |