
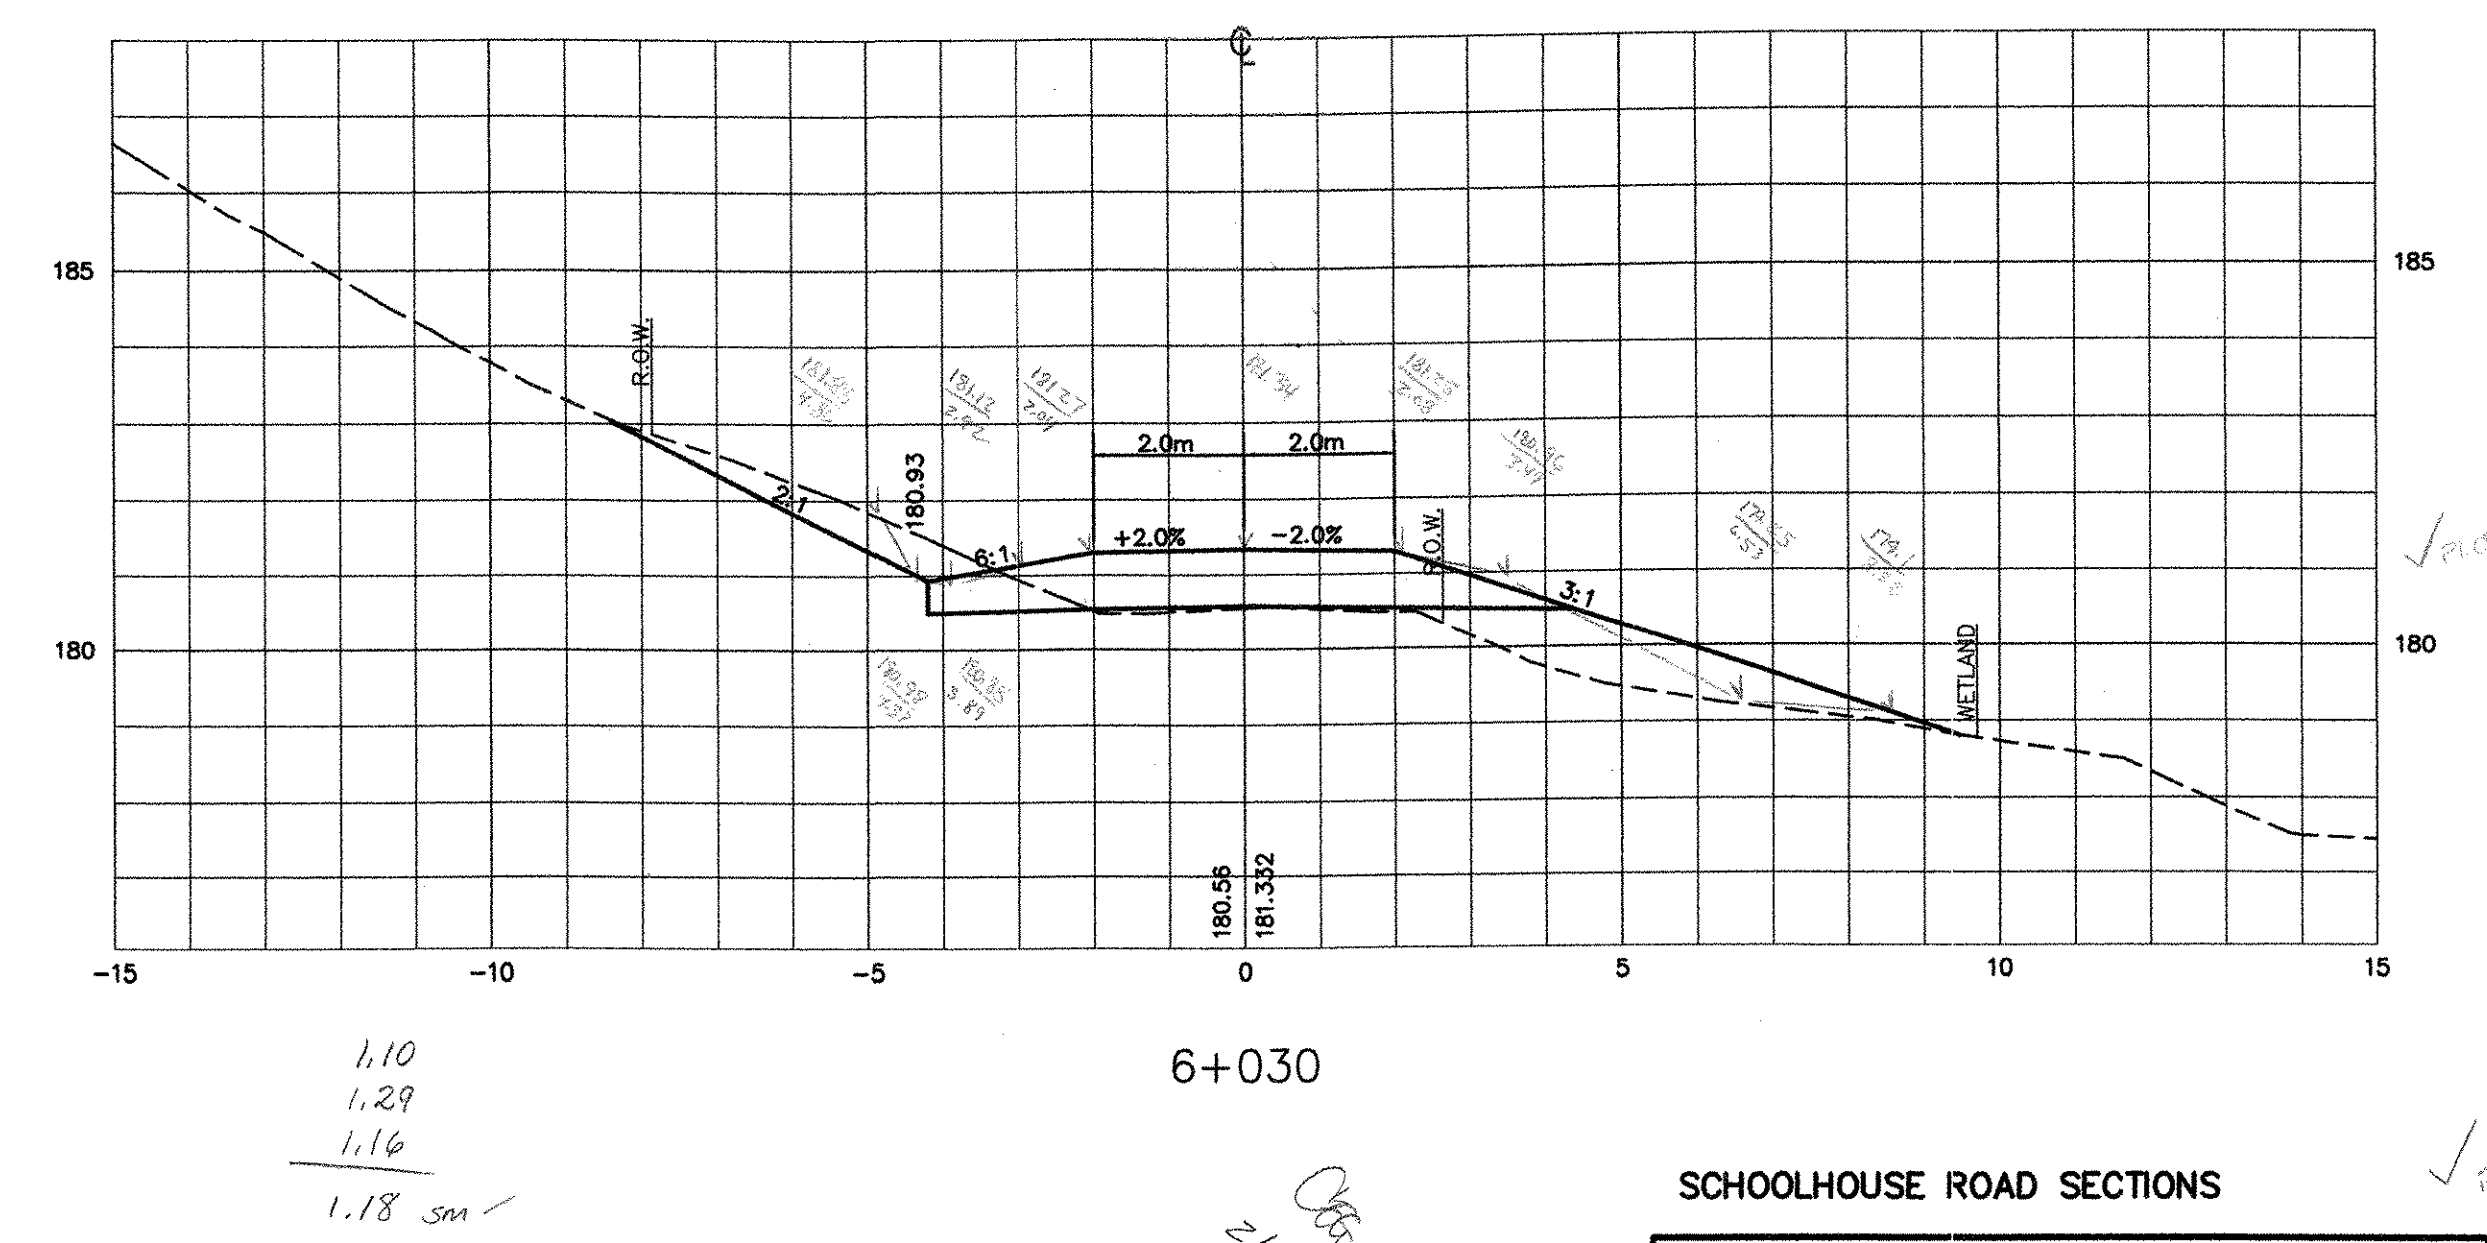
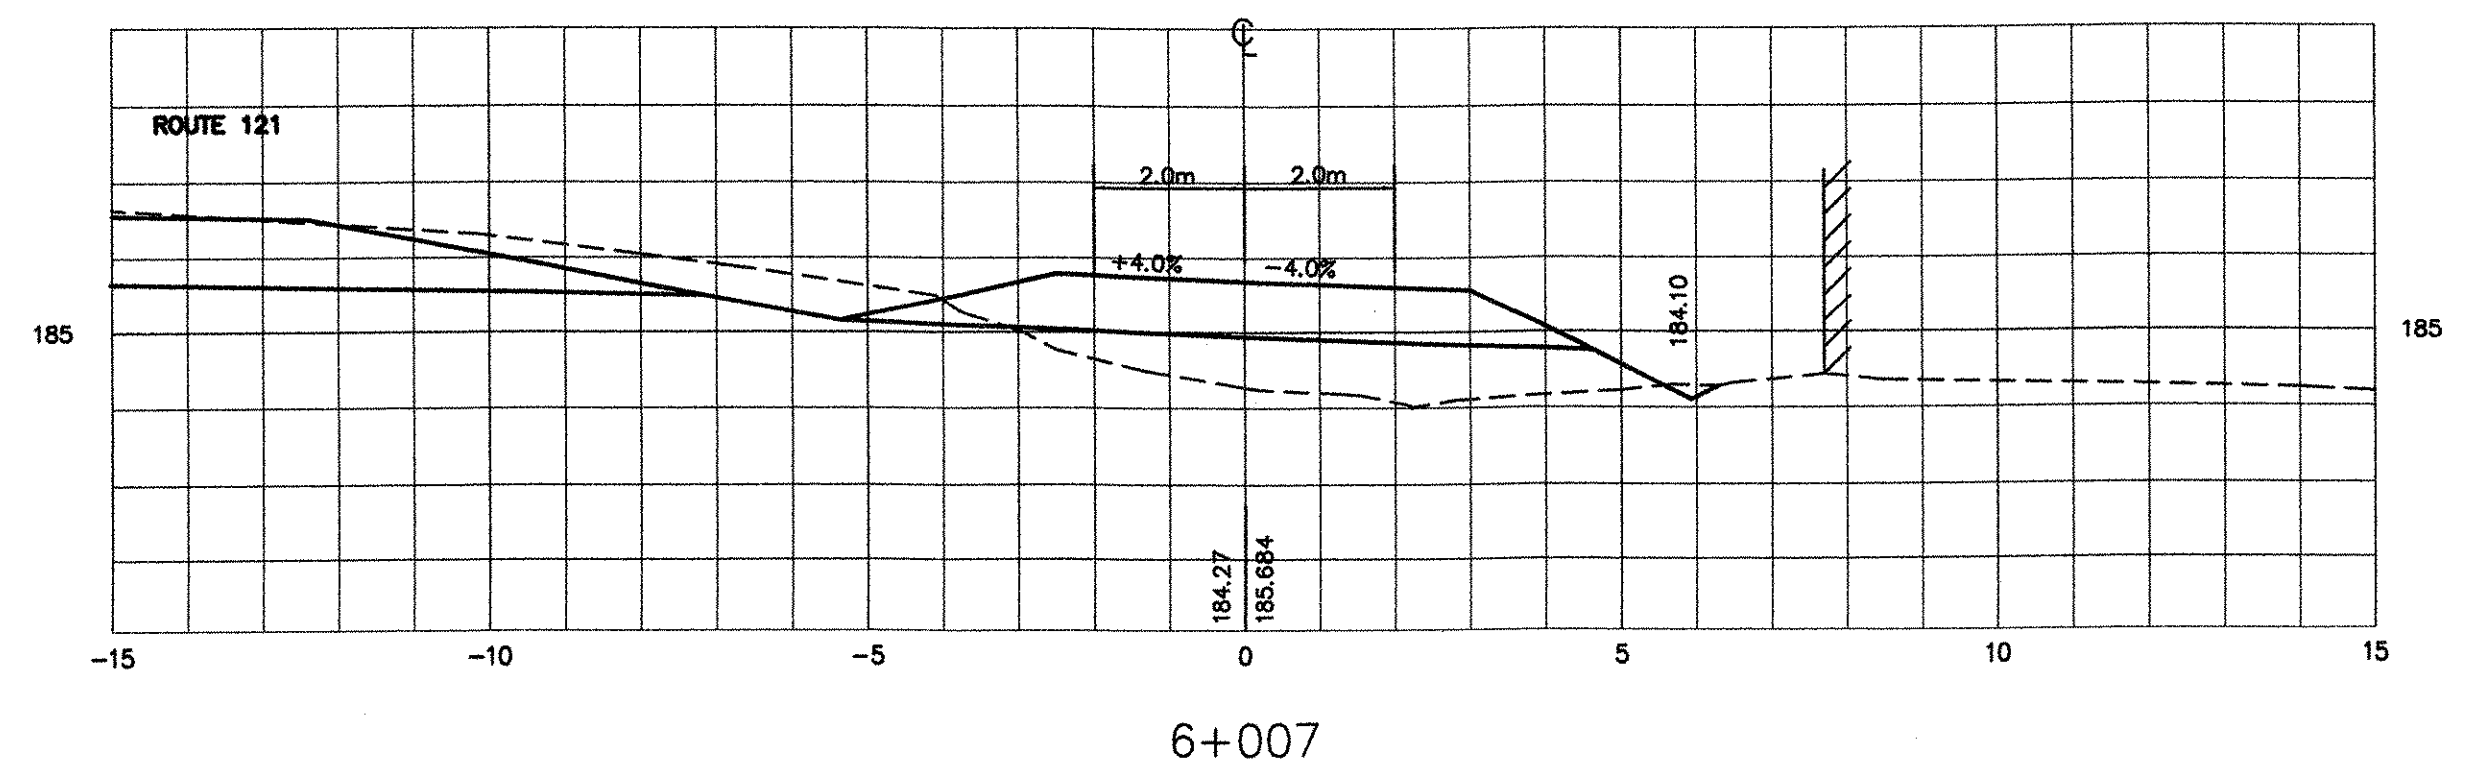
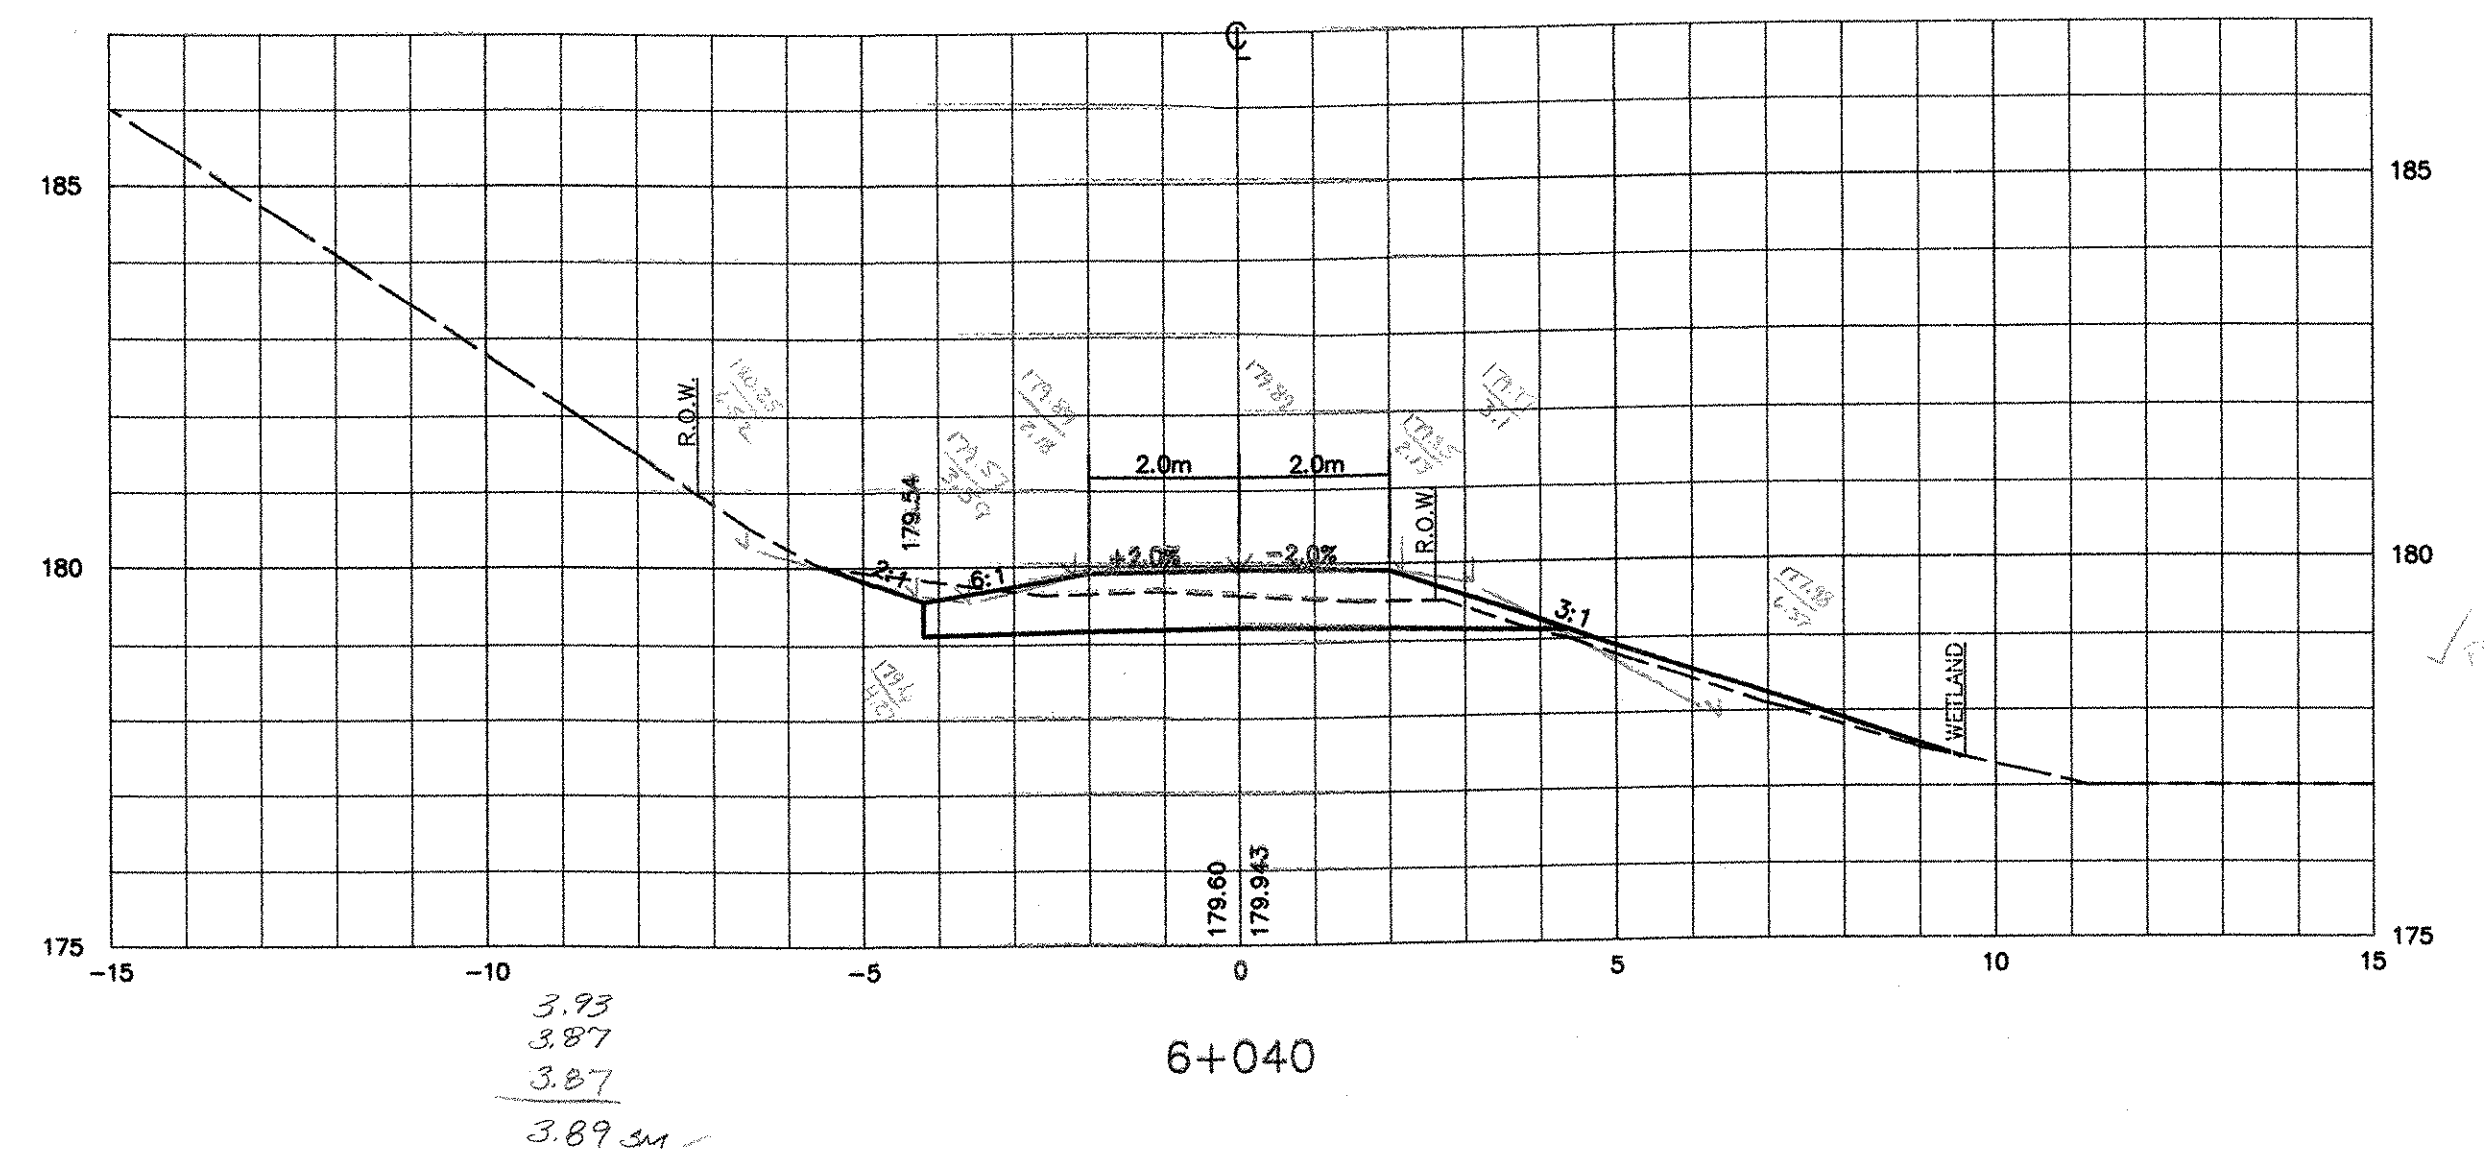
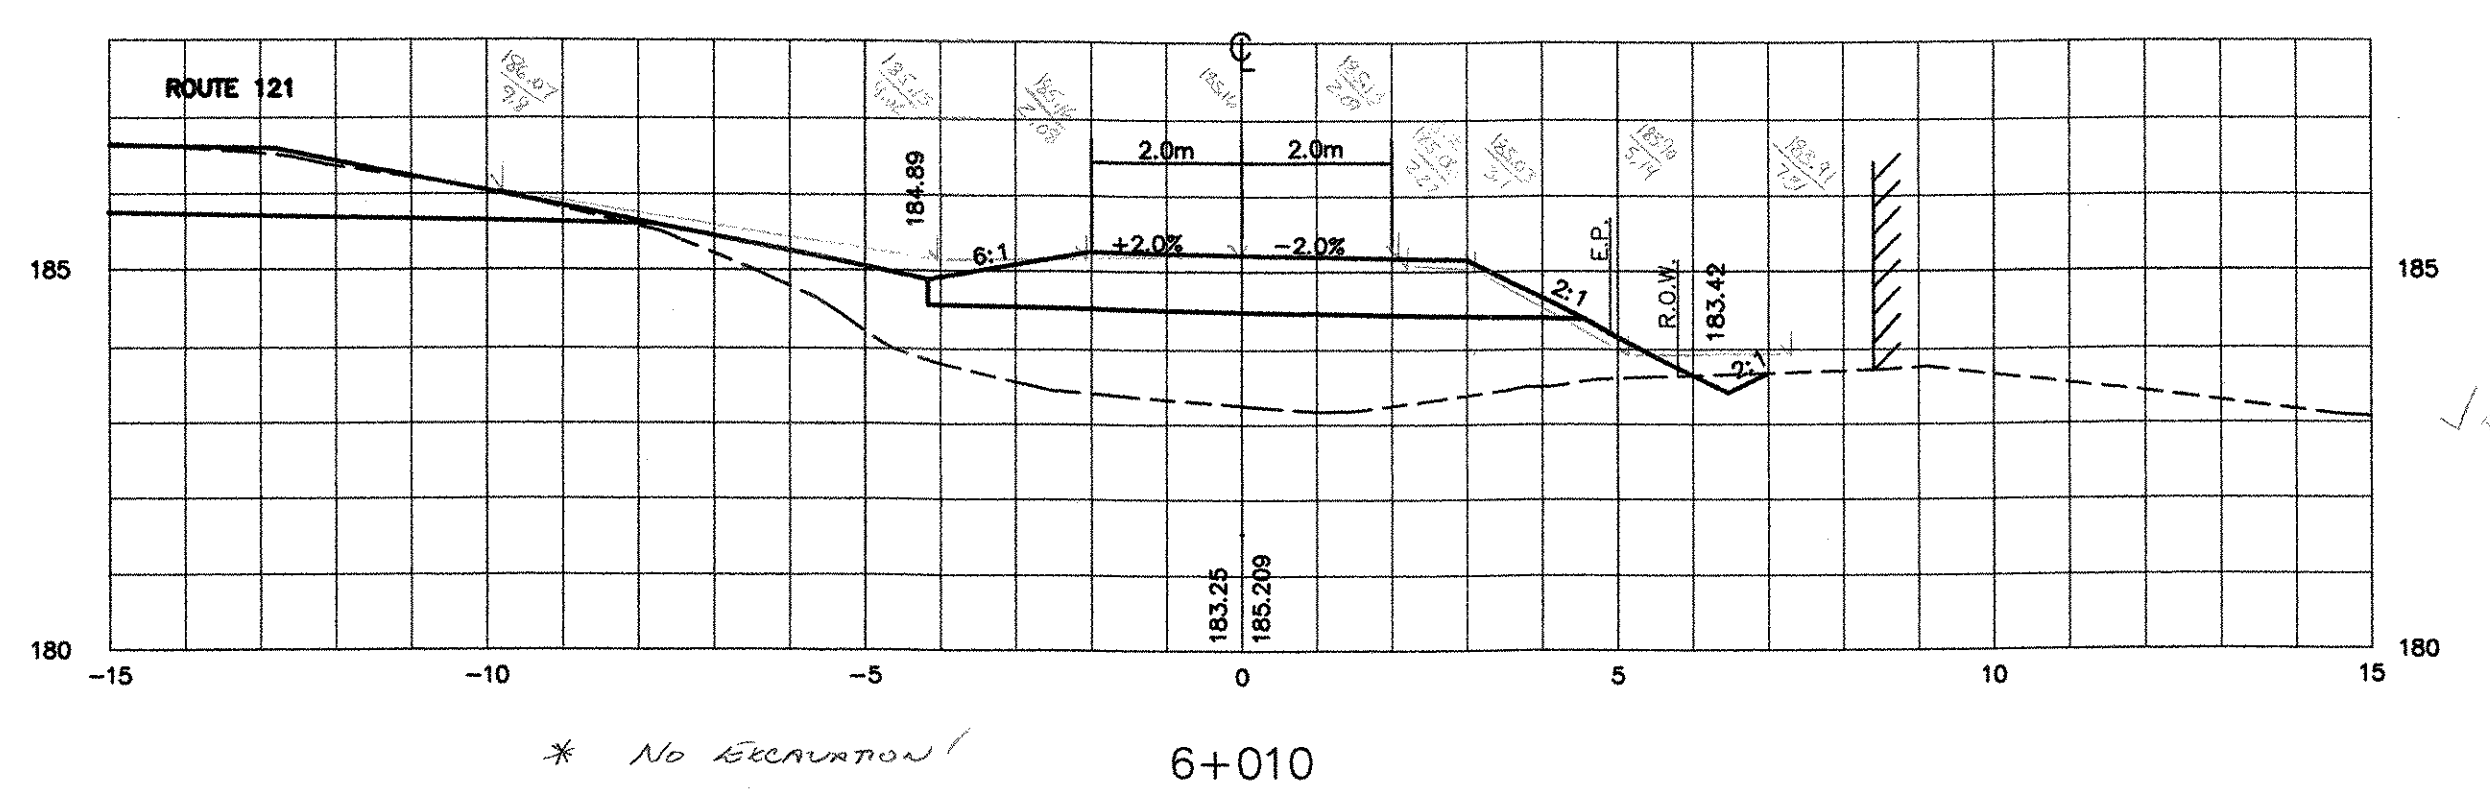
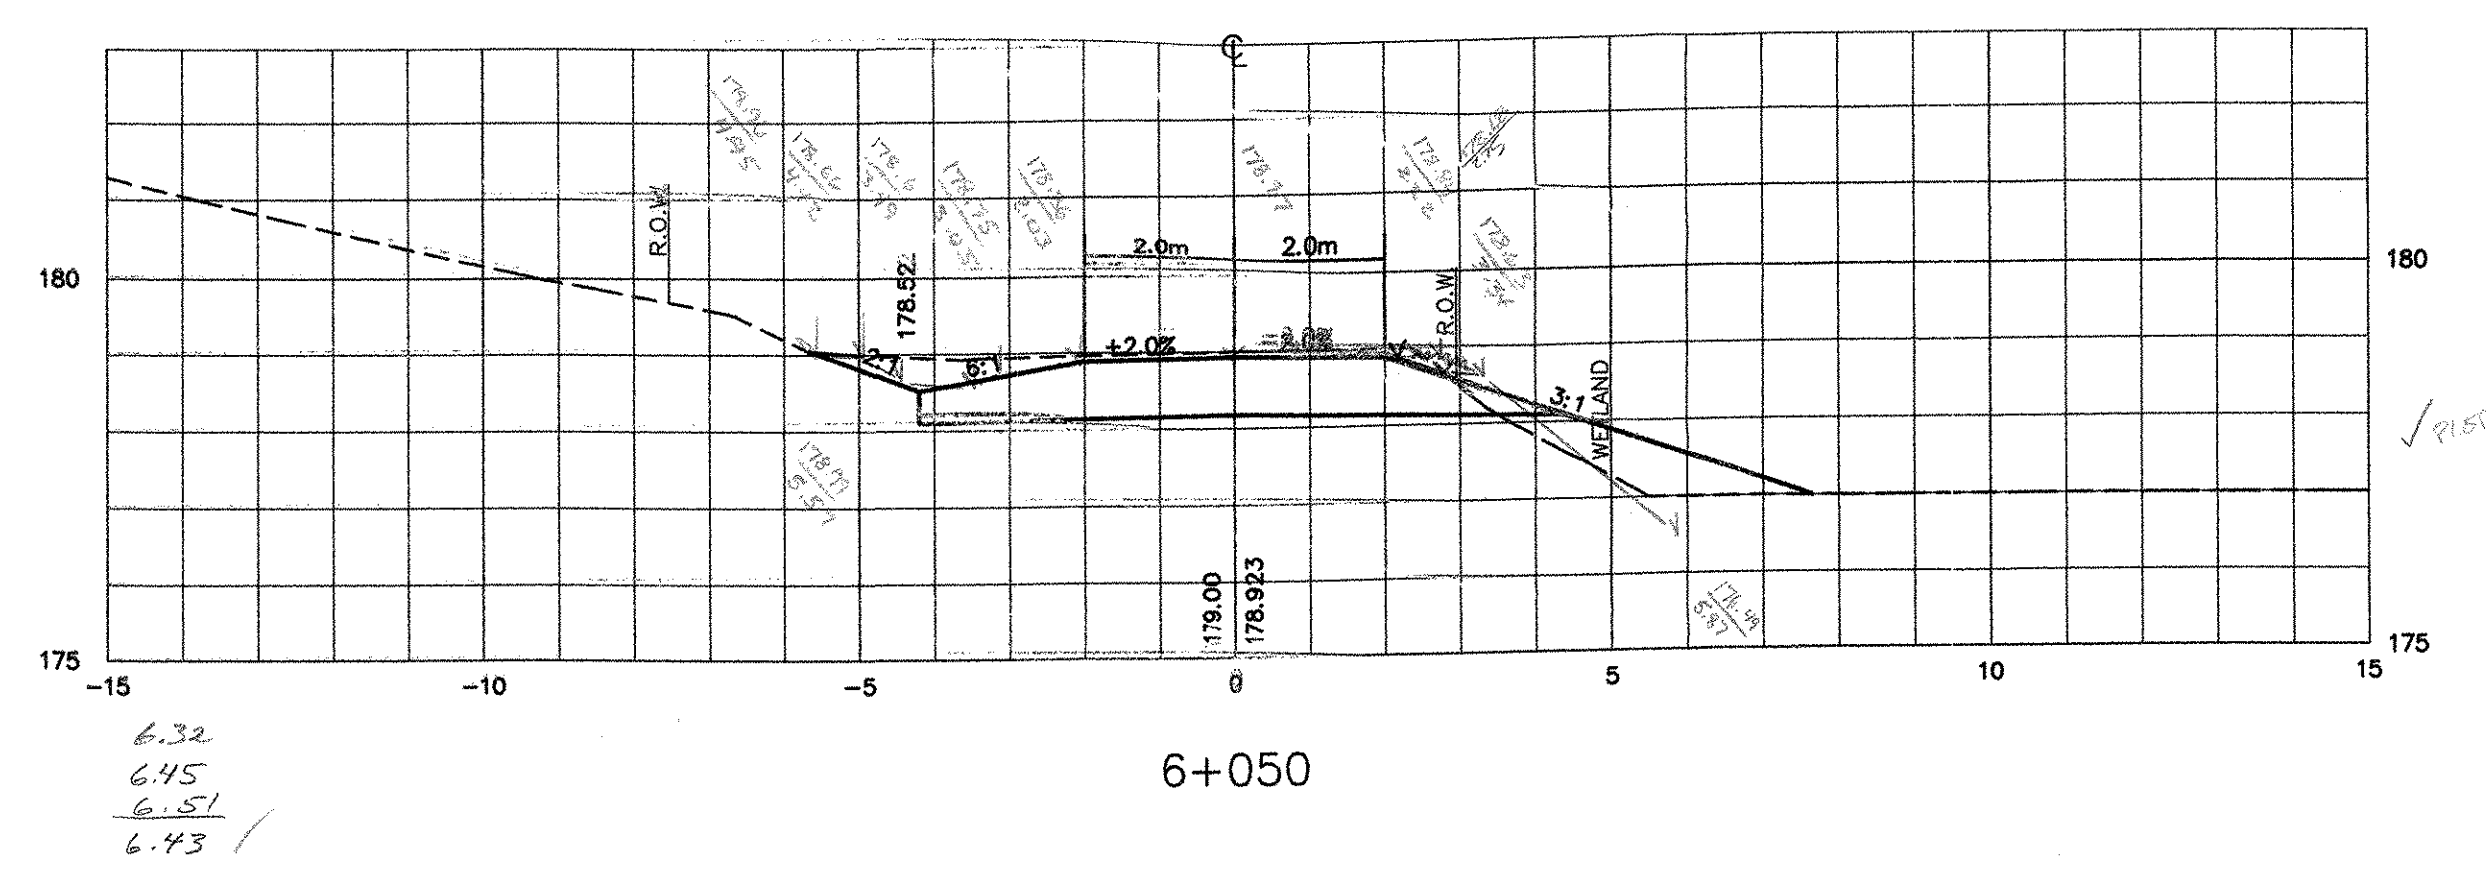


6+052 SAME COMMON AS 6+050

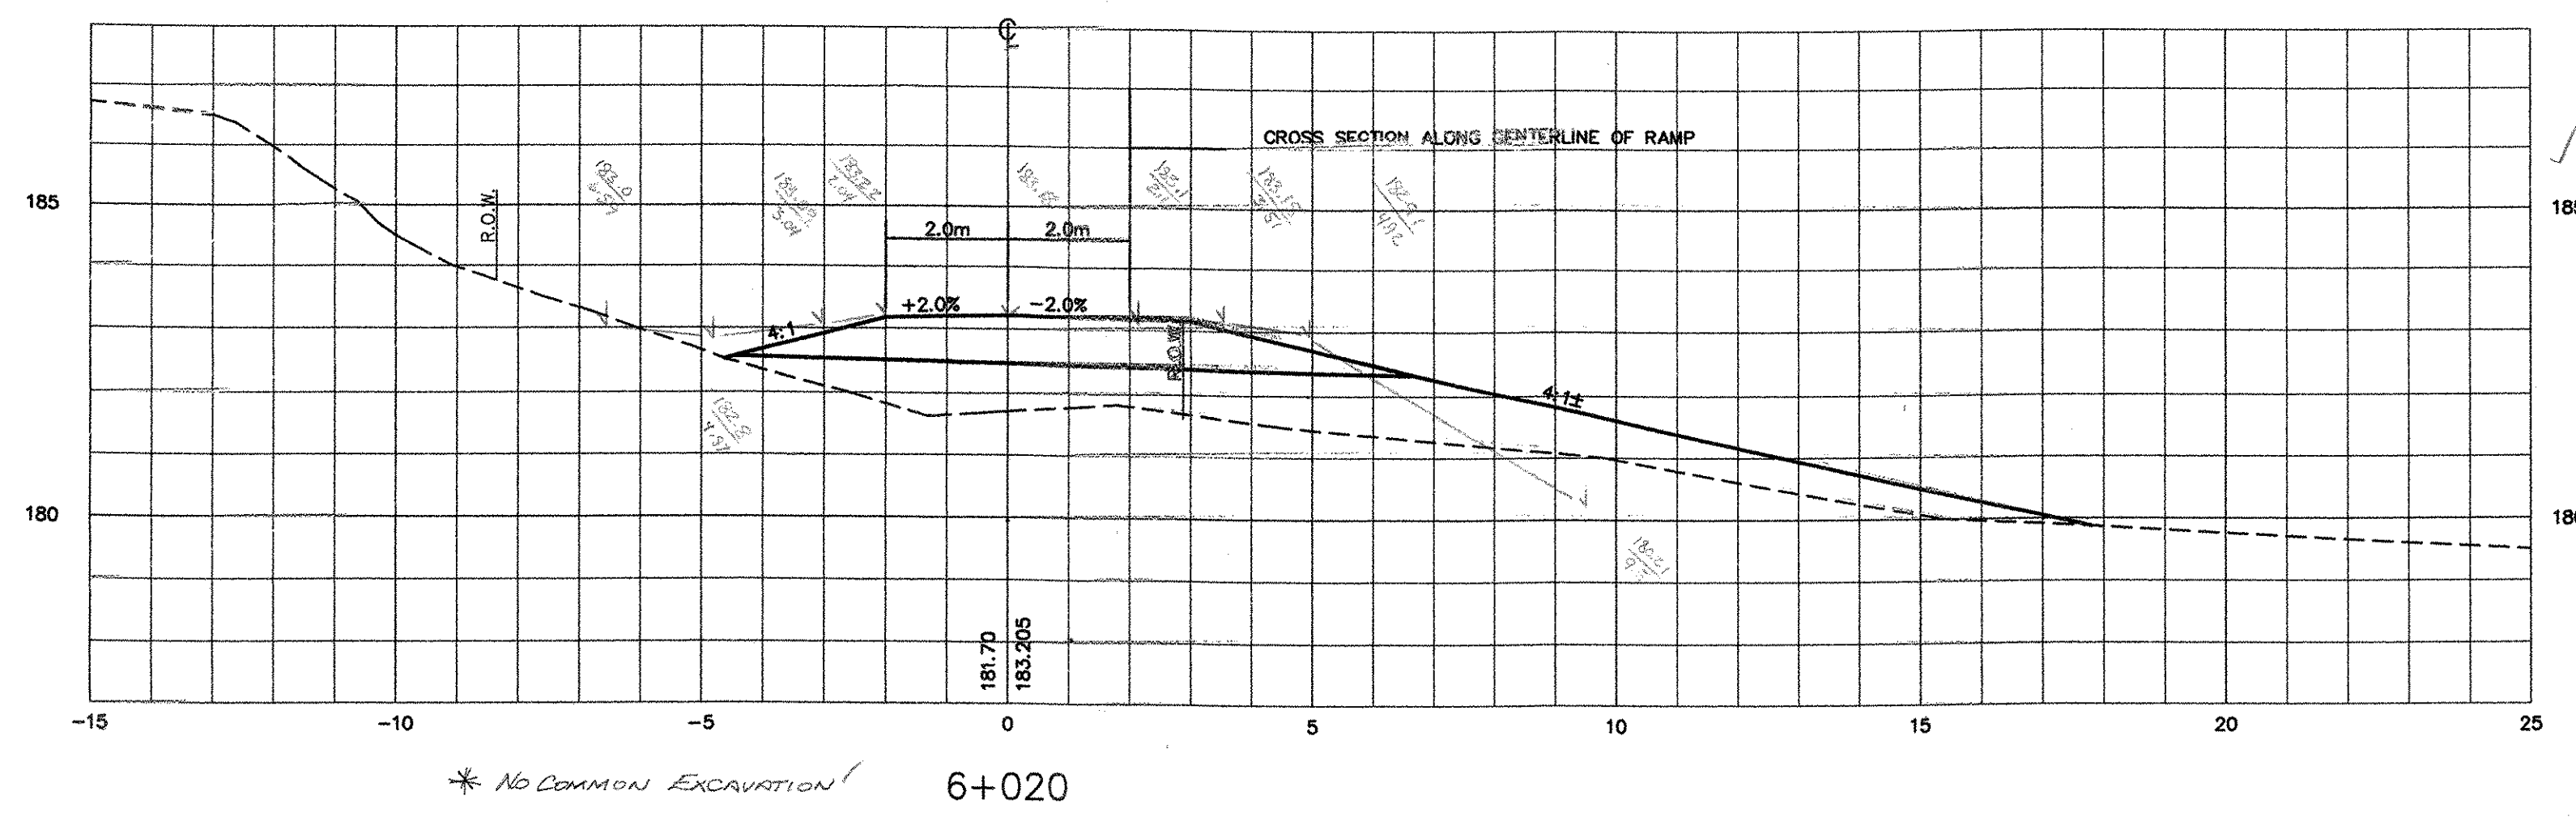

DATUM	
VERTICAL	NGVD 1929
HORIZONTAL	NAD 1927

V: /1261/CADD/PLANS/XSECTIONS-SKOOL.DWG

THE LOUIS BERGER GROUP, INC.

SCHOOLHOUSE ROAD SECTIONS	
PROJECT: GRAFTON-ROCKINGHAM, ROUTE 121	PROJECT NO. : STP 0126(4)S
DESIGN FILE NAME: IPARM FILE NAME: SURVEYED BY: SQUAD LEADER:	PLOT DATE: 12/08/02 SURVEY DATE: DRAWN BY: SHEET: 102 OF 116