


DATUM	
VERTICAL	NGVD 1929
HORIZONTAL	NAD 1927

V: /1261/CADD/PLANS/XSECTIONS-MANDIGO.DWG

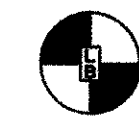

THE LOUIS BERGER GROUP, INC.

**MANDIGO ROAD SECTION**

PROJECT: GRAFTON-ROCKINGHAM, ROUTE 121	PROJECT NO. : STP 0126(4)S
DESIGN FILE NAME: IPARM FILE NAME: SURVEYED BY: SQUAD LEADER:	PLOT DATE: 12/08/03 SURVEY DATE: DRAWN BY: SHEET: 103 OF 116

*Handwritten signature and date: Loo J. 2/8/06*

*Handwritten note: C-52 2/8/06*