


20816 Stevia Road A/c

60	192.183
59	191.47
58	190.82
48	189.01
30	187.87
20	187.87
10	186.75
0	186.02
0	186.523
3	186.723
6	187.202
10	187.453
11	187.703
12	187.572
17	187.223
20	188.243
20	188.773
23	188.723
23	188.723
20	189.133
25	189.212
30	190.143
42	190.583
47	191.183
48	191.833
49	191.173
60	192.183

AREA = 3432 sm x 0.98m = 3363.36 cm²

OT 2/15/04

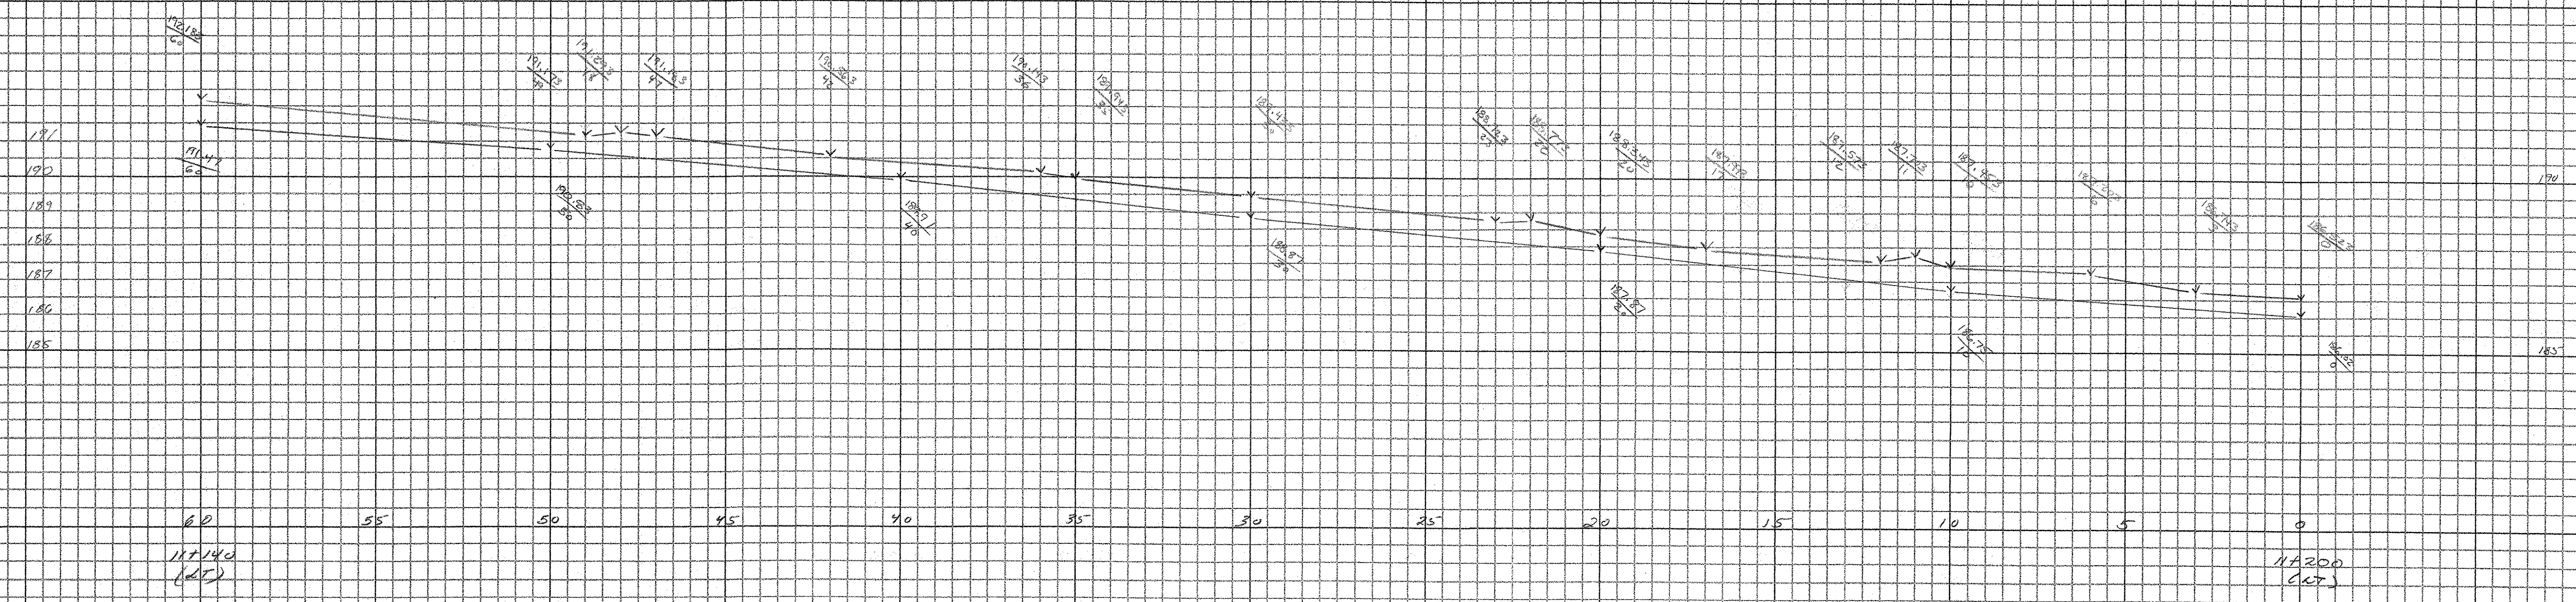

CROSS SECTION SHEET

PROJECT NAME: GRAFTON - ROCKINGHAM
 PROJECT NUMBER: STP 0126 (4) 5 9/2
 FILE NAME: _____ PLOT DATE: 07-JUN-2000 13:
 PROJECT LEADER: _____ DRAWN BY: C.GREENWOOD
 DESIGNED BY: _____ CHECKED BY: OTYLER
 const: g:/common/cadd/m-xsection.dgn SHEET 1 OF 1

150 LEGGE XS