

203/10 Solid Rock Exc.			
-2.65	187.18		
-2.25	187.80		
-4.33	187.14	-2.63	187.18
-6.14	189.51	+3.0	187.207
-2.13	189.83	-3.9	189.153
-8.1	189.25	-6.1	186.786
-8.3	189.30	-6.1	186.869
-3.2	187.061	0	186.854
-7.0	186.889	-1.5	186.78
-6.1	186.267	-2.08	187.18
-6.1	186.380		
-3.7	187.152		
-3.0	187.207		
-2.83	187.18		
AREA = 3.655 sm ²			
4.7	186.4		
AREA = 18.781 sm ²			
4.5	186.447		
5.3	186.70		
5.0	187.10		
3.5	186.70		
2.0	186.65		
1.7	186.4		
AREA = 1.189 sm ²			

EXTRA CUT AUTHORIZED BY D. BRUCE

0.3m x 1.2m = 1.26 sm²

EXTRA CUT AUTHORIZED BY D. BRUCE



203/6 Solid Rock Exc.			
-4.8	186.5	-4.8	186.5
-6.1	186.85	-6.1	186.85
-6.1	185.87	-6.1	185.87
-7.0	185.87	0.75	185.87
-2.2	186.821	0	186.821
-2.5	187.4	-2.0	187.4
-5	186.6	-2.02	186.53
-4.8	186.5	-4.0	186.75
		-5.0	186.60
		-4.8	186.52
AREA = 2.26 sm ²			

EXTRA CUT AUTHORIZED BY D. BRUCE

0.3m x 1.3m = 0.39 sm²

EXTRA CUT AUTHORIZED BY D. BRUCE

AREA = 3.97 sm²

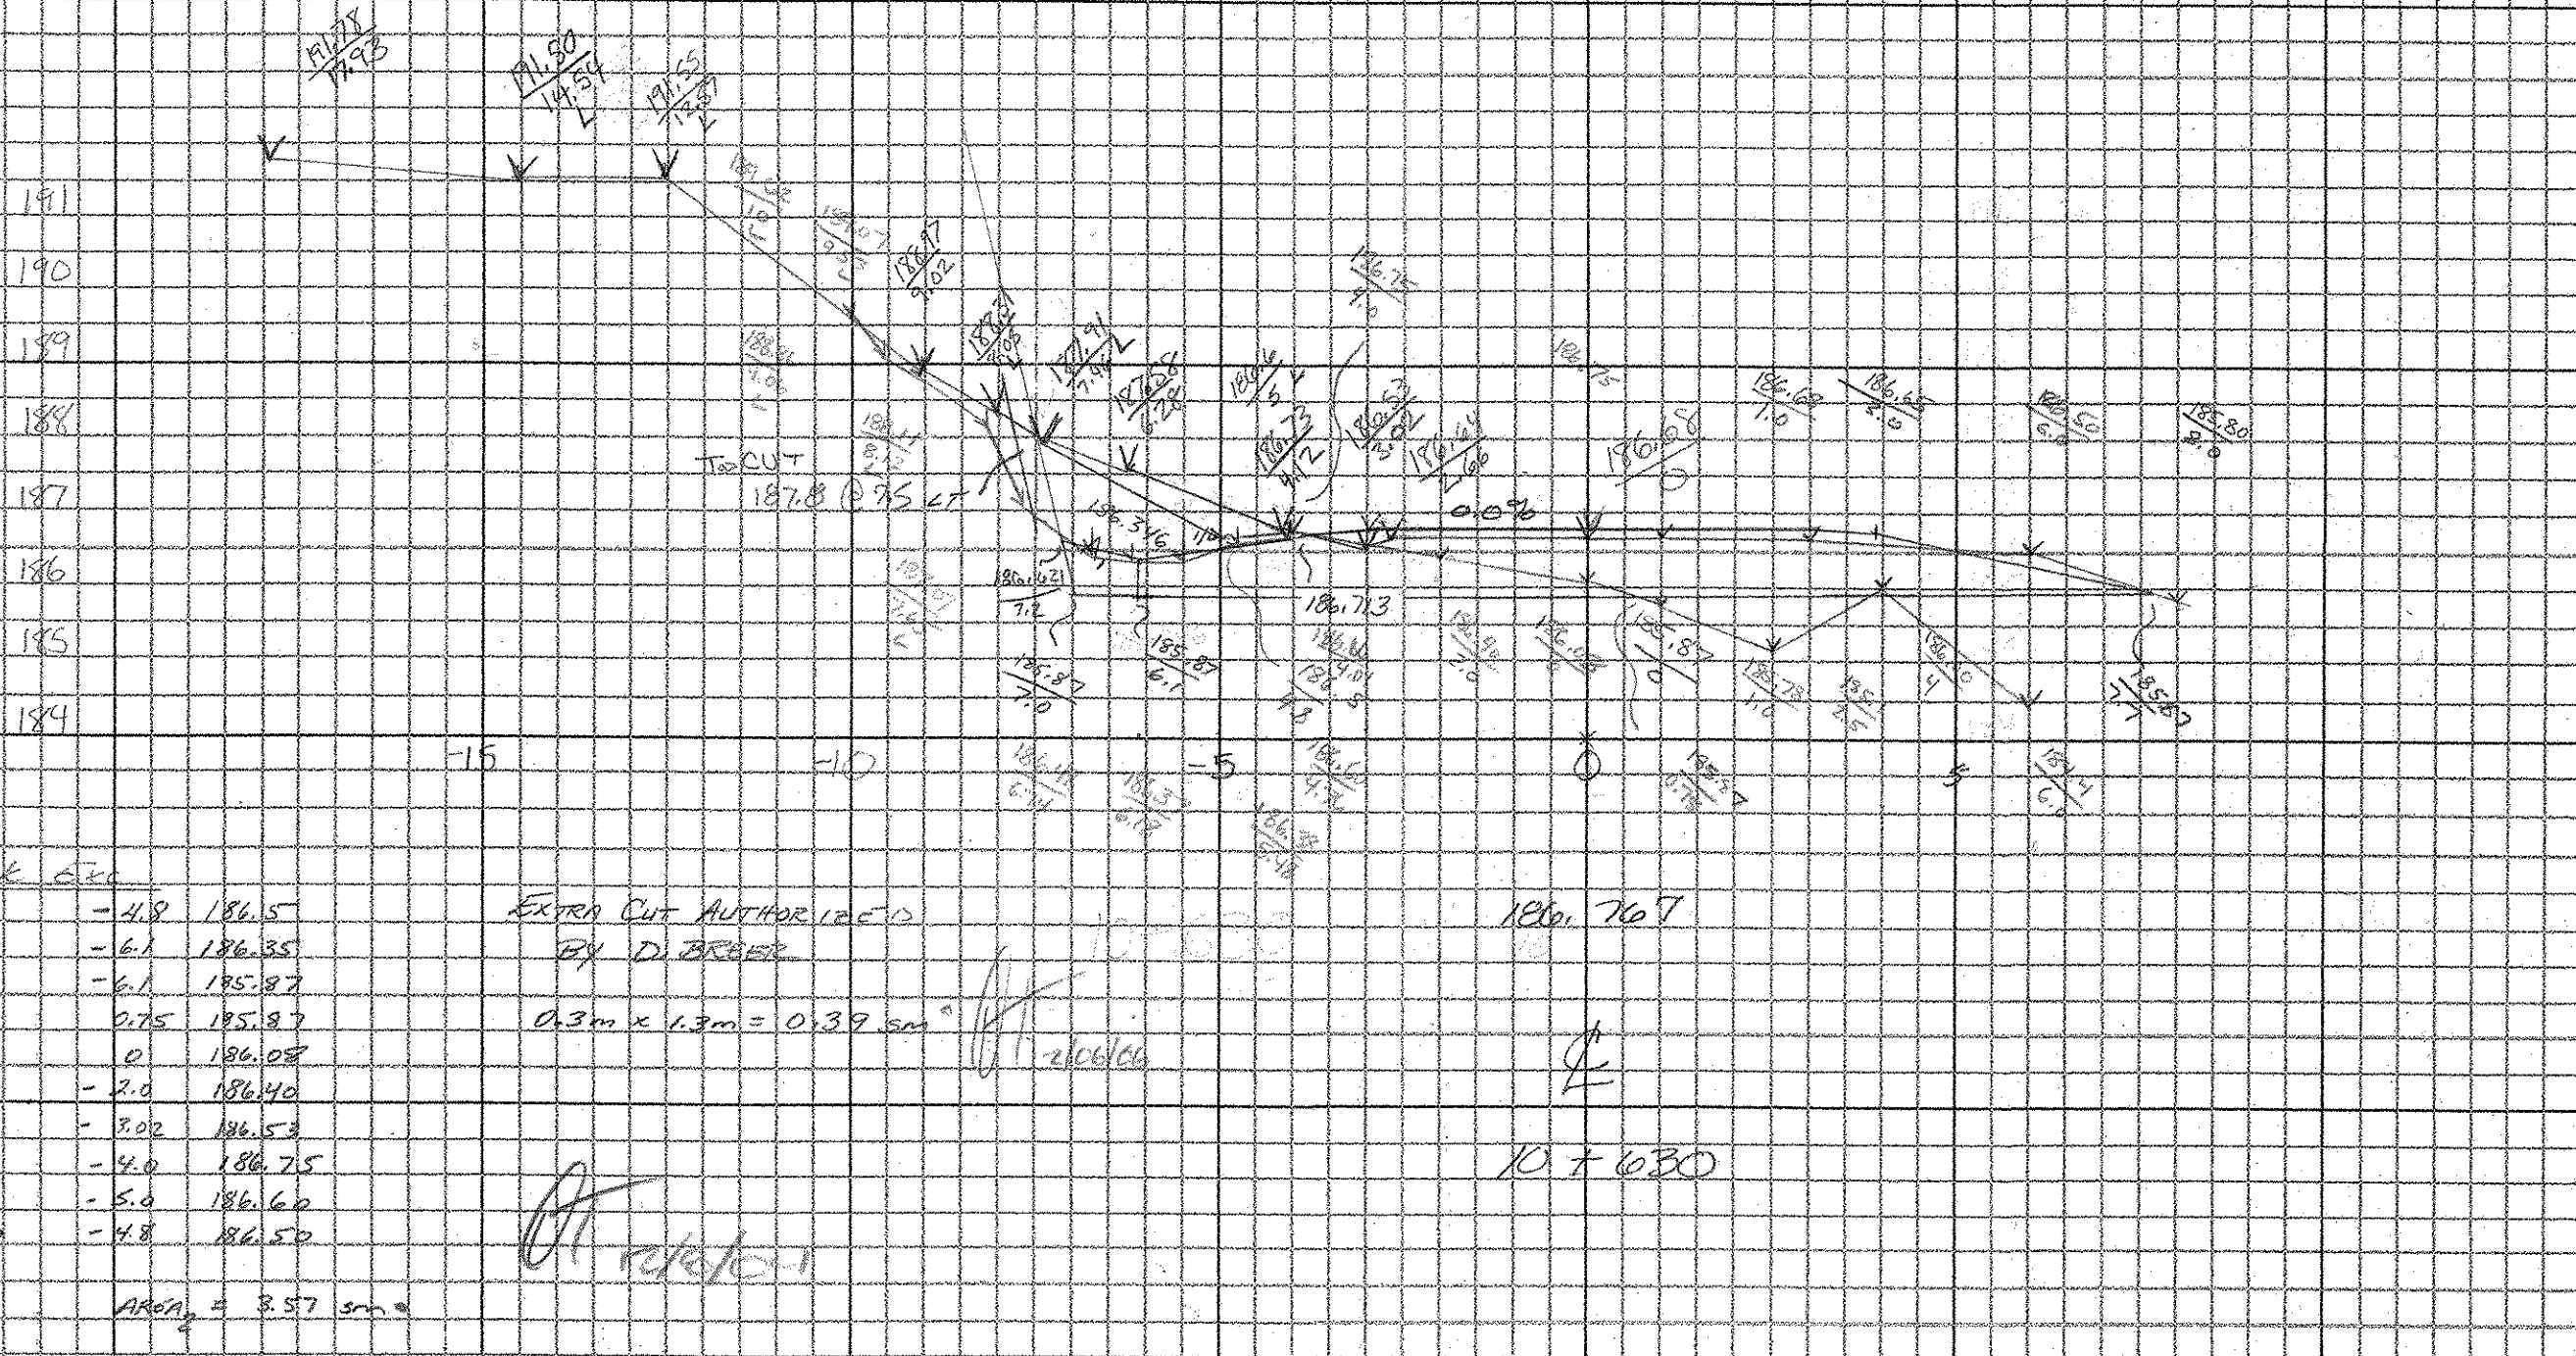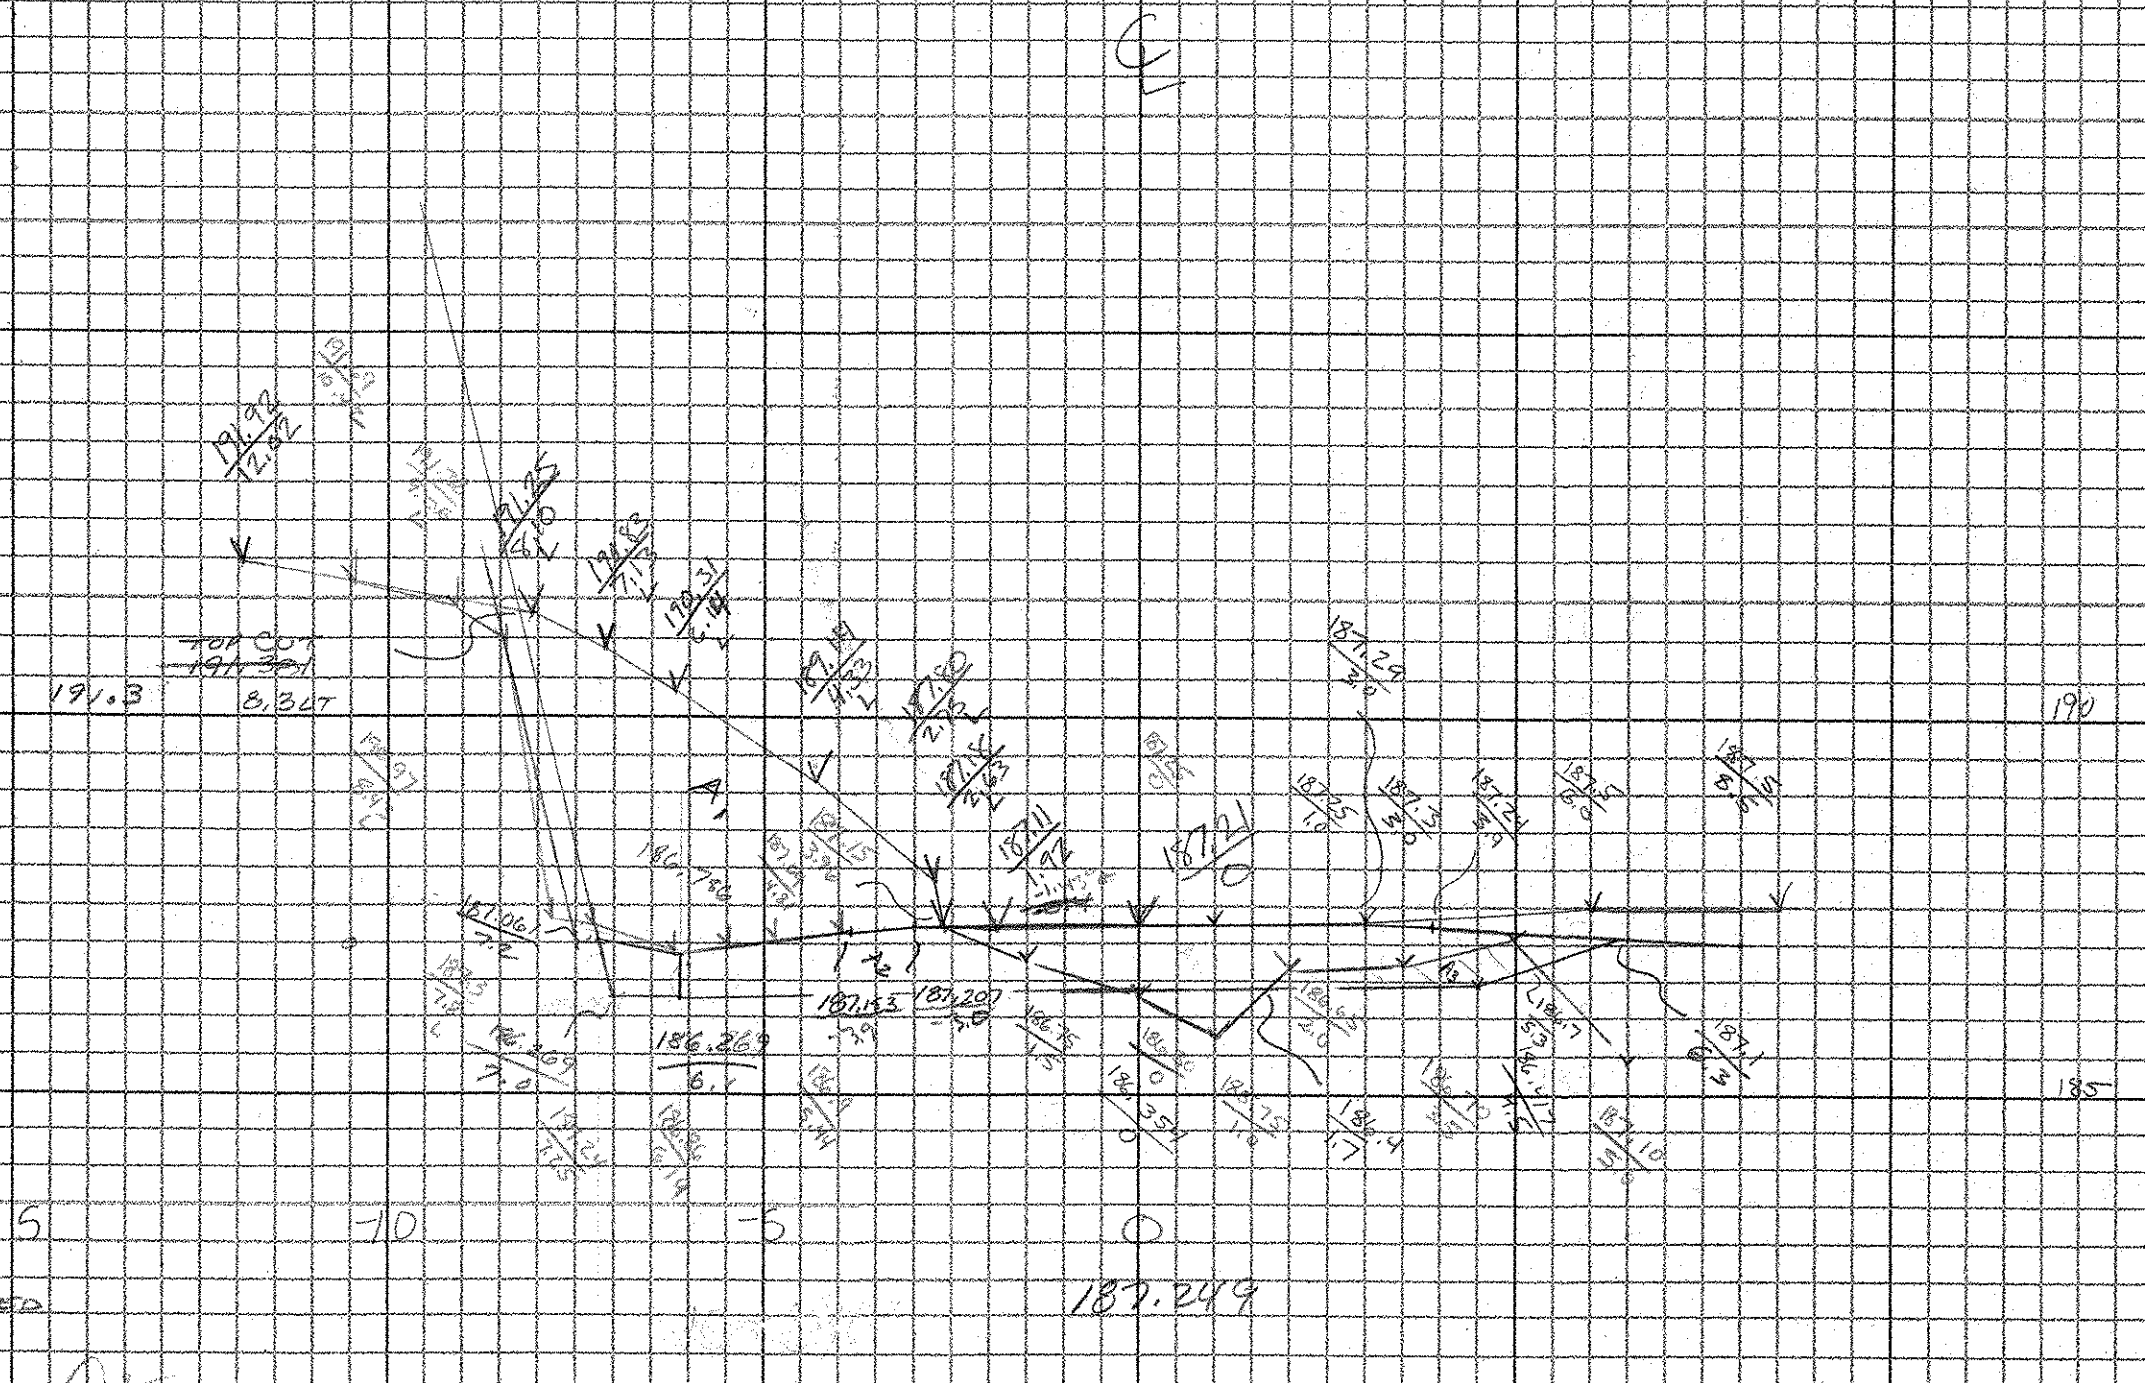

* Scale: 1:100



CROSS SECTION SHEET

PROJECT NAME: Greifon- Rockingham
 PROJECT NUMBER: STP 0126 (4) C/7
 FILE NAME: Ledge (Small cut) PLOT DATE: 07-JUN-2000 13:
 PROJECT LEADER: _____ DRAWN BY: J. Smith
 DESIGNED BY: _____ CHECKED BY: D. Bruce
 const: g:/common/cadd/m-xsection.dgn SHEET 2 OF 4

1616066 XS