


ROUTE 121 CROSS SECTIONS

PROJECT: GRAFTON-ROCKINGHAM, ROUTE 121	PROJECT NO. : STP 0126(4)S
DESIGN FILE NAME:	PLOT DATE: 12/08/03
IPARM FILE NAME:	SURVEY DATE:
SURVEYED BY:	DRAWN BY:
SQUAD LEADER:	SHEET: 25 OF 116

DATUM	
VERTICAL	NGVD 1929
HORIZONTAL	NAD 1927

V: /1261/CADD/PLANS/SECTIONS-FINAL-ROUTE121-C2C.DWG

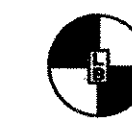

THE LOUIS BERGER GROUP, INC.