

208.30 CONCRETE ESCAVATION AREA

5.95	183.90
6.20	183.45
7.16	182.18
10.65	185.45
10.65	180.50
5.95	183.00

AREA = 18.124 sm²

[Handwritten signature]


204.00 GRAVEL FILL FOR STRUCTURES

6.95	180.50	7.7	182.30
6.55	180.50	10.65	183.38
6.55	183.25	10.65	180.50
7.30	188.25	10.65	180.50
7.30	181.60	10.65	181.25
6.10	182.60	7.90	181.25
5.95	180.90	7.7	181.30
5.95	180.50		

A = 18.96

AREA = 8.77 sm²

[Handwritten signature]

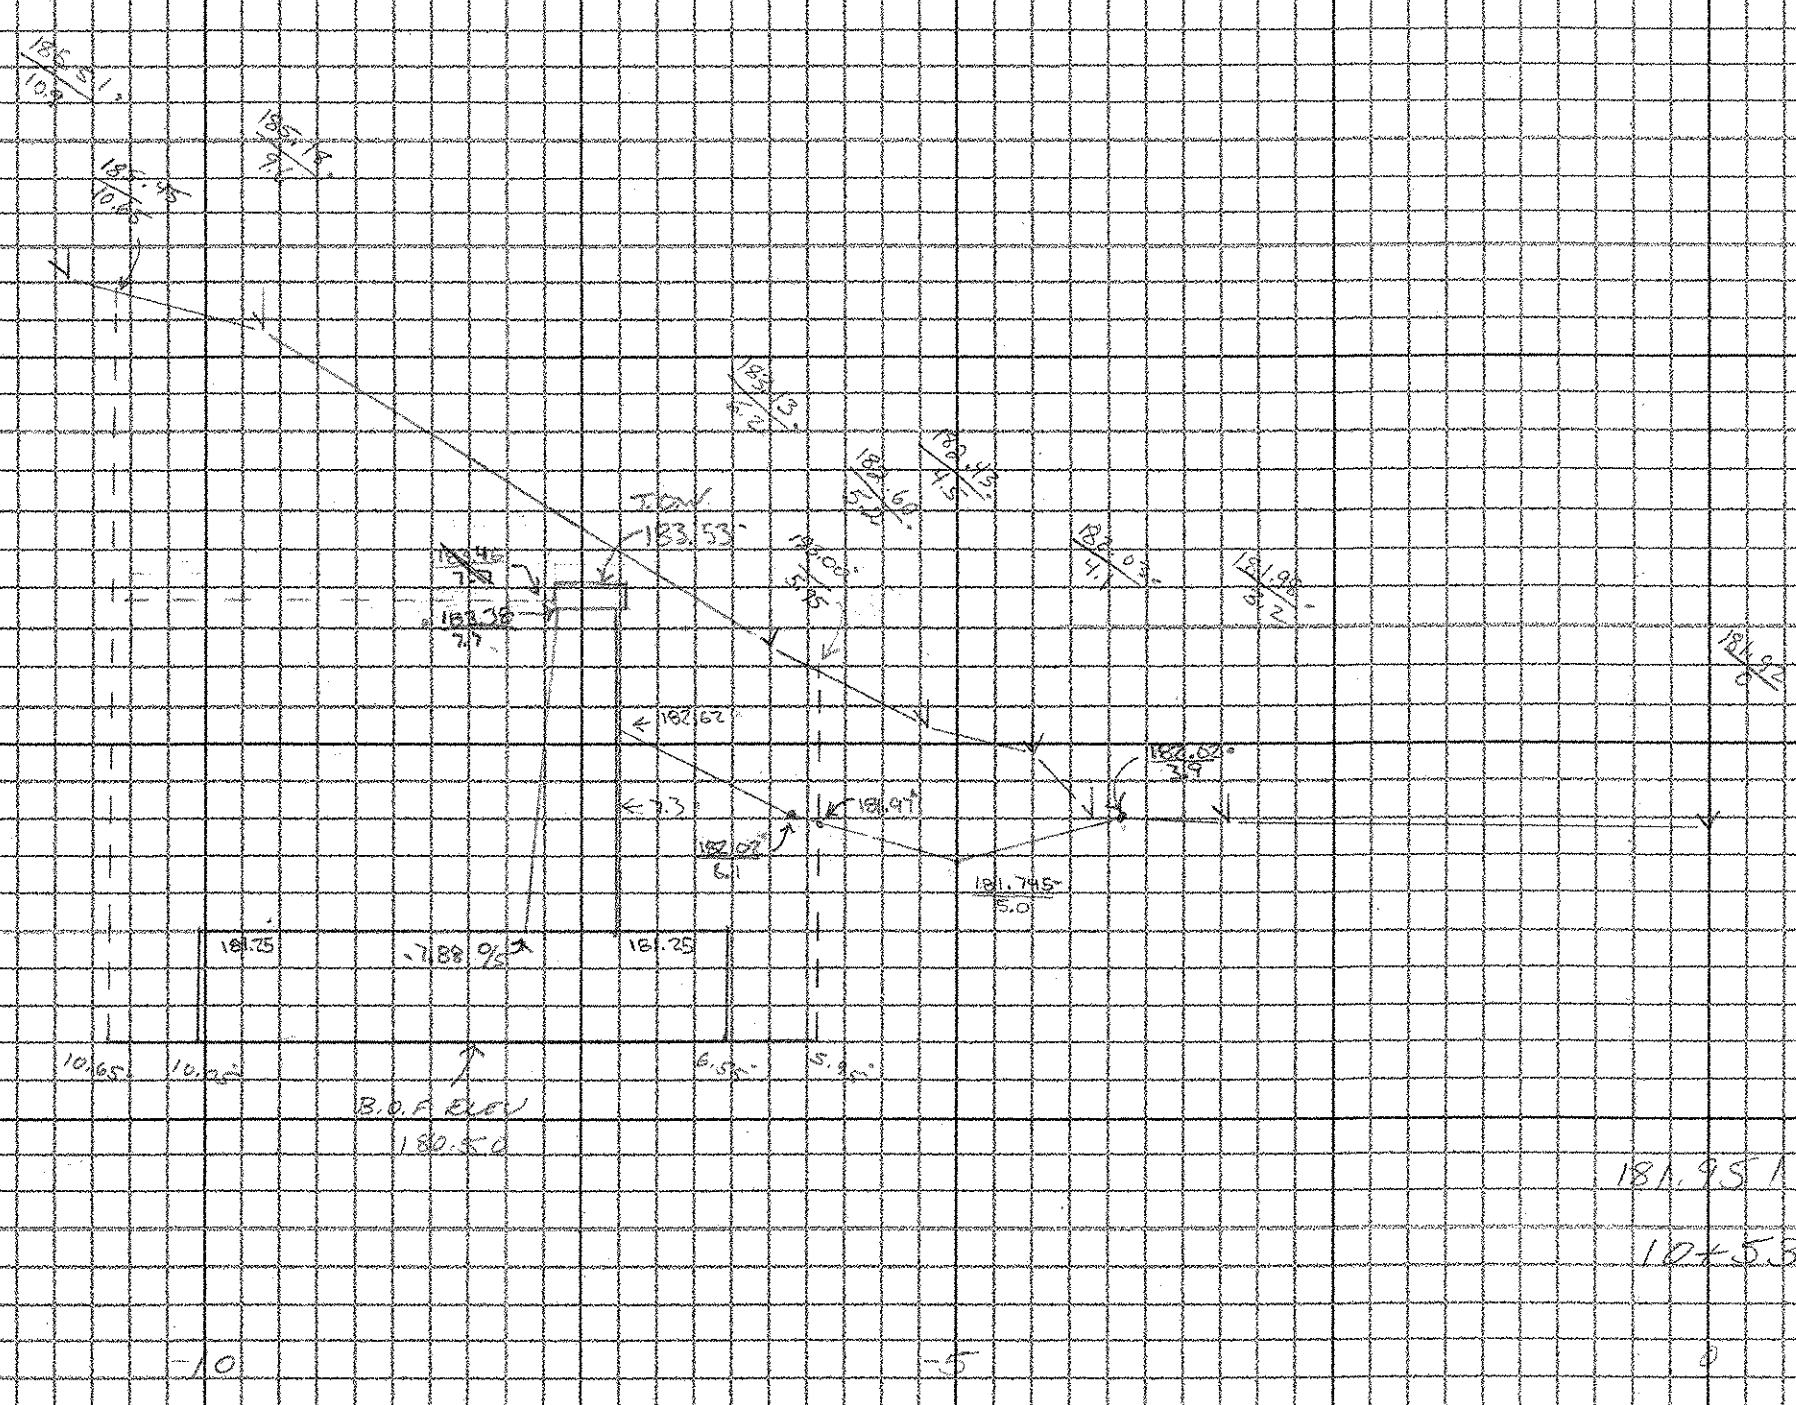

181.951
10x5.30

201.30 GRAVEL FILL FOR STRUCTURES

6.95	180.50	7.7	182.00
5.95	181.25	10.65	182.60
6.1	181.70	10.65	180.50
7.3	183.30	10.65	180.50
7.3	181.25	10.65	181.25
6.55	181.25	7.90	181.25
6.15	180.50	7.7	182.60
5.95	180.50		
6.1	181.25		

AREA = 5.90 sm²


[Handwritten signature]

208.30 CONCRETE ESCAVATION AREA

5.95	181.96
6.10	181.99
7.90	181.33
10.65	181.68
10.65	180.50
5.95	180.50
5.95	181.96

AREA = 12.106 sm²

[Handwritten signature]

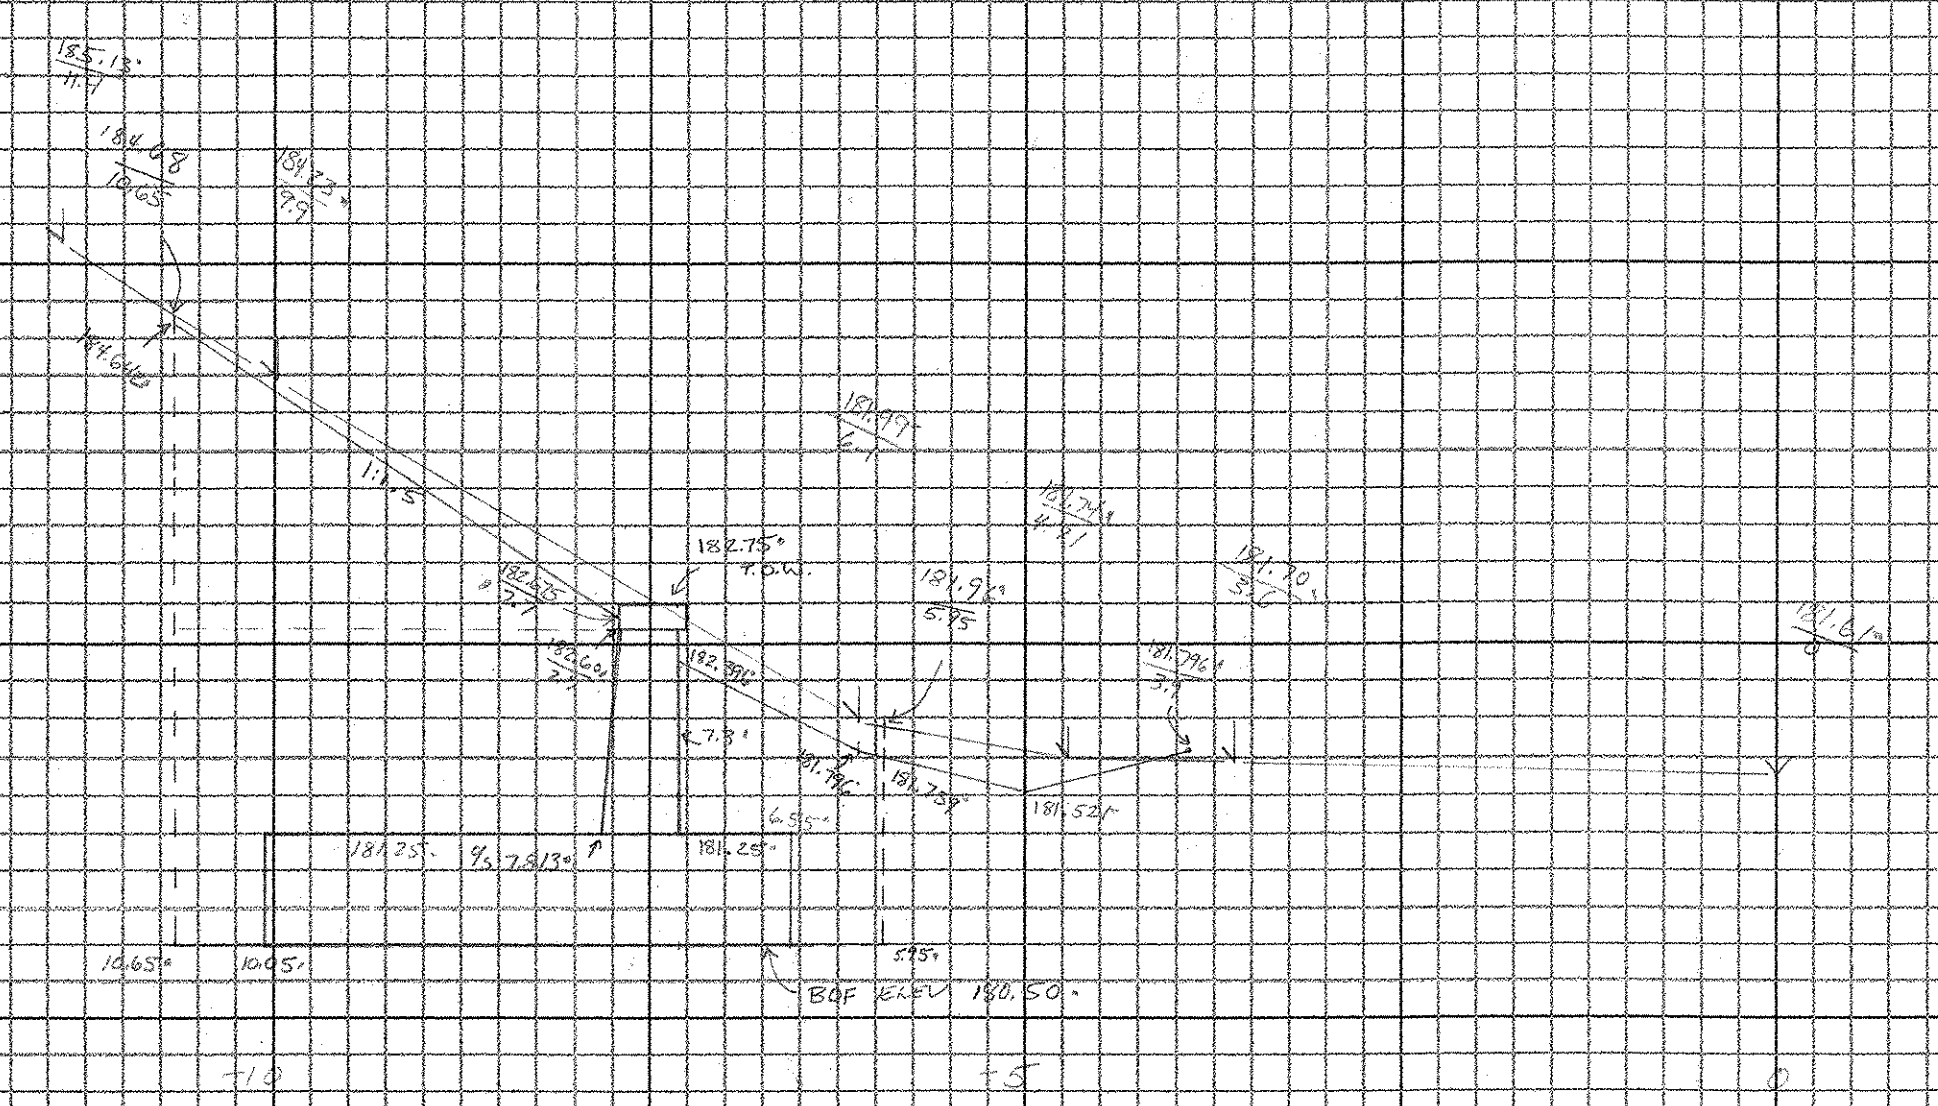

10x5.35

SCALE 1:500



CROSS SECTION SHEET

PROJECT NAME: GRAFTON - ROCKINGHAM
 PROJECT NUMBER: SIP 016 (4)S CONTRACT #2
 FILE NAME: Retaining Wall #3 PLOT DATE: 07-JUN-2000 13:
 PROJECT LEADER: _____ DRAWN BY: C.GREENWOOD
 DESIGNED BY: _____ CHECKED BY: _____
 const: g:/common/cadd/m-xsection.dgn SHEET 1 OF 4