


185
184
183
182
181
180

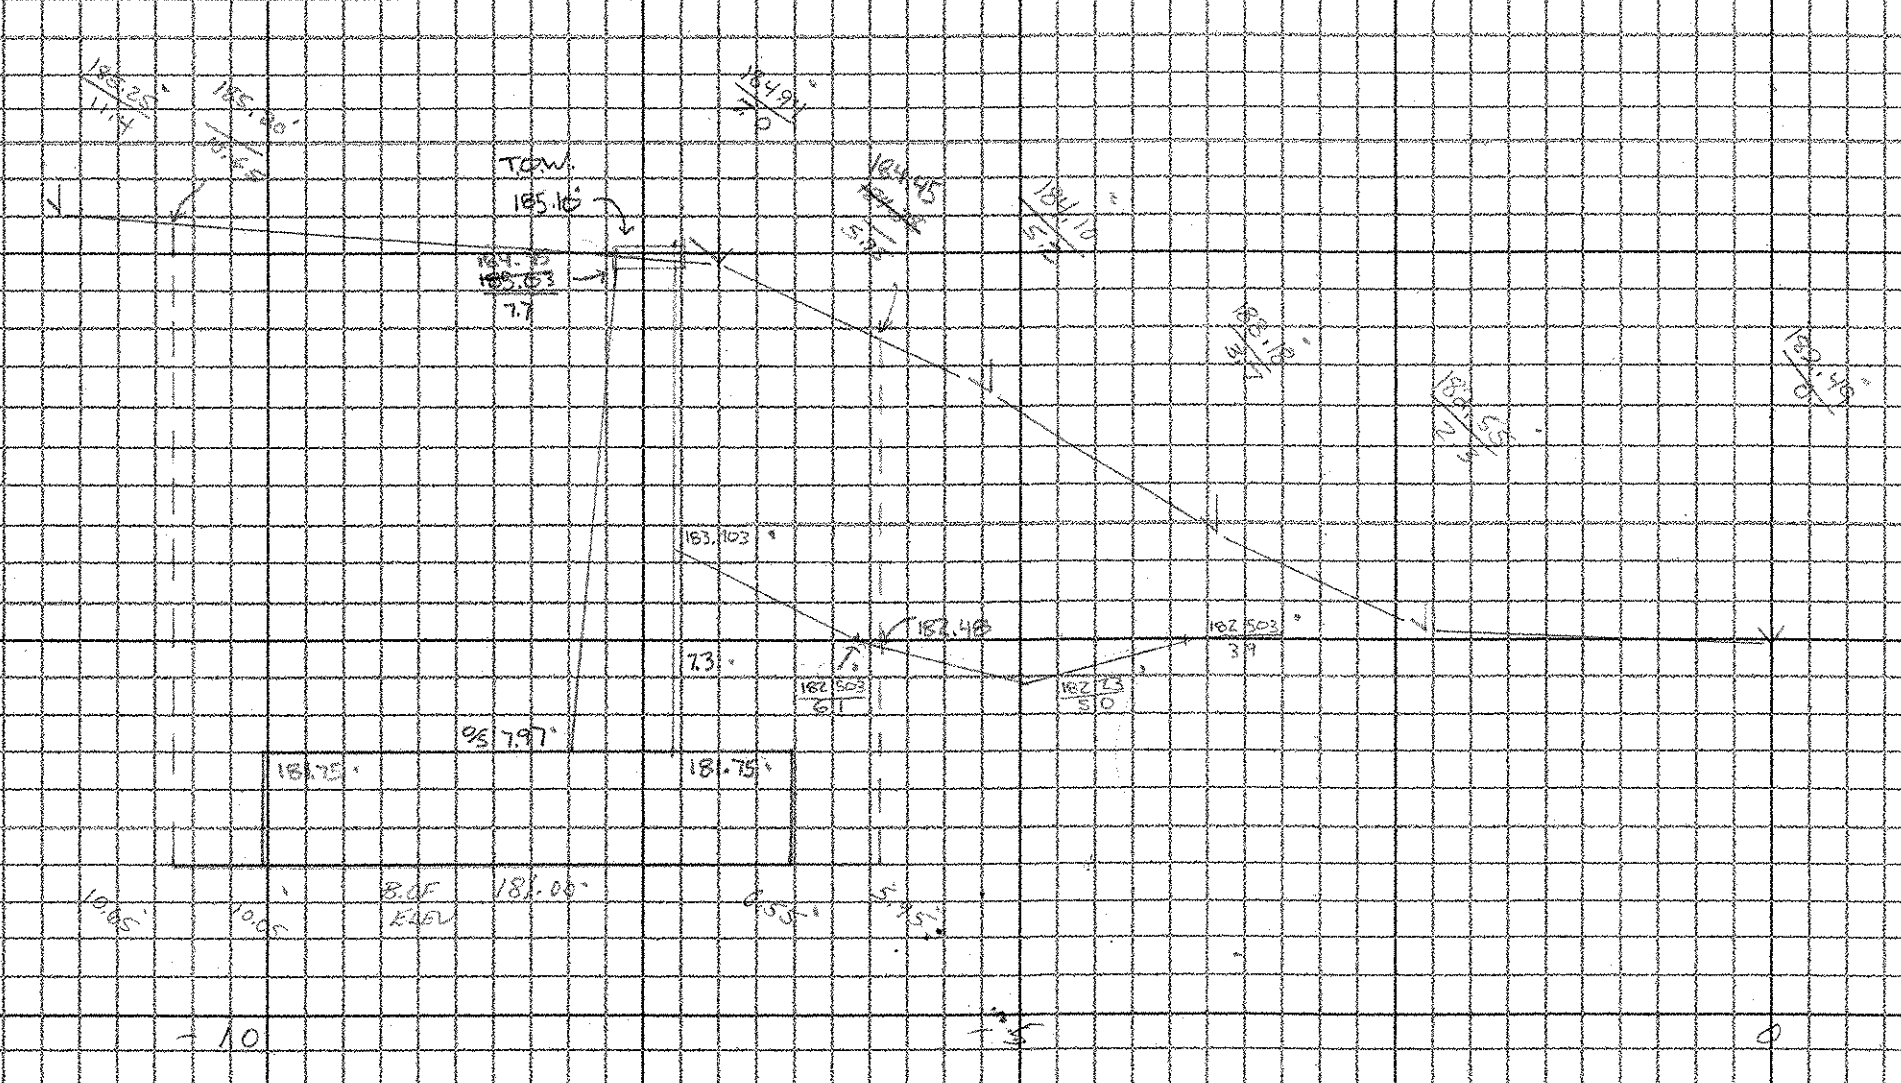

203.30 Cofferdam Excavation, Earth

5.95	184.50	184.45
7.0	184.24	-
10.65	183.24	-
12.65	181.70	-
15.85	181.20	-
18.95	180.30	184.45

204.30 GRAY BACKFILL FOR STRUCTURES


5.95	181.00	7.7	184.45
5.95	182.48	10.65	183.20
6.10	182.50	10.65	181.00
7.0	183.10	10.65	181.00
7.0	181.75	10.65	181.75
6.55	181.75	7.7	181.75
6.55	181.00	7.7	184.45
5.95	181.00	-	-

AREA: 11.65

1.1
1.19-05

107540

185
184
183
182
181
180

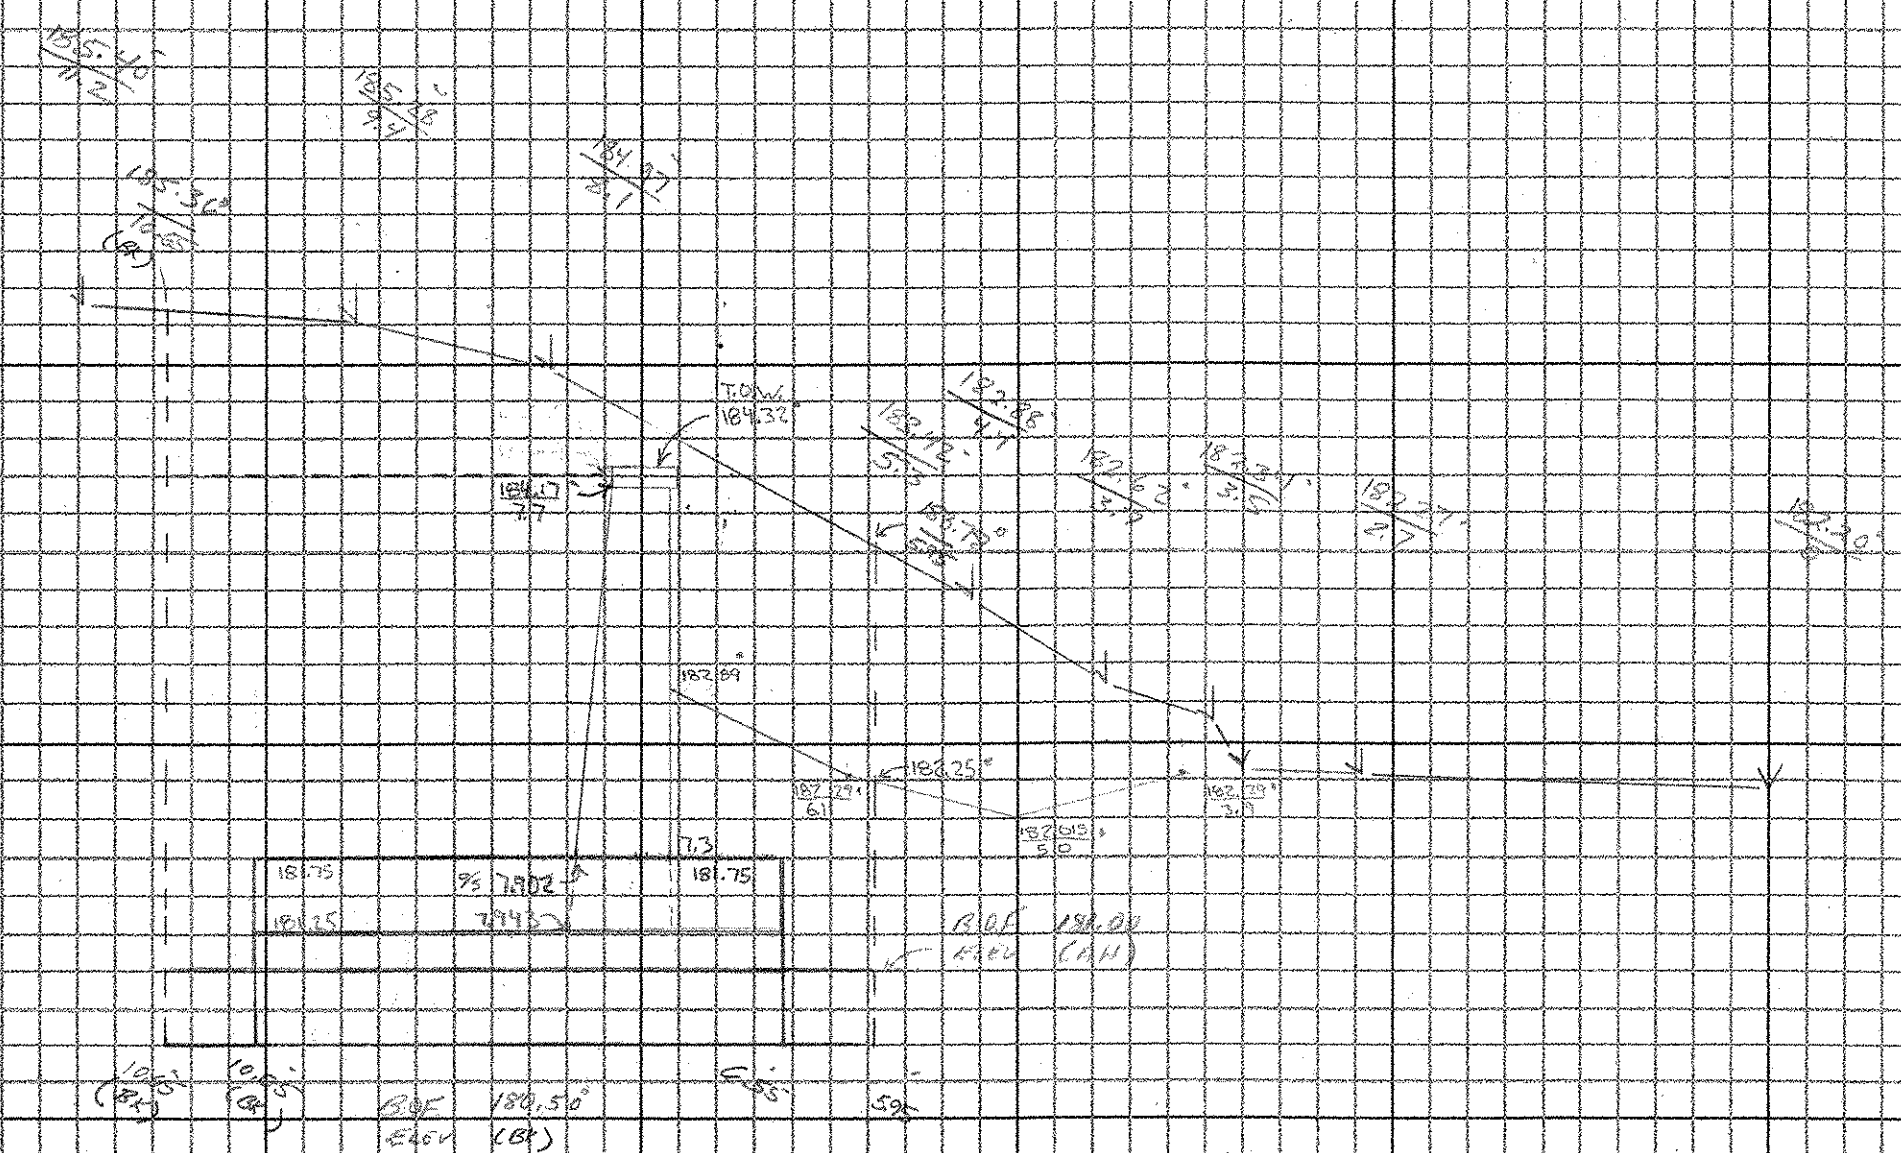

203.30 Cofferdam Excavation, Earth

(Back)

5.95	183.78	5.25	183.78
8.10	184.27	8.1	184.27
9.4	185.32	9.4	185.28
10.65	185.36	10.65	185.36
10.65	185.52	12.45	184.20
5.95	182.57	1.78	184.00
5.95	183.78	5.95	183.78

AREA: 20.367 sqm

AREA: 18.017 sqm

204.30 GRAY BACKFILL FOR STRUCTURES

(Ahead)

5.95	186.00	7.70	184.75
6.55	184.00	7.70	184.17
6.55	184.75	10.65	184.17
7.00	181.75	10.65	181.00
7.00	182.89	10.65	181.00
6.10	182.29	10.65	180.50
5.95	182.50	7.70	181.75
5.95	184.00	-	-

AREA: 11.536

AREA: 7.345

AREA: 8.866

(Back)

5.95	180.50	7.70	181.25
6.55	180.50	7.70	184.17
6.55	181.25	10.65	181.17
7.00	181.25	10.65	180.50
7.00	182.89	10.65	180.50
6.10	182.29	10.65	181.25
5.95	181.75	7.70	181.75
5.95	180.50	-	-

AREA: 7.211

AREA: 8.791

AREA: 10.92

SCALE: 1:500



CROSS SECTION SHEET

PROJECT NAME: GRADON-Backwillam Channel #2
 PROJECT NUMBER: STP 0126 4(5)
 FILE NAME: RETAINING WALL #3 PLOT DATE: 07-JUN-2000 13:
 PROJECT LEADER: _____ DRAWN BY: C. GREENWOOD
 DESIGNED BY: _____ CHECKED BY: _____
 const: g:/common/cadd/m-xsection.dgn SHEET 2 OF 4