


185  
184  
183  
182  
181  
180

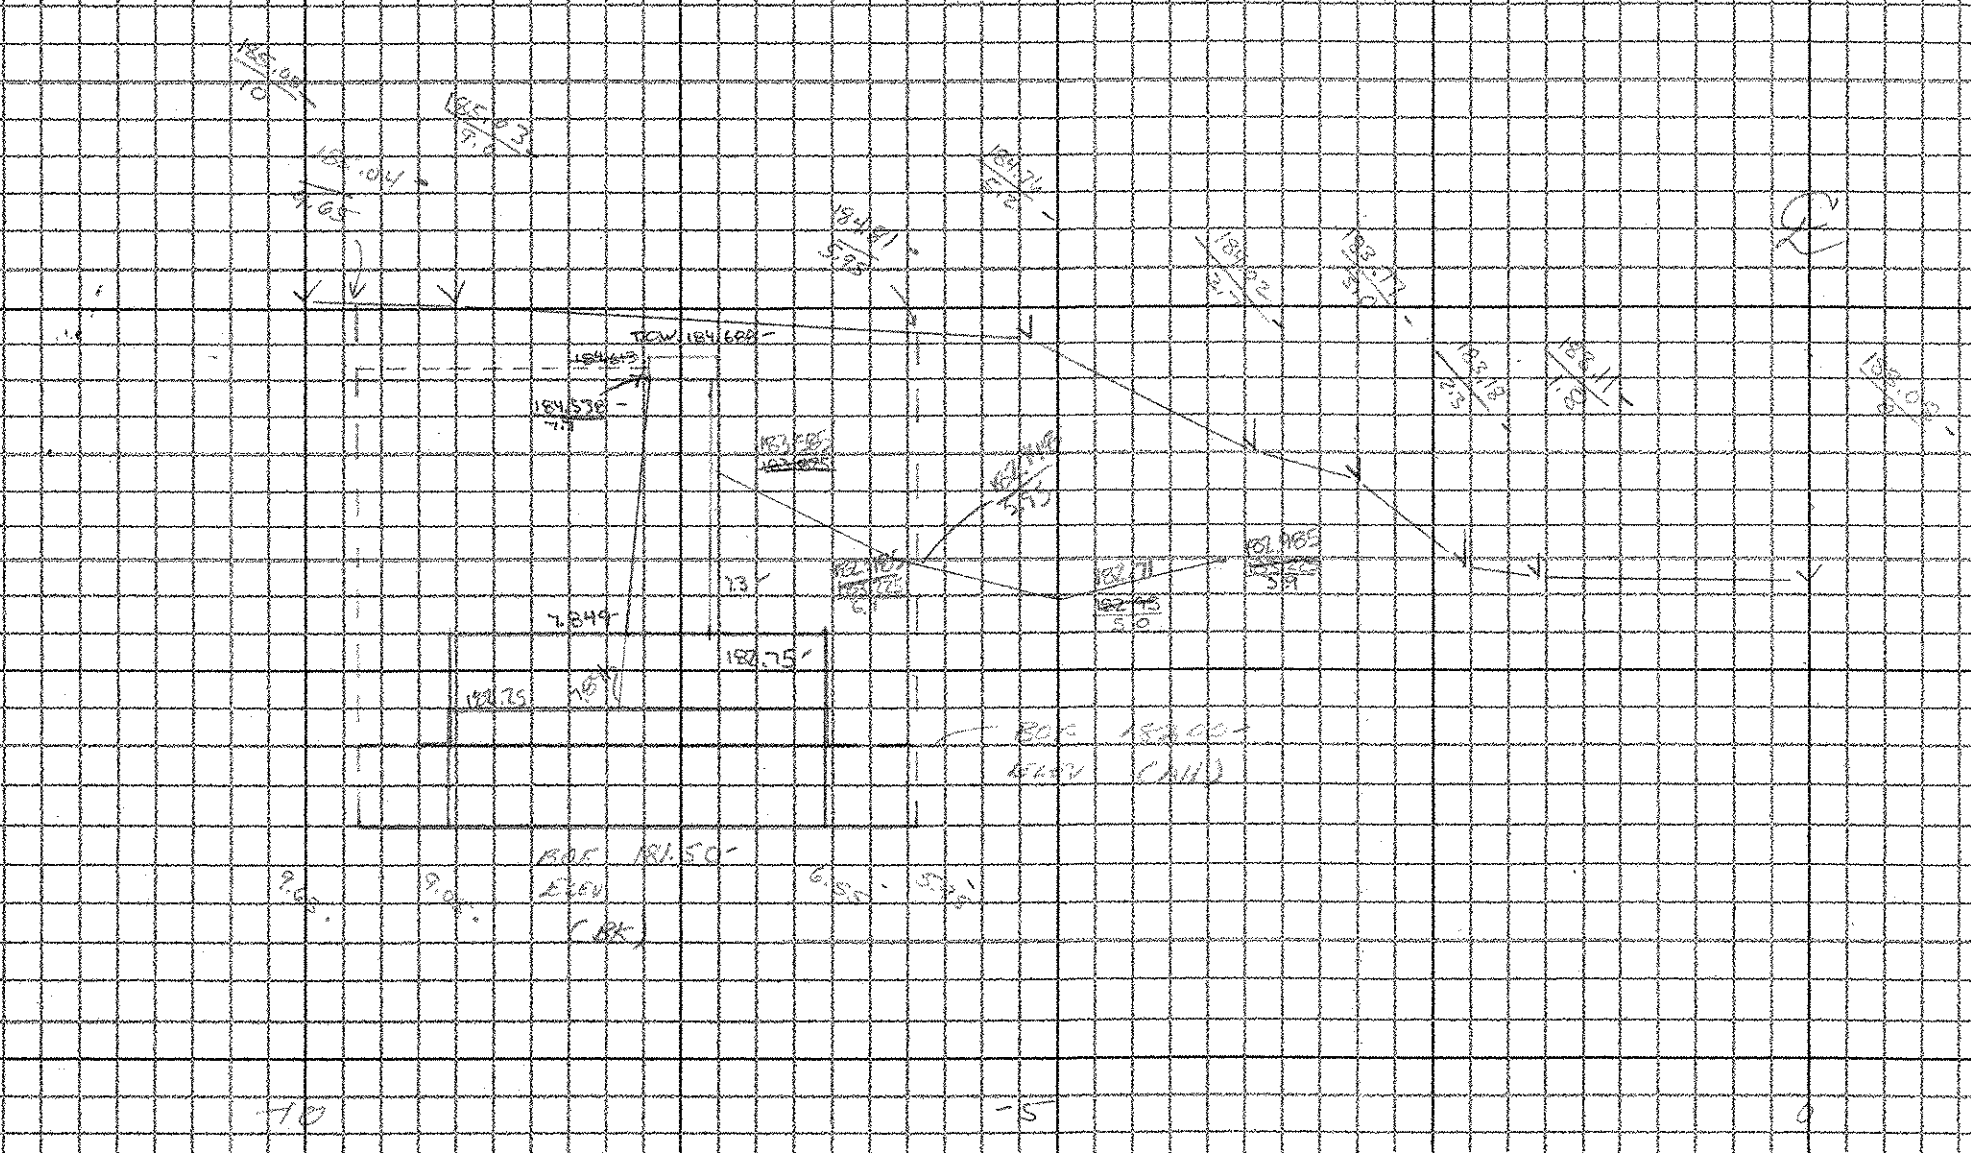

107.550

308.30 COFFER DAM APPROXIMATION (EARTH)

(BACK)	(FRONT)	(BACK)	(FRONT)
5.95	184.81	50.5	184.81
7.0	185.63	9.0	185.43
7.65	185.84	9.65	185.41
7.65	186.50	9.65	185.90
5.95	187.50	5.95	186.92
5.95	187.81	5.95	187.81

AREA = 12.722 sqm      AREA = 10.579 sqm

204.30 GRAN BACKFILL FOR STRUCTURES


(BACK)	(FRONT)	(BACK)	(FRONT)
5.95	182.00	7.094	182.75
5.95	182.00	7.710	184.580
6.10	182.00	9.65	184.580
7.13	182.00	9.65	184.710
7.13	182.75	9.65	184.40
6.55	182.75	9.65	182.75
6.55	182.00	7.849	182.75
5.95	182.00	7.849	182.75

A1 = 1.45 sqm      A2 = 3.180 sqm  
1.774      AREA = 5.225 sqm

(BACK)	(FRONT)	(BACK)	(FRONT)
5.95	181.50	7.899	182.45
5.95	181.50	7.700	184.230
6.10	182.75	9.65	184.230
7.10	182.75	9.65	184.230
7.10	182.45	9.65	184.230
6.55	182.45	9.65	182.45
6.55	181.50	7.899	182.45
5.95	181.50	7.899	182.45

A1 = 1.799 sqm      A2 = 4.673 sqm  
AREA = 6.491 sqm

185  
184  
183  
182  
181  
180

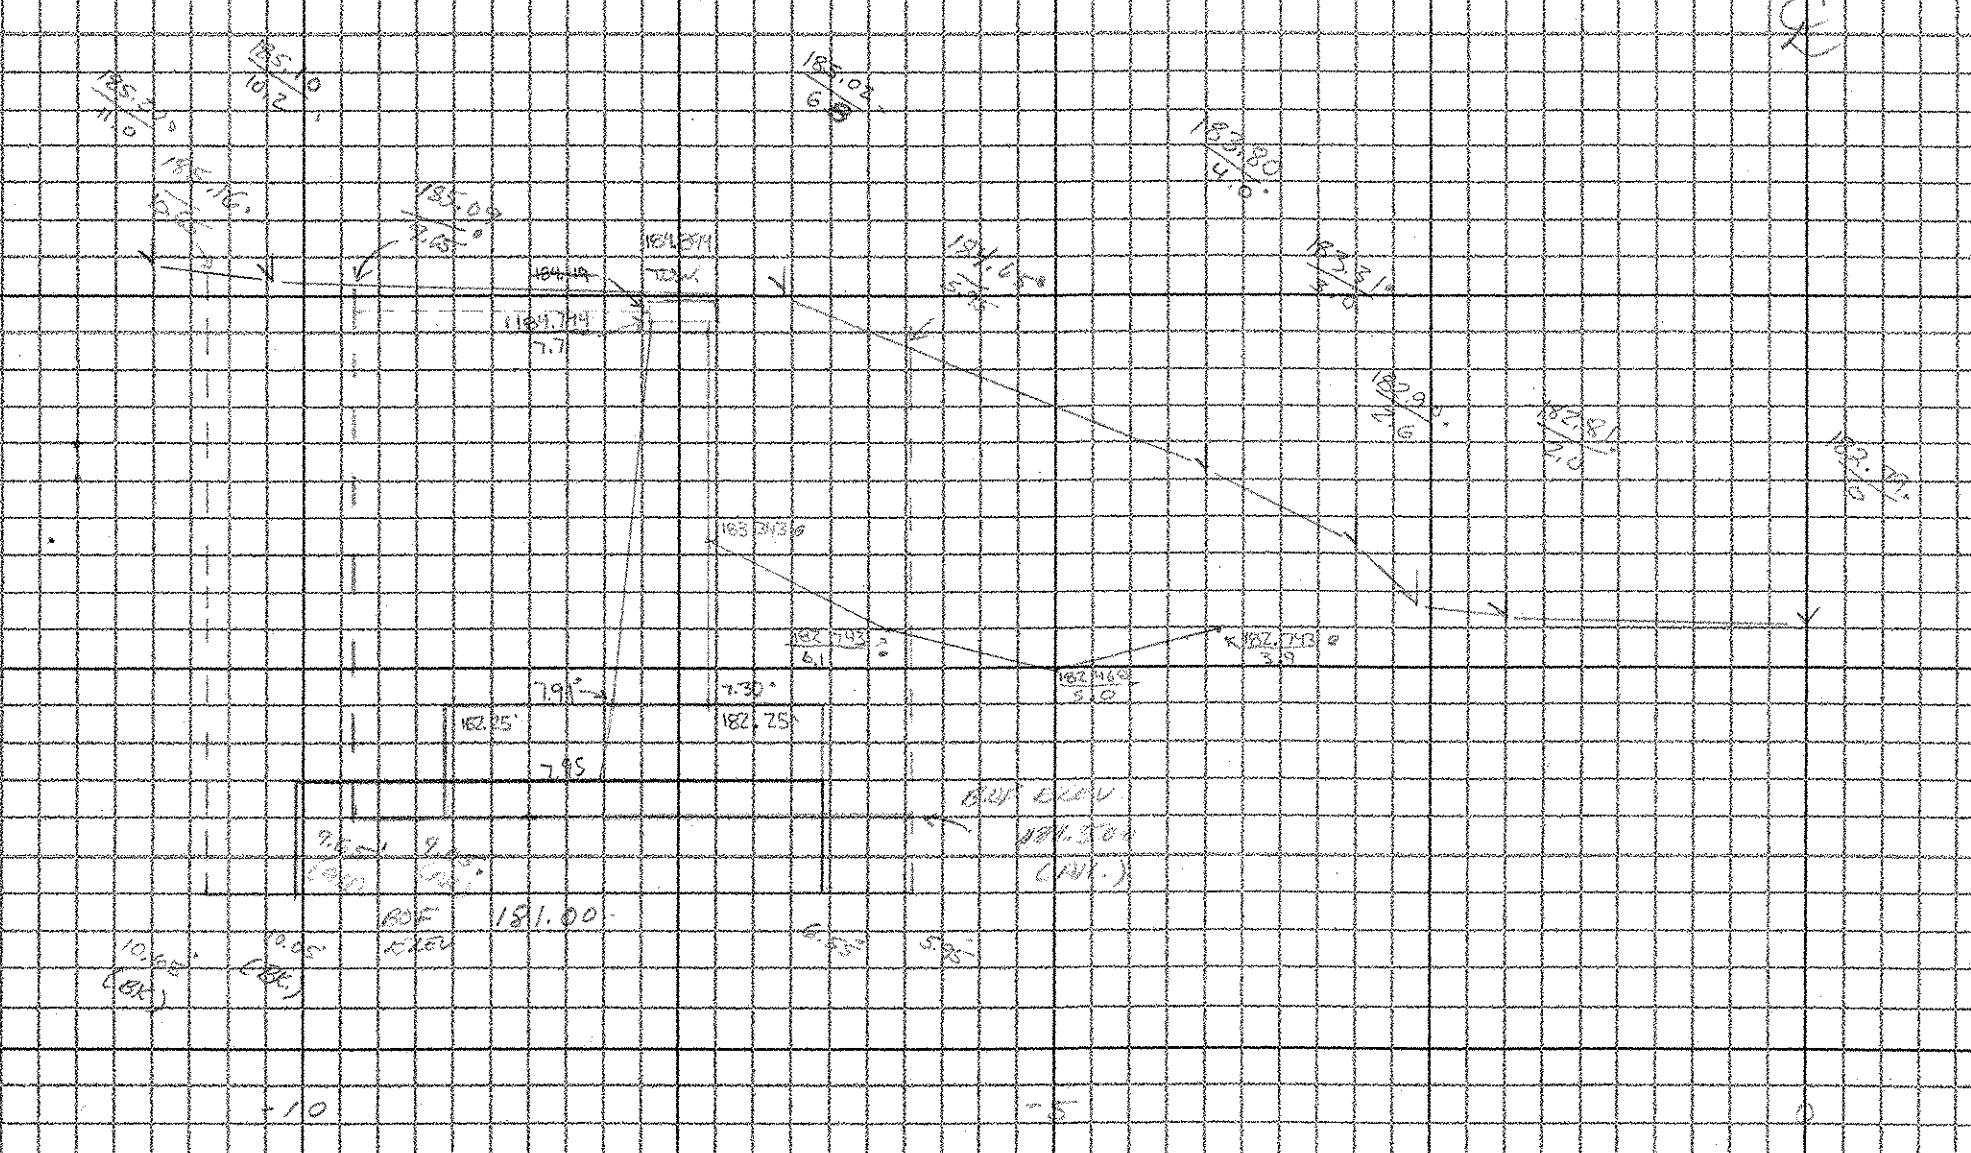

107.545

208.30 COFFER DAM APPROXIMATION (EARTH)

(BACK)	(FRONT)	(BACK)	(FRONT)
5.95	184.85	50.5	184.85
6.1	185.62	9.0	185.42
7.24	185.62	9.65	185.89
7.24	186.16	9.65	186.30
5.95	187.00	5.95	187.80
5.95	187.00	5.95	187.85

AREA = 13.222 sqm      AREA = 12.967 sqm

204.30 GRAN BACKFILL FOR STRUCTURES

(BACK)	(FRONT)	(BACK)	(FRONT)
5.95	181.50	9.65	181.50
5.95	181.70	9.65	181.50
6.10	182.743	9.65	182.25
7.10	182.743	7.91	182.25
7.10	182.75	7.70	184.744
6.55	182.75	9.65	184.744
6.55	181.50	9.65	181.50
5.95	181.50	9.65	181.50

A1 = 1.476 sqm      A2 = 5.05 sqm  
AREA = 6.52 sqm

(BACK)	(FRONT)	(BACK)	(FRONT)
5.95	181.00	10.05	181.00
5.95	182.75	10.05	181.75
6.10	182.75	7.75	181.75
7.10	182.75	7.70	181.75
7.10	182.75	10.65	181.75
6.55	181.75	10.65	181.00
6.55	181.00	10.65	181.00
5.95	181.00	10.65	181.00

A1 = 1.196 sqm      A2 = 5.91 sqm  
AREA = 10.87 sqm



# CROSS SECTION SHEET

PROJECT NAME: GENERAL ROCKINGHAM #2  
 PROJECT NUMBER: STP 0126 4(5)  
 FILE NAME: RETAINING WALL #3 PLOT DATE: 07-JUN-2000 13:  
 PROJECT LEADER: \_\_\_\_\_ DRAWN BY: C. GREENWOOD  
 DESIGNED BY: \_\_\_\_\_ CHECKED BY: \_\_\_\_\_  
 const: g:/common/cadd/m-xsection.dgn SHEET 3 OF 4