


DATE: _____
 BY: _____
 ORIGINAL SURVEY PLOTS
 NOTE BOOK TEMPLATE
 NO. _____
 AREA: _____

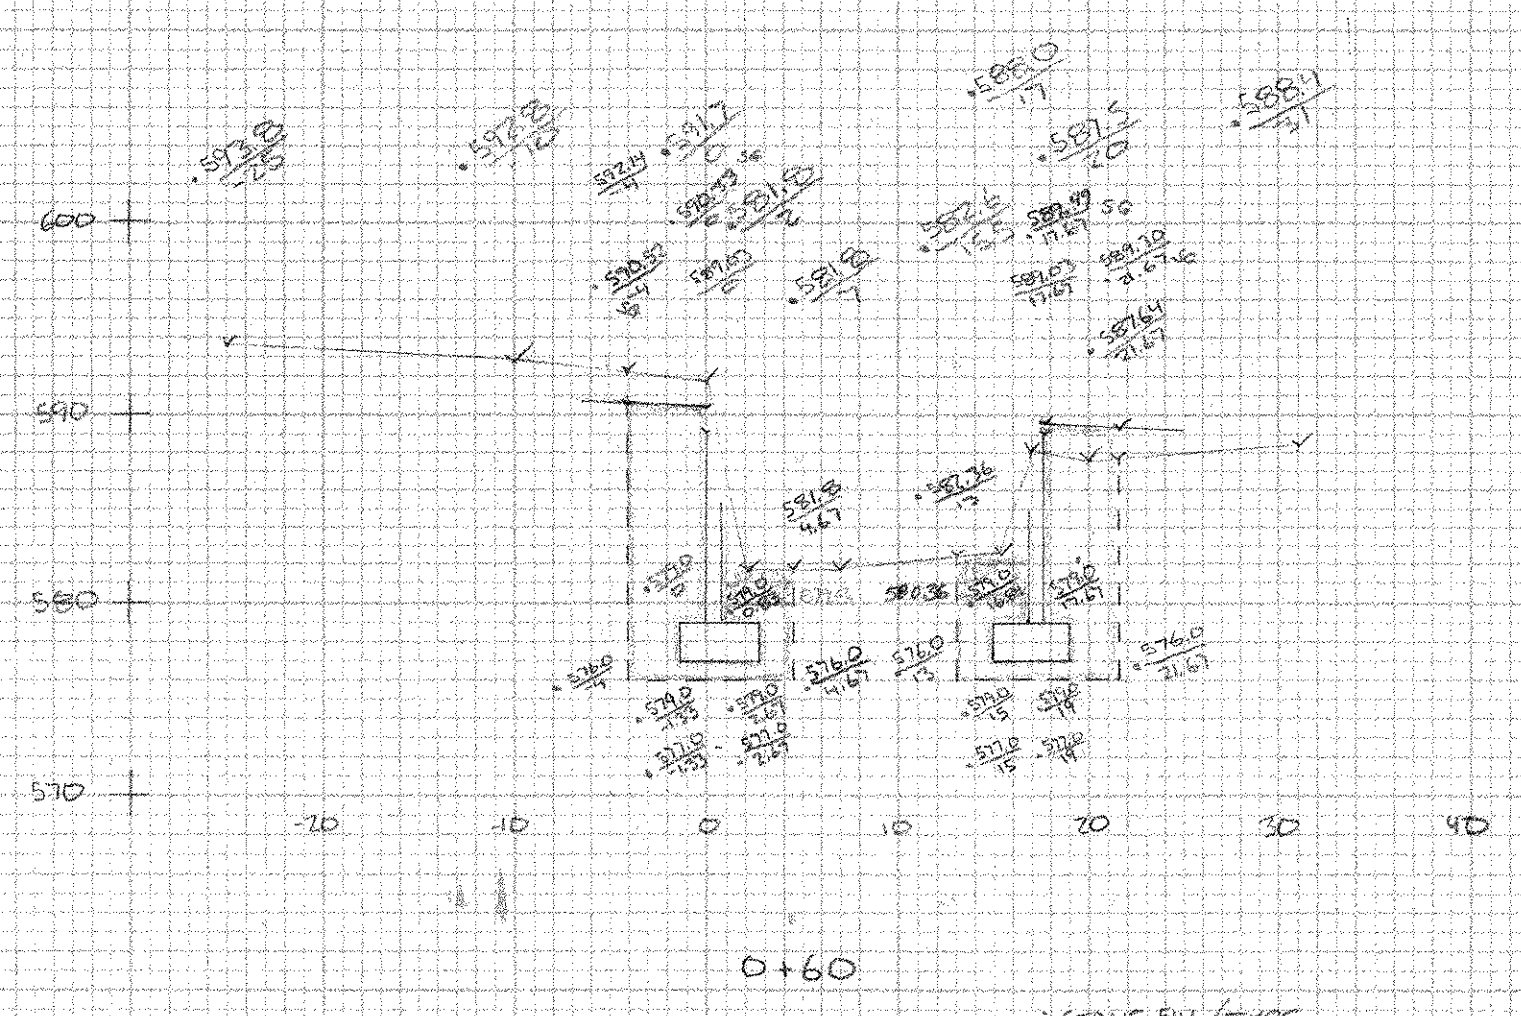

COFFERDAM, Exc.


108.30 LT		RT	
X	Y	X	Y
-4.0	576.0	15.0	576.0
-4.0	590.52	15.0	582.36
0	590.33	15.5	582.6
0	591.7	17.0	585.0
2.0	581.5	20.0	581.5
4.0	581.5	21.47	581.54
4.0	576.0	21.0	576.0
-4.0	576.0	15.0	576.0

AREA: 94.7 m²

204.30
 GRM. RAFL FOR STRUCT.

LT		RT	
X	Y	X	Y
-4.0	576.0	15.0	576.0
-4.0	590.52	15.0	582.36
0	590.33	16.84	582.36
0	579.0	16.84	579.0
-1.33	579.0	15.0	579.0
-1.33	577.0	15.0	577.0
2.47	577.0	18.0	577.0
2.47	579.0	18.0	579.0
0.83	579.0	17.47	579.0
0.83	579.0	17.47	579.0
4.47	579.0	21.47	579.0
4.47	576.0	21.47	576.0
-4.0	576.0	15.0	576.0

AREA: 66.78 m² AREA: 64.81 m²

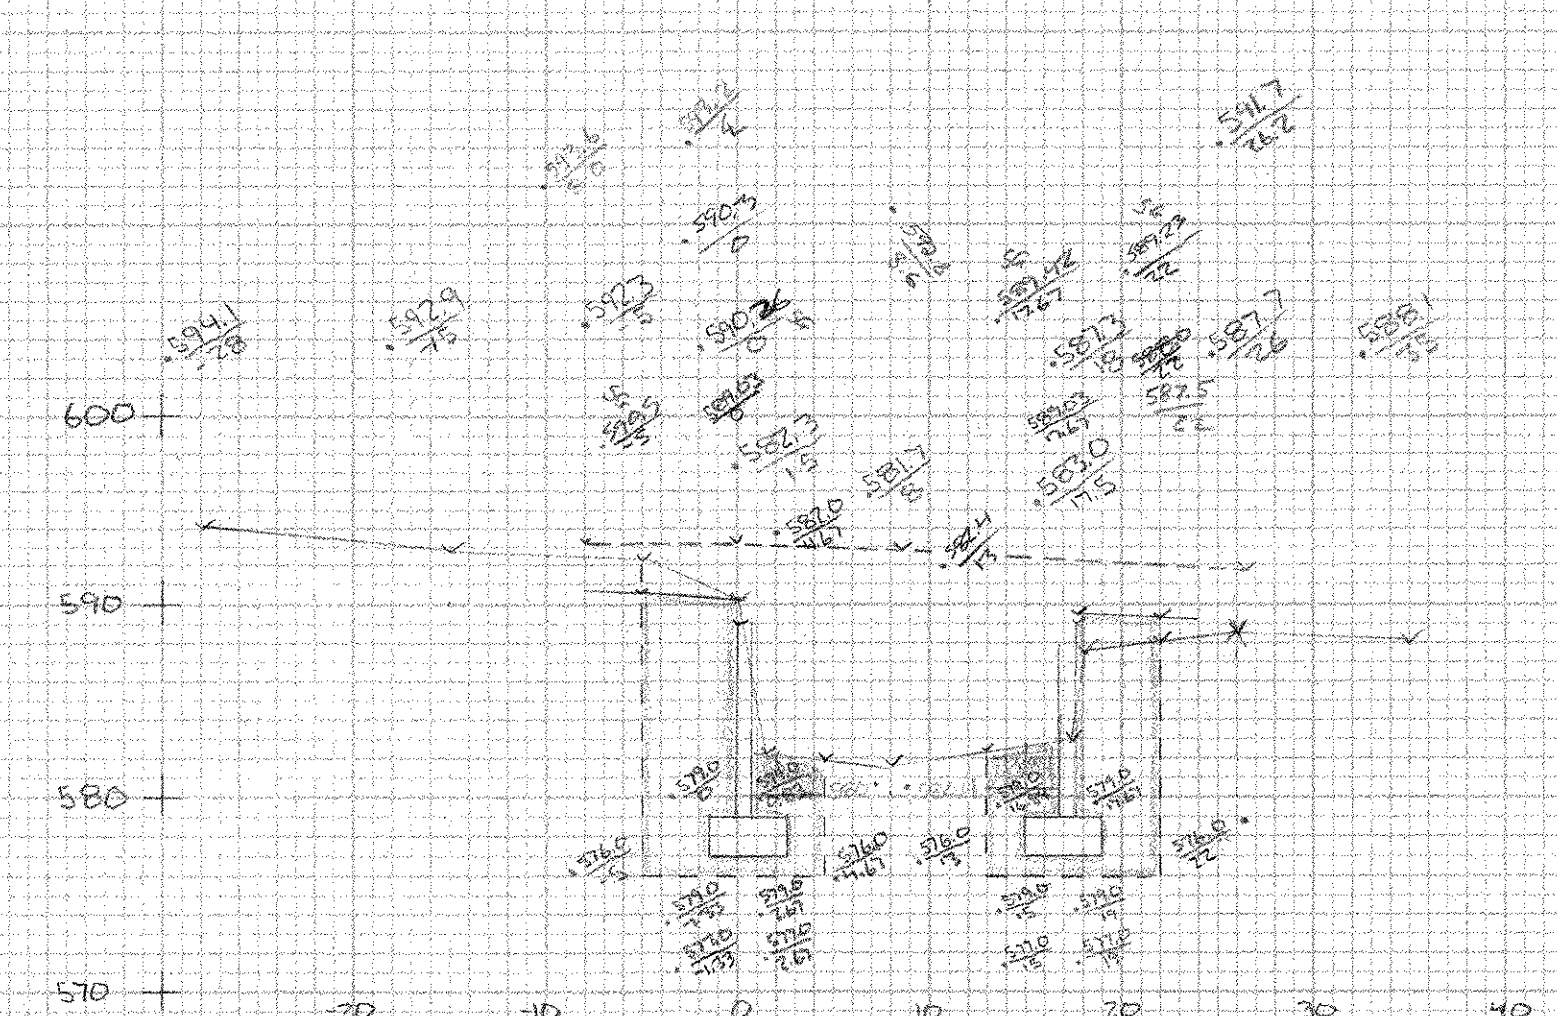

COFFERDAM, Exc.

108.30 LT		RT	
X	Y	X	Y
-4.0	576.0	15.0	576.0
-4.0	590.5	15.0	582.4
0	590.36	15.5	582.0
0	582.3	16.0	581.3
4.0	582.0	20.0	582.0
4.0	576.0	20.0	576.0
-4.0	576.0	15.0	576.0


AREA: 106.8 m²

204.30
 GRM. RAFL FOR STRUCT.

LT		RT	
X	Y	X	Y
-4.0	576.0	15.0	576.0
-4.0	590.5	15.0	582.4
0	590.36	16.84	582.4
0	579.0	16.84	579.0
-1.33	579.0	15.0	579.0
-1.33	577.0	15.0	577.0
2.47	577.0	18.0	577.0
2.47	579.0	18.0	579.0
0.83	579.0	17.47	579.0
0.83	579.0	17.47	579.0
4.47	579.0	21.47	579.0
4.47	576.0	21.47	576.0
-4.0	576.0	15.0	576.0

AREA: 80.3 m²

DATE: _____
 BY: _____
 ORIGINAL SURVEY PLOTS
 NOTE BOOK TEMPLATE
 NO. _____
 AREA: _____

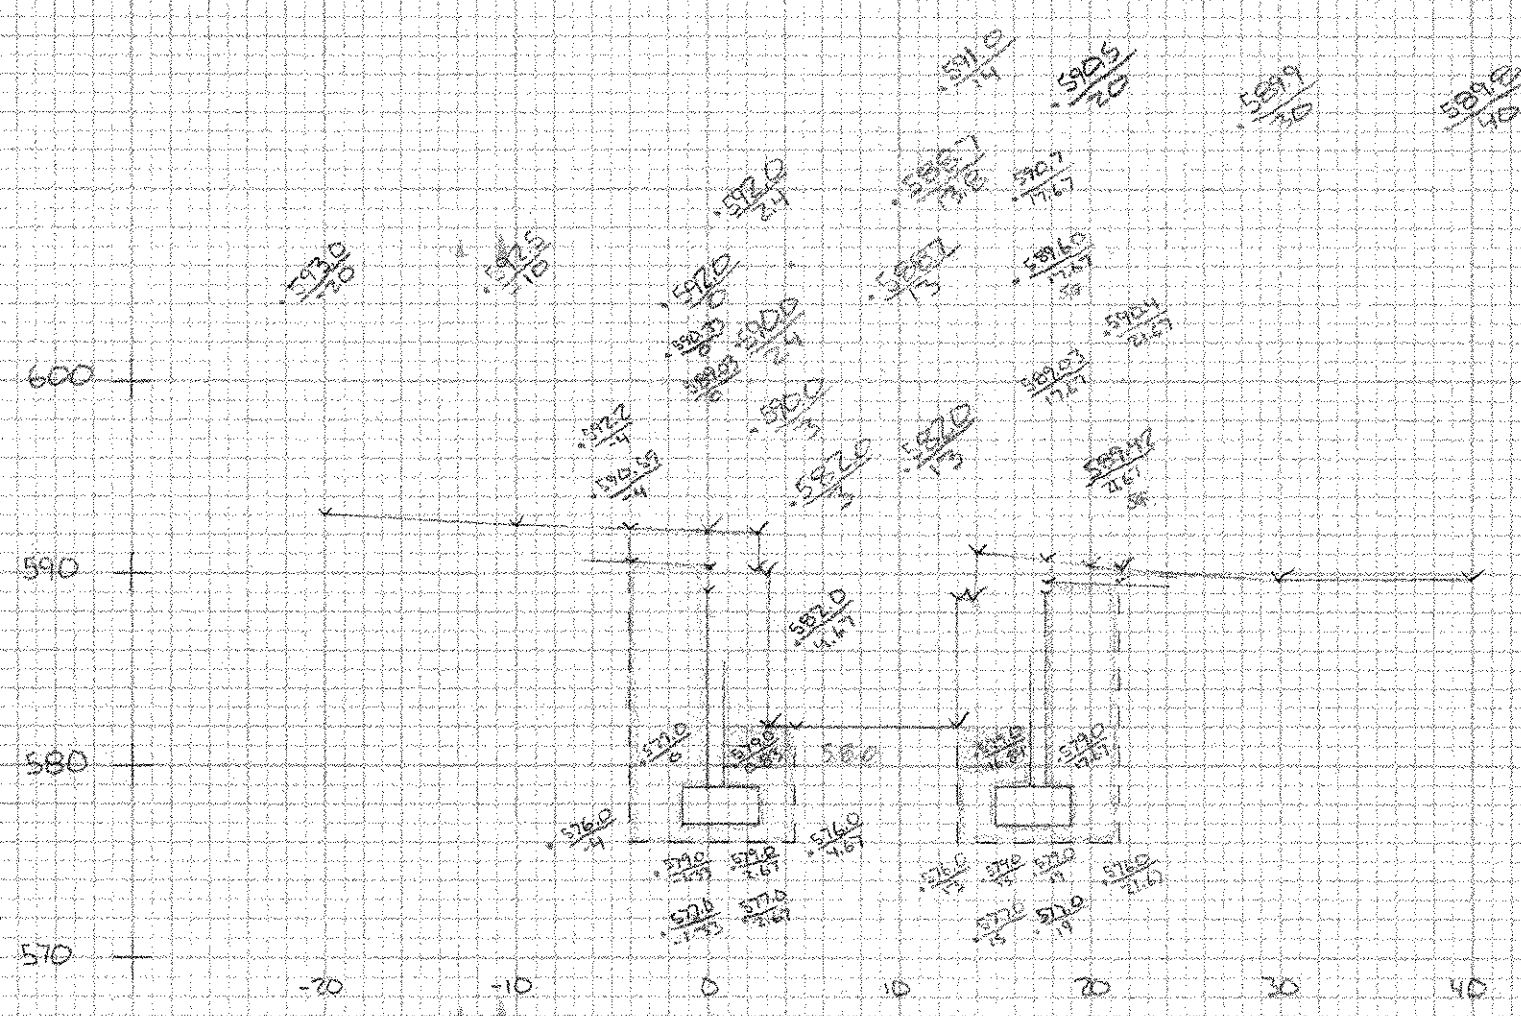

COFFERDAM, Exc.


108.30 LT		RT	
X	Y	X	Y
-4.0	576.0	15.0	576.0
-4.0	590.09	15.0	582.7
0	590.33	15.0	582.7
0	592.0	14.0	592.0
2.0	582.0	17.47	592.0
2.0	590.0	17.47	589.42
3.0	582.0	21.0	576.0
4.0	582.0	21.0	576.0
4.0	576.0	15.0	576.0
-4.0	576.0	15.0	576.0

AREA: 114.7 m²

204.30
 GRM. RAFL FOR STRUCT.

LT		RT	
X	Y	X	Y
-4.0	576.0	15.0	576.0
-4.0	590.09	15.0	582.7
0	590.33	16.84	582.7
0	579.0	16.84	579.0
-1.33	579.0	15.0	579.0
-1.33	577.0	15.0	577.0
2.47	577.0	18.0	577.0
2.47	579.0	18.0	579.0
0.83	579.0	17.47	579.0
0.83	580.0	17.47	589.42
4.47	580.0	21.47	589.42
4.47	576.0	21.47	576.0
-4.0	576.0	15.0	576.0

AREA: 67.89 m² AREA: 61.89 m²

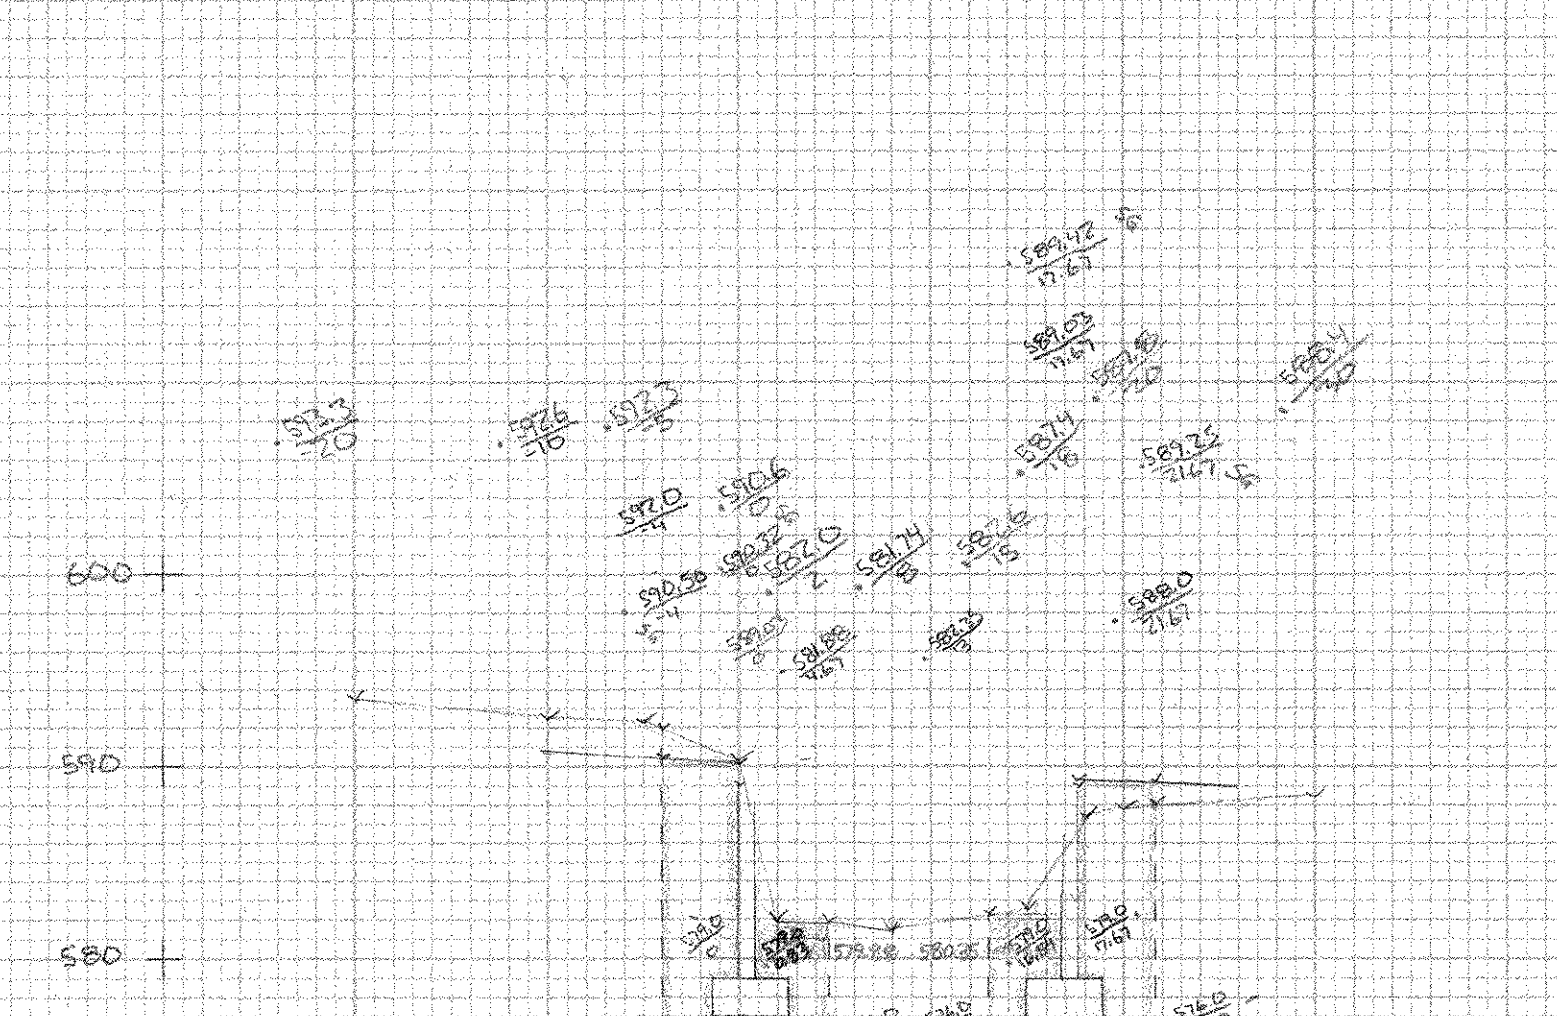

COFFERDAM, Exc.

108.30 LT		RT	
X	Y	X	Y
-4.0	576.0	15.0	576.0
-4.0	590.50	15.0	582.95
0	590.32	15.0	582.6
0	582.0	16.0	581.4
4.0	582.0	20.0	581.8
4.0	576.0	20.0	576.0
-4.0	576.0	15.0	576.0

AREA: 93.8 m²

204.30
 GRM. RAFL FOR STRUCT.

LT		RT	
X	Y	X	Y
-4.0	576.0	15.0	576.0
-4.0	590.50	15.0	582.95
0	590.32	16.84	582.95
0	579.0	16.84	579.0
-1.33	579.0	15.0	579.0
-1.33	577.0	15.0	577.0
2.47	577.0	18.0	577.0
2.47	579.0	18.0	579.0
0.83	579.0	17.47	579.0
0.83	580.0	17.47	589.42
4.47	580.0	21.47	589.42
4.47	576.0	21.47	576.0
-4.0	576.0	15.0	576.0

AREA: 67.03 m² AREA: 64.53 m²