


ORIGINAL	SURVEYED	BY	DATE
SURVEY	PLOTTED		
NOTE BOOK	TEMPLATE		
25646			

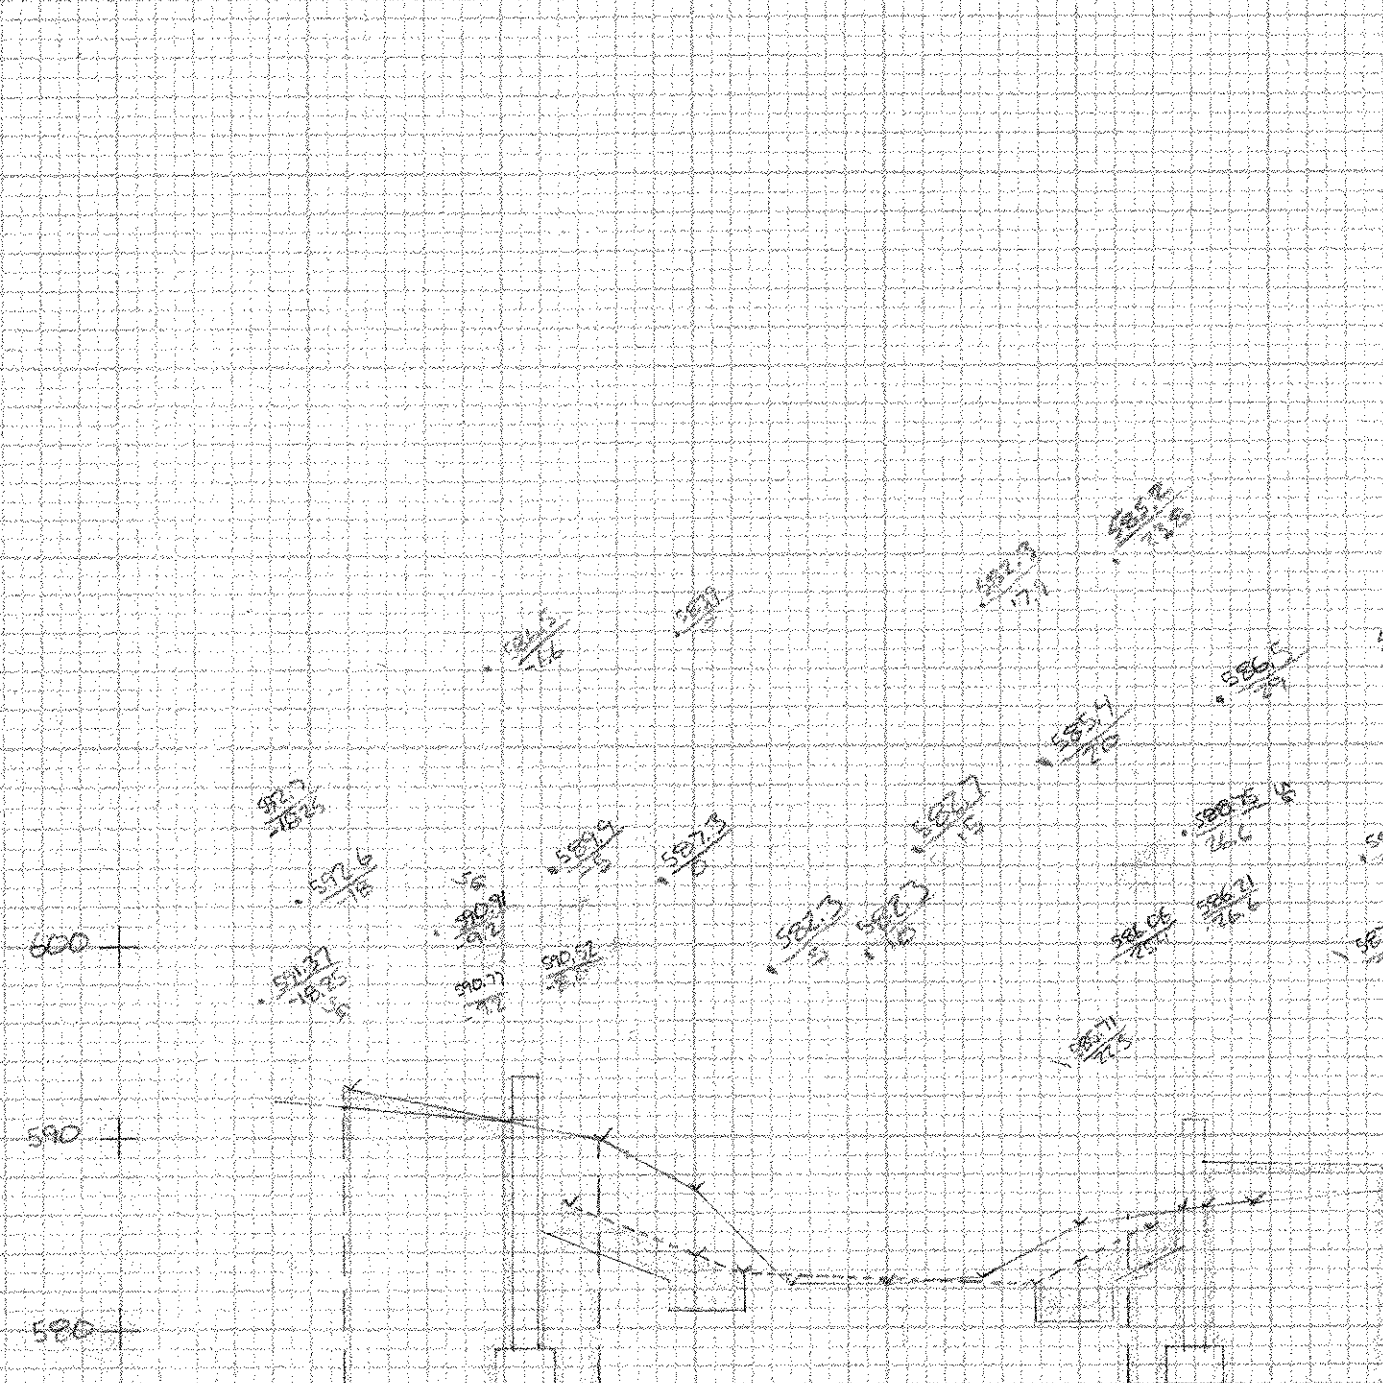

208.30: COFFERDAM EXC. EARTH

LT		RT	
X	Y	X	Y
-18.25	576.0	225	576.0
-16.5	582.7	225	585.11
-5.8	584.1	270	585.5
-5.0	576.0	260	587.2
-16.0	576.0	260	576.0
-16.0	576.0	225	576.0


AREA: 208.30 m^2
177.5

209.30: GRAIN BKR. FOR STRUCT.

LT		RT	
X	Y	X	Y
-18.25	576.0	260	576.0
-18.25	591.27	225	576.0
-9.2	590.91	225	582.6
-9.2	576.0	259	589.1
-10.3	576.0	254	579
-10.3	577.0	244	579
-7.05	577.0	236	577
-7.25	577.0	235	577
-8.8	578.0	225	579
-6.0	585.1	266	579
-5.0	593.9	216	588.75
-5.0	576.0	240	587.2
-18.5	576.0	260	576

AREA: 140.0 m^2


AREA: 134.7 m^2

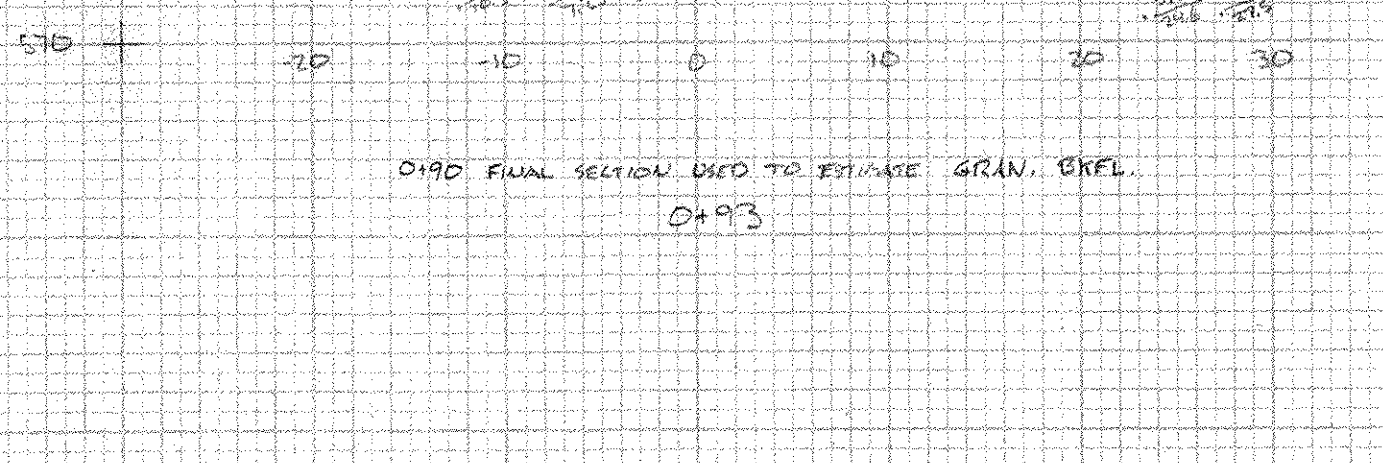

204.30' GRAN EXPL. FOR STPLCT.		RT	
X	Y	X	Y
-183.5	576.0	36.0	576.0
-182.5	591.3	22.5	576.0
-9.2	596.9	22.5	582.6
-4.2	579.0	15.4	584.1
-103	578.0	26.4	579
-103	577.0	24.4	579
-78.5	577.0	23.6	577
-72.5	577.0	23.5	577
-8.8	578.0	23.5	579
-60.0	585.1	26.6	579
-5.0	583.9	28.6	582.75
-5.0	576.0	34.0	587.2
-18.5	576.0	36.0	576

AREA 140.0m² ←

AREA 131.7 m² ✓

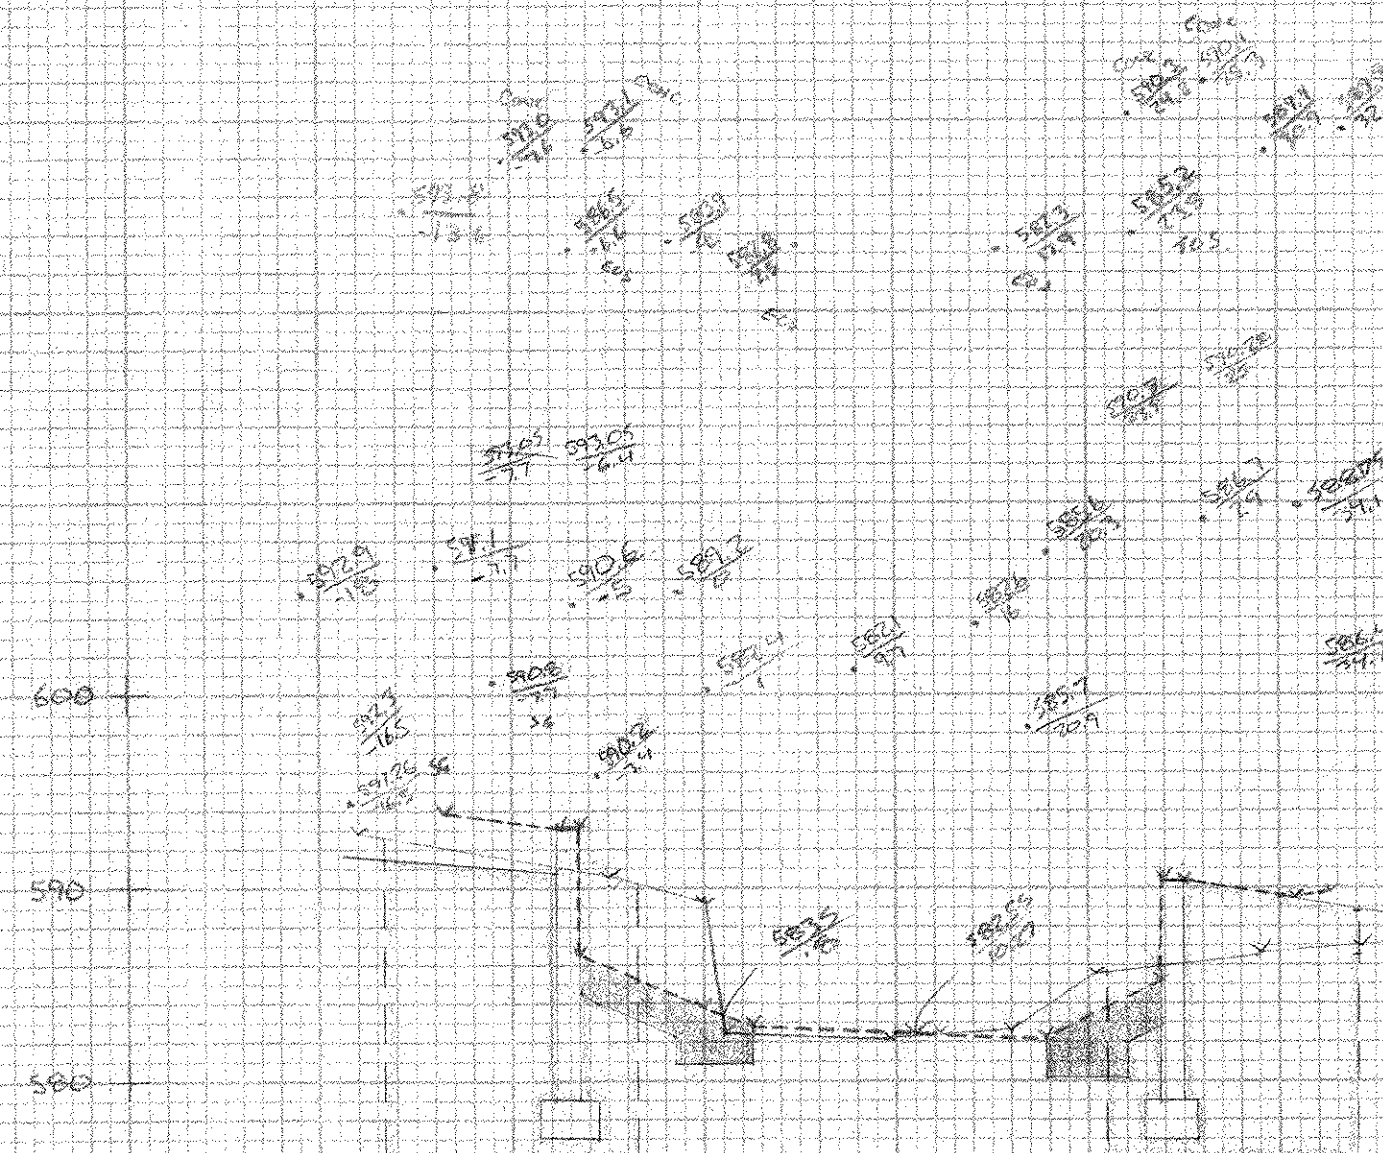

LOPPERDIAN EX. 4, EARTH

LT

X	Y
-46.5	576.0
-46.5	576.0
-32	576.8
-27	576.1
-9.8	576.6
-344	587.67
-3.4	576.2
-16.8	576.0

AREA = 194.5 m²

30. GRAY EXPL FOR STULTZ

LT


X	Y
-268	576
-105	580.5
-219	582.9
-510.6	576.3
-258	576.2
-25	579
-85	579
-68	577
-54	579
-64	579
-64	584.5
-234	585.2
-34	576

AREA = 593.9 m²

RT

X	Y
268	576
209	585.5
219	582.9
510.6	576.3
258	576.2
23	579
23	577
25.8	577
258	579
259	576.1
268	580.5
241	585.2

AREA = 132.5 m²

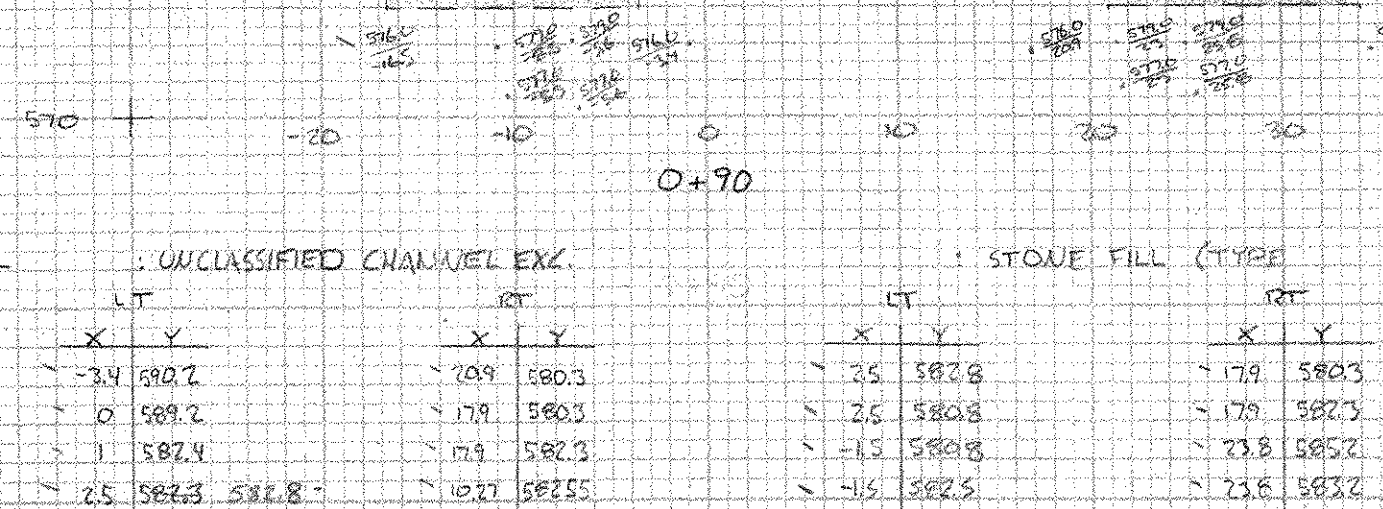[illegible]