

**Index of Sheets**

- 1. Title Sheet
- 2.-3. Quantity Sheets
- 4. Tie Sheet
- 5. Layout Sheet
- 6. Profile Sheet
- 7. Drainage Layout Sheet
- 8. Drainage Detail Sheet
- 9. Erosion Control Narrative
- 10. Erosion Control Site Plan
- 11.-12. Erosion Control Details
- 13. Signs & Pavement Markings
- 14. Traffic Sign Summary Sheet
- 15.-19. Sidewalk Cross Sections
- 20. Railroad Cross Sections
- 21. Railroad Crossing Details
- 22.-28. Traffic Control Sheets

**Standards**

- |        |  |                |
|--------|--|----------------|
| C-1    | Cast-in-Place Concrete Curb              | Jan. 3, 2000   |
| C-2a   | Portland Cement Conc. Sidewalk           | Oct. 14, 2005  |
| C-2b   | Portland Cement Conc. Sidewalk           | Oct. 14, 2005  |
| C-3a   | Sidewalk Ramps                           | Sept. 1, 2004  |
| C-3b   | Sidewalk Ramps                           | Sept. 1, 2004  |
| D-8    | Reinforced Concrete Drop Inlet           | Jan. 3, 2000   |
| D-9    | Reinforced Concrete Drop Inlet Tops      | June 1, 1994   |
| D-15   | Cast Iron Grate with Frame               | June 1, 1994   |
| D-30   | Underdrain Construction Details          | Aug. 13, 2007  |
| E-100a | Side Road Construction Approach Signs    | Jan. 2, 2004   |
| E-110  | Major Maintenance Operation Lane Closure | Sept. 8, 1995  |
| E-111  | Minor Maintenance Operation              | Mar. 11, 1997  |
| E-121  | Standard Sign Placement                  | Aug. 8, 1995   |
| E-123  | Guide Sign Placement                     | Mar. 16, 2004  |
| E-136b | State Route Marker Signs                 | Aug. 8, 1995   |
| E-143  | Regulatory Sign Details                  | June 15, 2004  |
| E-146  | Regulatory Sign Details                  | Sept. 20, 1995 |
| E-153b | Warning Sign Details                     | May 30, 2003   |
| E-160  | Flanged Channel Sign Posts               | May 20, 1999   |
| E-190  | Railroad Crossing Markings               | June 30, 2003  |
| E-191  | Pavement Marking Details                 | Feb. 1, 1999   |
| E-192  | Pavement Marking Details                 | Oct. 12, 2000  |
| E-193  | Pavement Marking Details                 | Aug. 18, 1995  |

**RECORD PLANS**

CONTRACTOR: J. P. SICARD, INC. - BARTON, VT  
 RESIDENT ENGINEER: PETER HODGSON  
 CONSTRUCTION BEGAN: JULY 9, 2008  
 CONSTRUCTION COMPLETE: NOVEMBER 12, 2008  
 RECORD PLANS BY: PETER HODGSON & C. PIERCE

I HEREBY CERTIFY THAT ALL THE CONSTRUCTION REQUIRED BY THIS SET OF DRAWINGS HAS BEEN ACCOMPLISHED AS INDICATED HEREIN.

BY *Peter Hodgson* RESIDENT ENGINEER  
 DATE 7/13/11



NOTE: Any further information concerning final quantities, amounts or other details relative to this project may be found at Central Files in the electronic archives.

STATE OF VERMONT  
 AGENCY OF TRANSPORTATION




PROPOSED IMPROVEMENT  
 SIDEWALK PROJECT  
 TOWN OF FAIRLEE  
 ORANGE COUNTY  
 VT. ROUTE 25A

WORK TO BE PERFORMED ON THIS PROJECT INCLUDES RECONSTRUCTION OF A NEW RAILROAD CROSSING AT DOT #053-563 Y, CONSTRUCTION OF A NEW CONCRETE SIDEWALK, AND INSTALLATION OF NEW DRAINAGE.

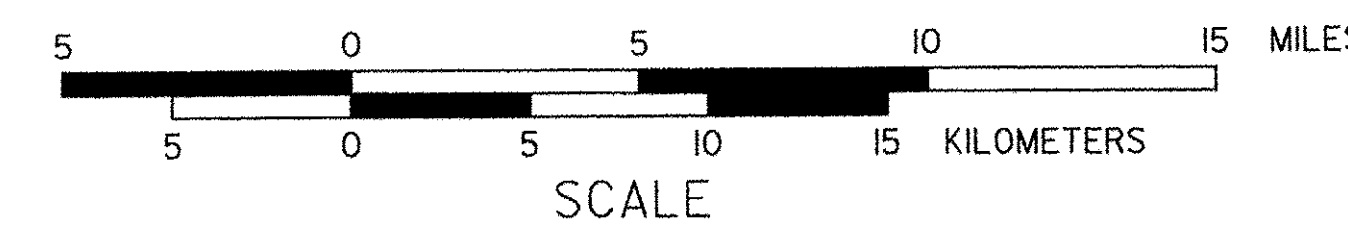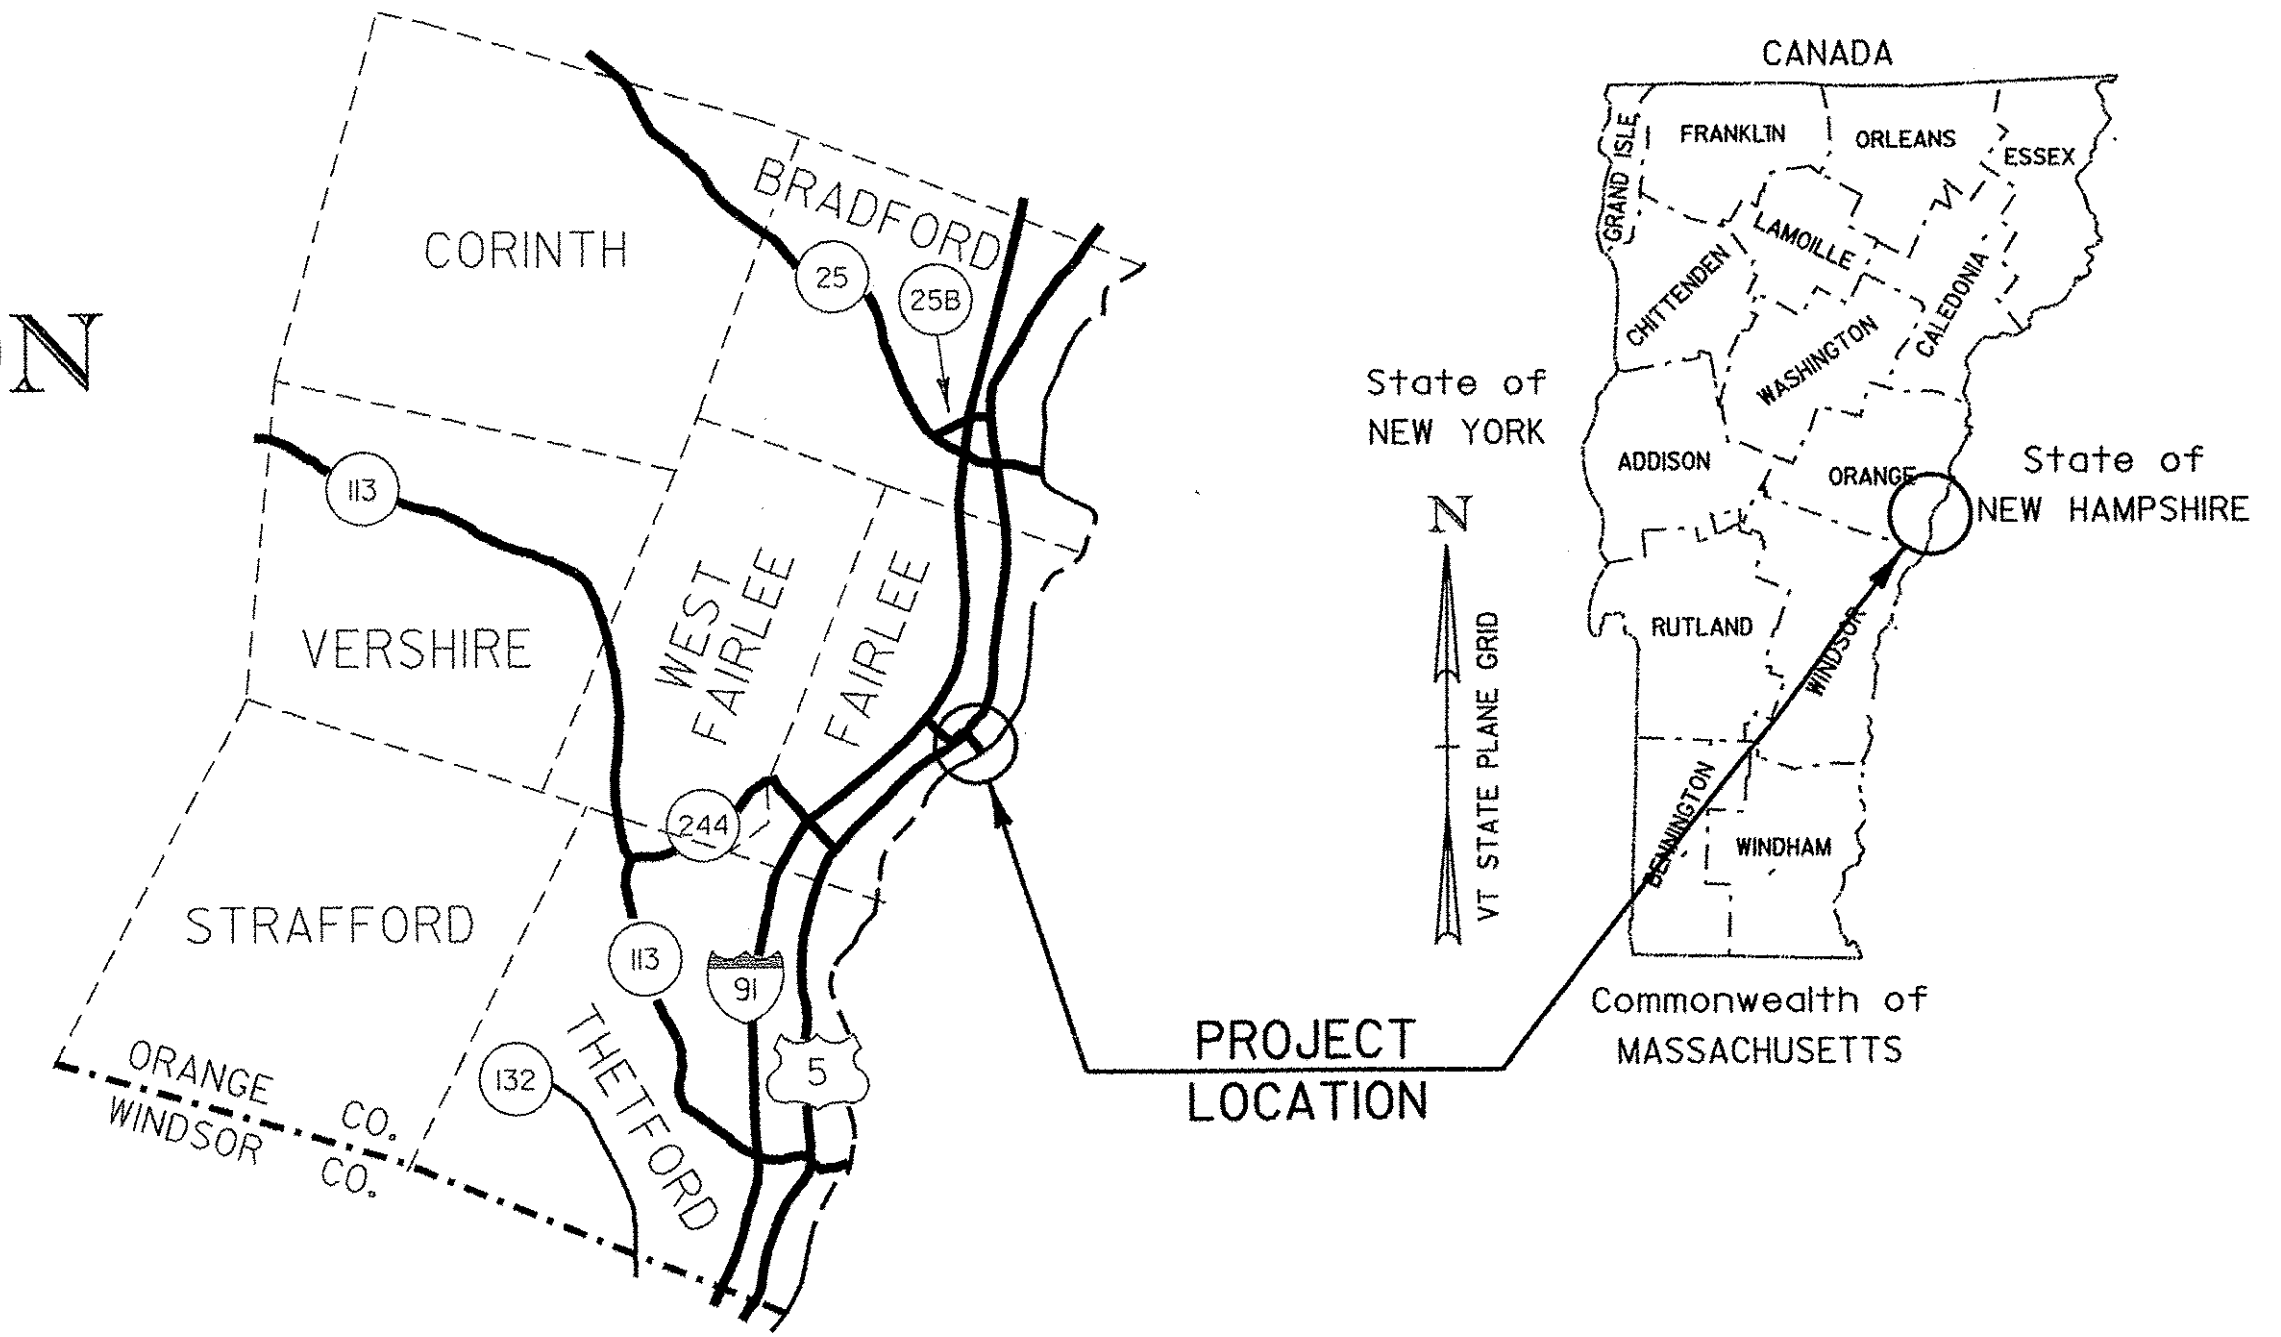

LENGTH OF RAILROAD BED RECONSTRUCTION = 80 FEET  
 LENGTH OF SIDEWALK = 350 FEET

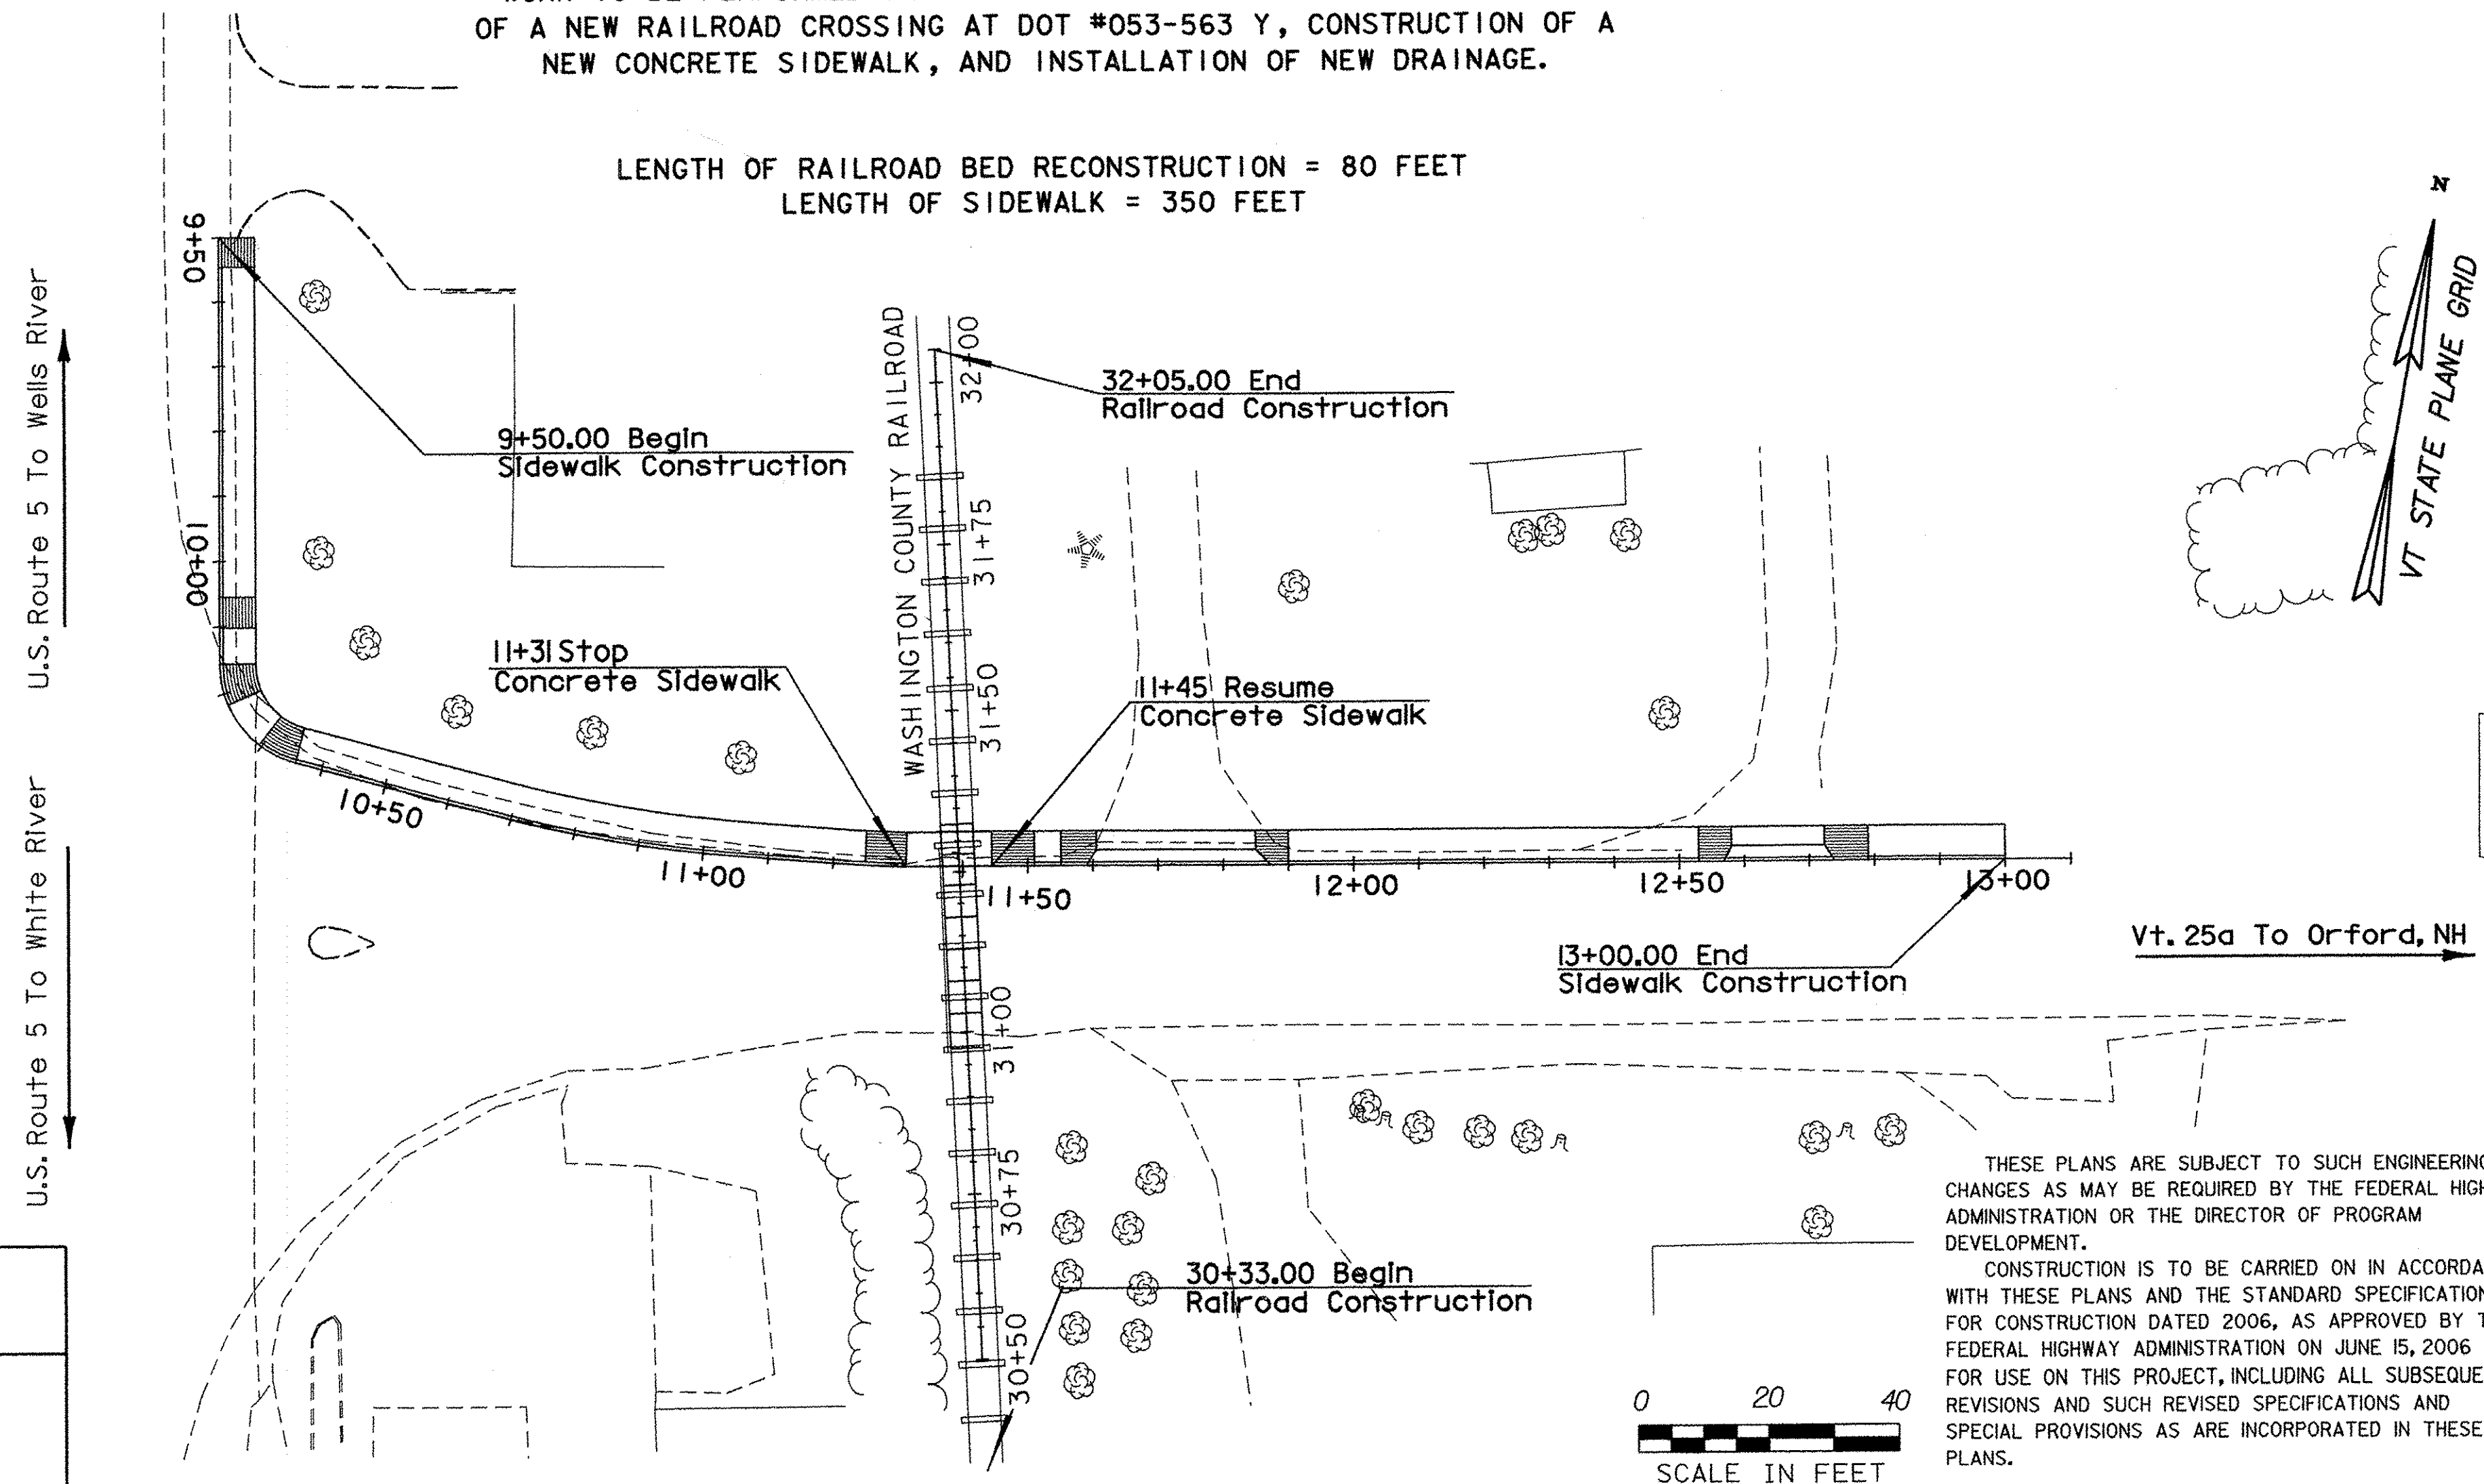

TRAFFIC DATA  
 VT 25A 2006 AADT 4000


FOR ADMINISTRATIVE PURPOSES, THE PPMS NUMBER FOR THIS PROJECT IS 02E060.  
 FOR ARCHIVING PURPOSES, AND RETRIEVAL OF CADD DRAWINGS, THE PPMS NUMBER IS 98B118.

THESE PLANS ARE SUBJECT TO SUCH ENGINEERING CHANGES AS MAY BE REQUIRED BY THE FEDERAL HIGHWAY ADMINISTRATION OR THE DIRECTOR OF PROGRAM DEVELOPMENT.  
 CONSTRUCTION IS TO BE CARRIED ON IN ACCORDANCE WITH THESE PLANS AND THE STANDARD SPECIFICATIONS FOR CONSTRUCTION DATED 2006, AS APPROVED BY THE FEDERAL HIGHWAY ADMINISTRATION ON JUNE 15, 2006 FOR USE ON THIS PROJECT, INCLUDING ALL SUBSEQUENT REVISIONS AND SUCH REVISED SPECIFICATIONS AND SPECIAL PROVISIONS AS ARE INCORPORATED IN THESE PLANS.

**CONVENTIONAL SYMBOLS**

COUNTY LINE	
TOWN LINE	
LIMITS OF ACCESS	
POINT OF ACCESS	
FENCE LINE	
STONE WALL	
TRAVELED WAY	
GUARD RAIL	
RAILROAD	
SURVEY LINE	
CULVERT	
POWER POLE	
TELEPHONE POLE	
TREES	
CONTROL OF ACCESS	
PROPERTY LINE	
R.O.W. TAKING LINE	
SLOPE RIGHTS	
TOP OF CUT	
TOE OF SLOPE	

SURVEYED BY: VAO  
 SURVEYED DATE: SEPT. 2001  
 DATUM  
 VERTICAL: NAVD 88  
 HORIZONTAL: ASSUMED

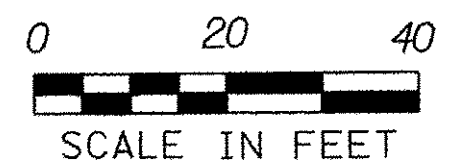

DIRECTOR OF PROGRAM DEVELOPMENT  
 APPROVED *Peter Hodgson* DATE 5/7/08  
 PROJECT MANAGER: JON KAPLAN  
 PROJECT NAME: Fairlee  
 PROJECT NUMBER: STP 040-1(2)  
 SHEET 1 OF 28 SHEETS