
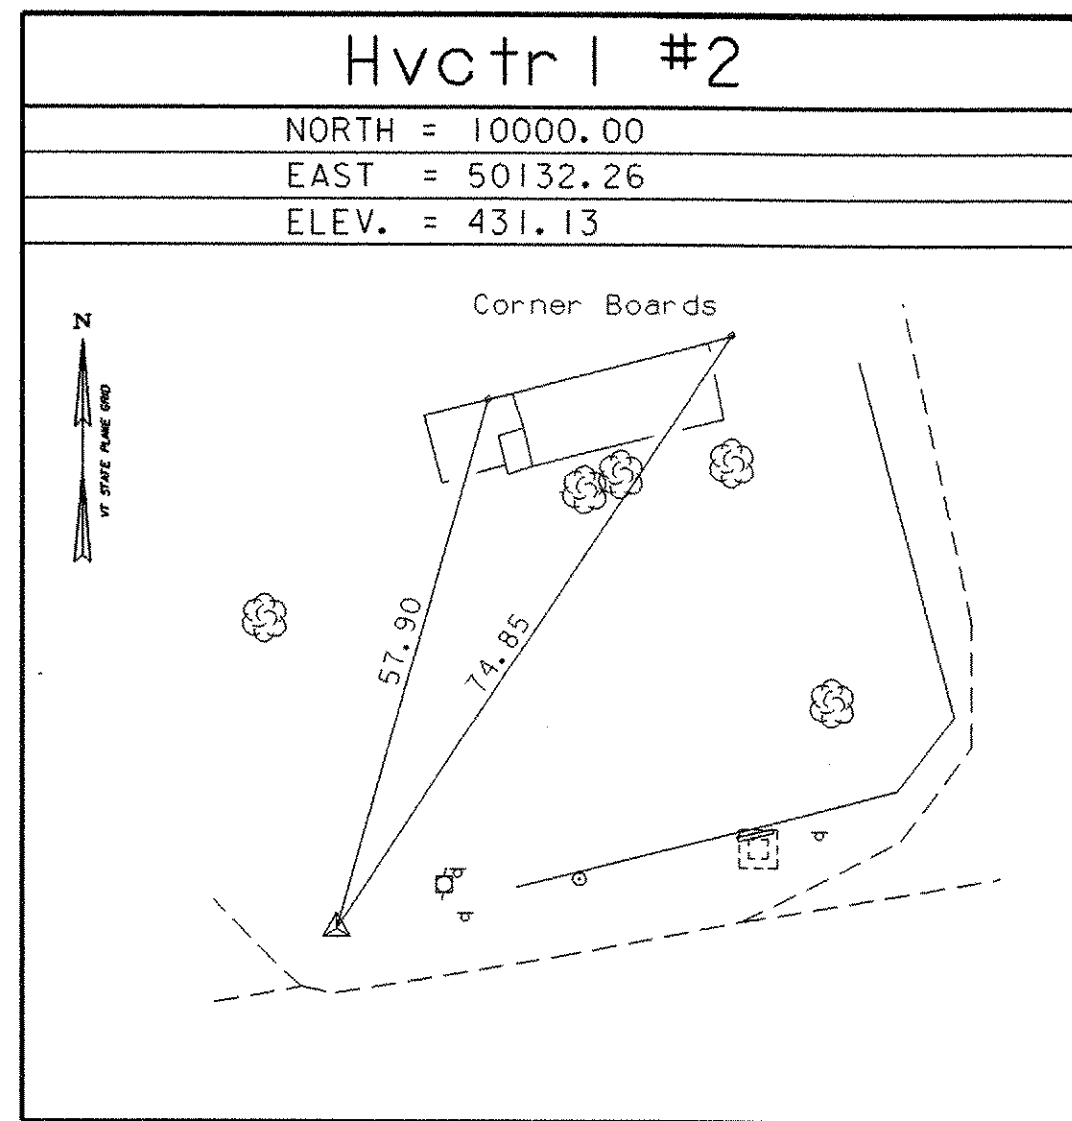


GPS CONTROL POINTS

TRAVERSE TIES

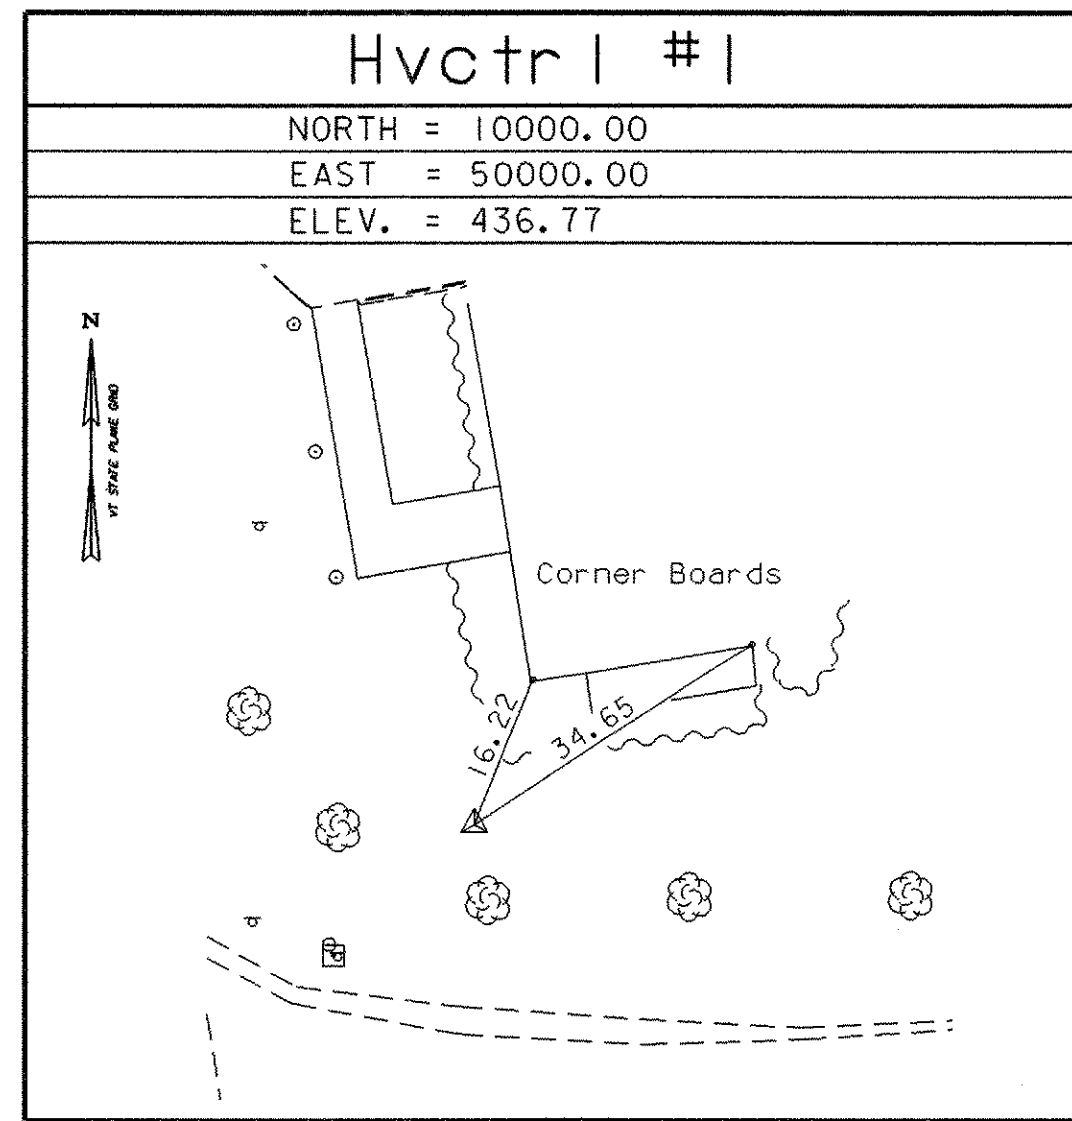

NORTH =
EAST =
ELEV. =

NORTH =
EAST =
ELEV. =

NORTH =
EAST =
ELEV. =

• MAIN TRAVERSE COMPLETED 9/14/01 by R. Gilman P.C. & P. Winters

ALIGNMENT TIES

NORTH =
EAST =

NORTH =
EAST =

**TIE SHEET**

<b>DATUM</b>	
VERTICAL	NAVD 88
HORIZONTAL	Assumed
ADJUSTMENT	none

PROJECT NAME:	FAIRLEE
PROJECT NUMBER:	STP 040-I(2)
FILE NAME: 98b118/survey/xbl18+1.dgn	PLOT DATE: 07-MAY-2008
PROJECT LEADER: J. KAPLAN	DRAWN BY: R. Bullock
DESIGNED BY: G. SHANGRAW	CHECKED BY: J. KAPLAN
	SHEET 4 OF 28