


SIDEWALK CROSS SECTIONS

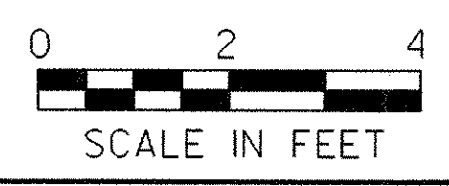

PROJECT NAME:	FAIRLEE
PROJECT NUMBER:	STP 040-1 (2)
FILE NAME: STPr5\98b118\sb118xs.dgn	PLOT DATE: 07-MAY-2008
PROJECT LEADER: J. Kaplan	DRAWN BY: G. Shangraw
DESIGNED BY: G. Shangraw	CHECKED BY: J. Kaplan
Sb118XS2.i	SHEET 16 OF 28