

NH
ROUTE
10 NORTH

LYME

NEW
ORFORD NH
DETOUR
↑

NEW
DETOUR

NORTH 10 SOUTH
↑ ORFORD HANOVER →


NEW
DETOUR

NORTH 10
← ORFORD
← PIERMONT
LYME CTR. ↑

EAST
THETFORD
ROAD

NH
ROUTE
10 SOUTH

DORCHESTER
ROAD TO
LYME CENTER

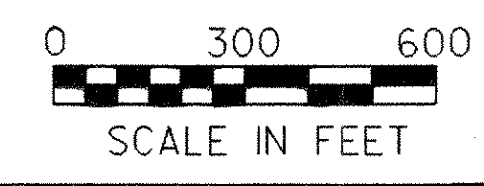

TRAFFIC CONTROL SHEET #4

PROJECT NAME: FAIRLEE	PLOT DATE: 07-MAY-2008
PROJECT NUMBER: STP 040-1(2)	DRAWN BY: G. SHANGRAW
FILE NAME: 98b118/detourbasemap.dgn	CHECKED BY: TRAFFIC OPS
DESIGNED BY: G. SHANGRAW	SHEET 25 OF 28