


**LEGEND**

TOPSOIL, SEED & HAY MULCH, TYP. WIDTH 4'-6'	STEEP SLOPE
GEOTEXTILE FOR SILT FENCE	NEW LIGHT POLE AND LUMINAIRE
LIMITS OF CONSTRUCTION	UNDERGROUND TELEPHONE
APPROX. R.O.W. LINE	EXISTING CONTOURS
APPROX. PROPERTY LINE	

LINES SHOWN ON THIS PLAN AS EXISTING PROPERTY LINES (P/L) ARE BELIEVED TO BE ACCURATE BUT SHOULD NOT BE RELIED UPON FOR PURPOSES UNRELATED TO THE STATE OF VERMONT'S ACQUISITION OF LAND AND RIGHTS FOR THIS PROJECT.

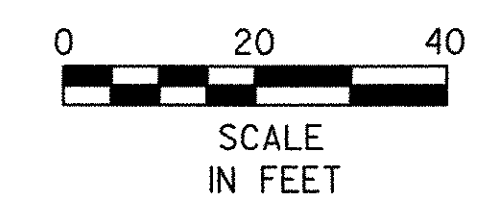

PROJECT NAME: BARRE TOWN PARK-AND-RIDE	
PROJECT NUMBER: CMG PARK (24) S	
FILE NAME: ...Trans\PlotFiles\03 row01.ptf	PLOT DATE: 4/4/2006
PROJECT LEADER: GAS	DRAWN BY: SRZ
DESIGNED BY: SRZ	CHECKED BY: GAS
<b>RIGHT-OF-WAY PLAN</b>	
SHEET 3 OF 14	