

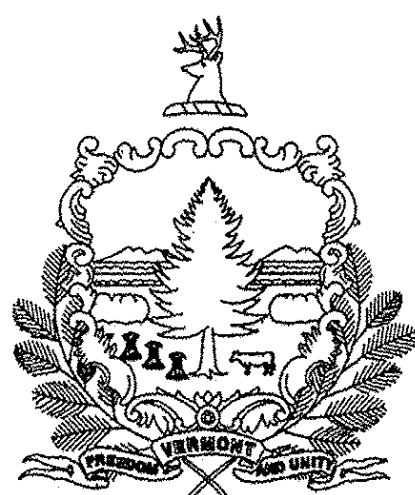


STATE OF VERMONT AGENCY OF TRANSPORTATION

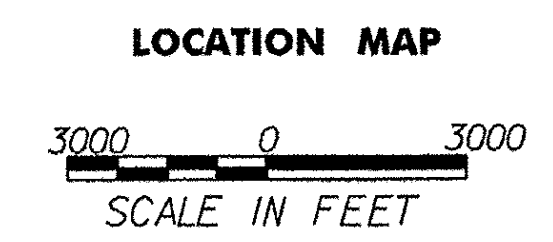

PROPOSED IMPROVEMENT TOWN OF HARTLAND COUNTY OF WINDSOR HARTLAND PARK AND RIDE

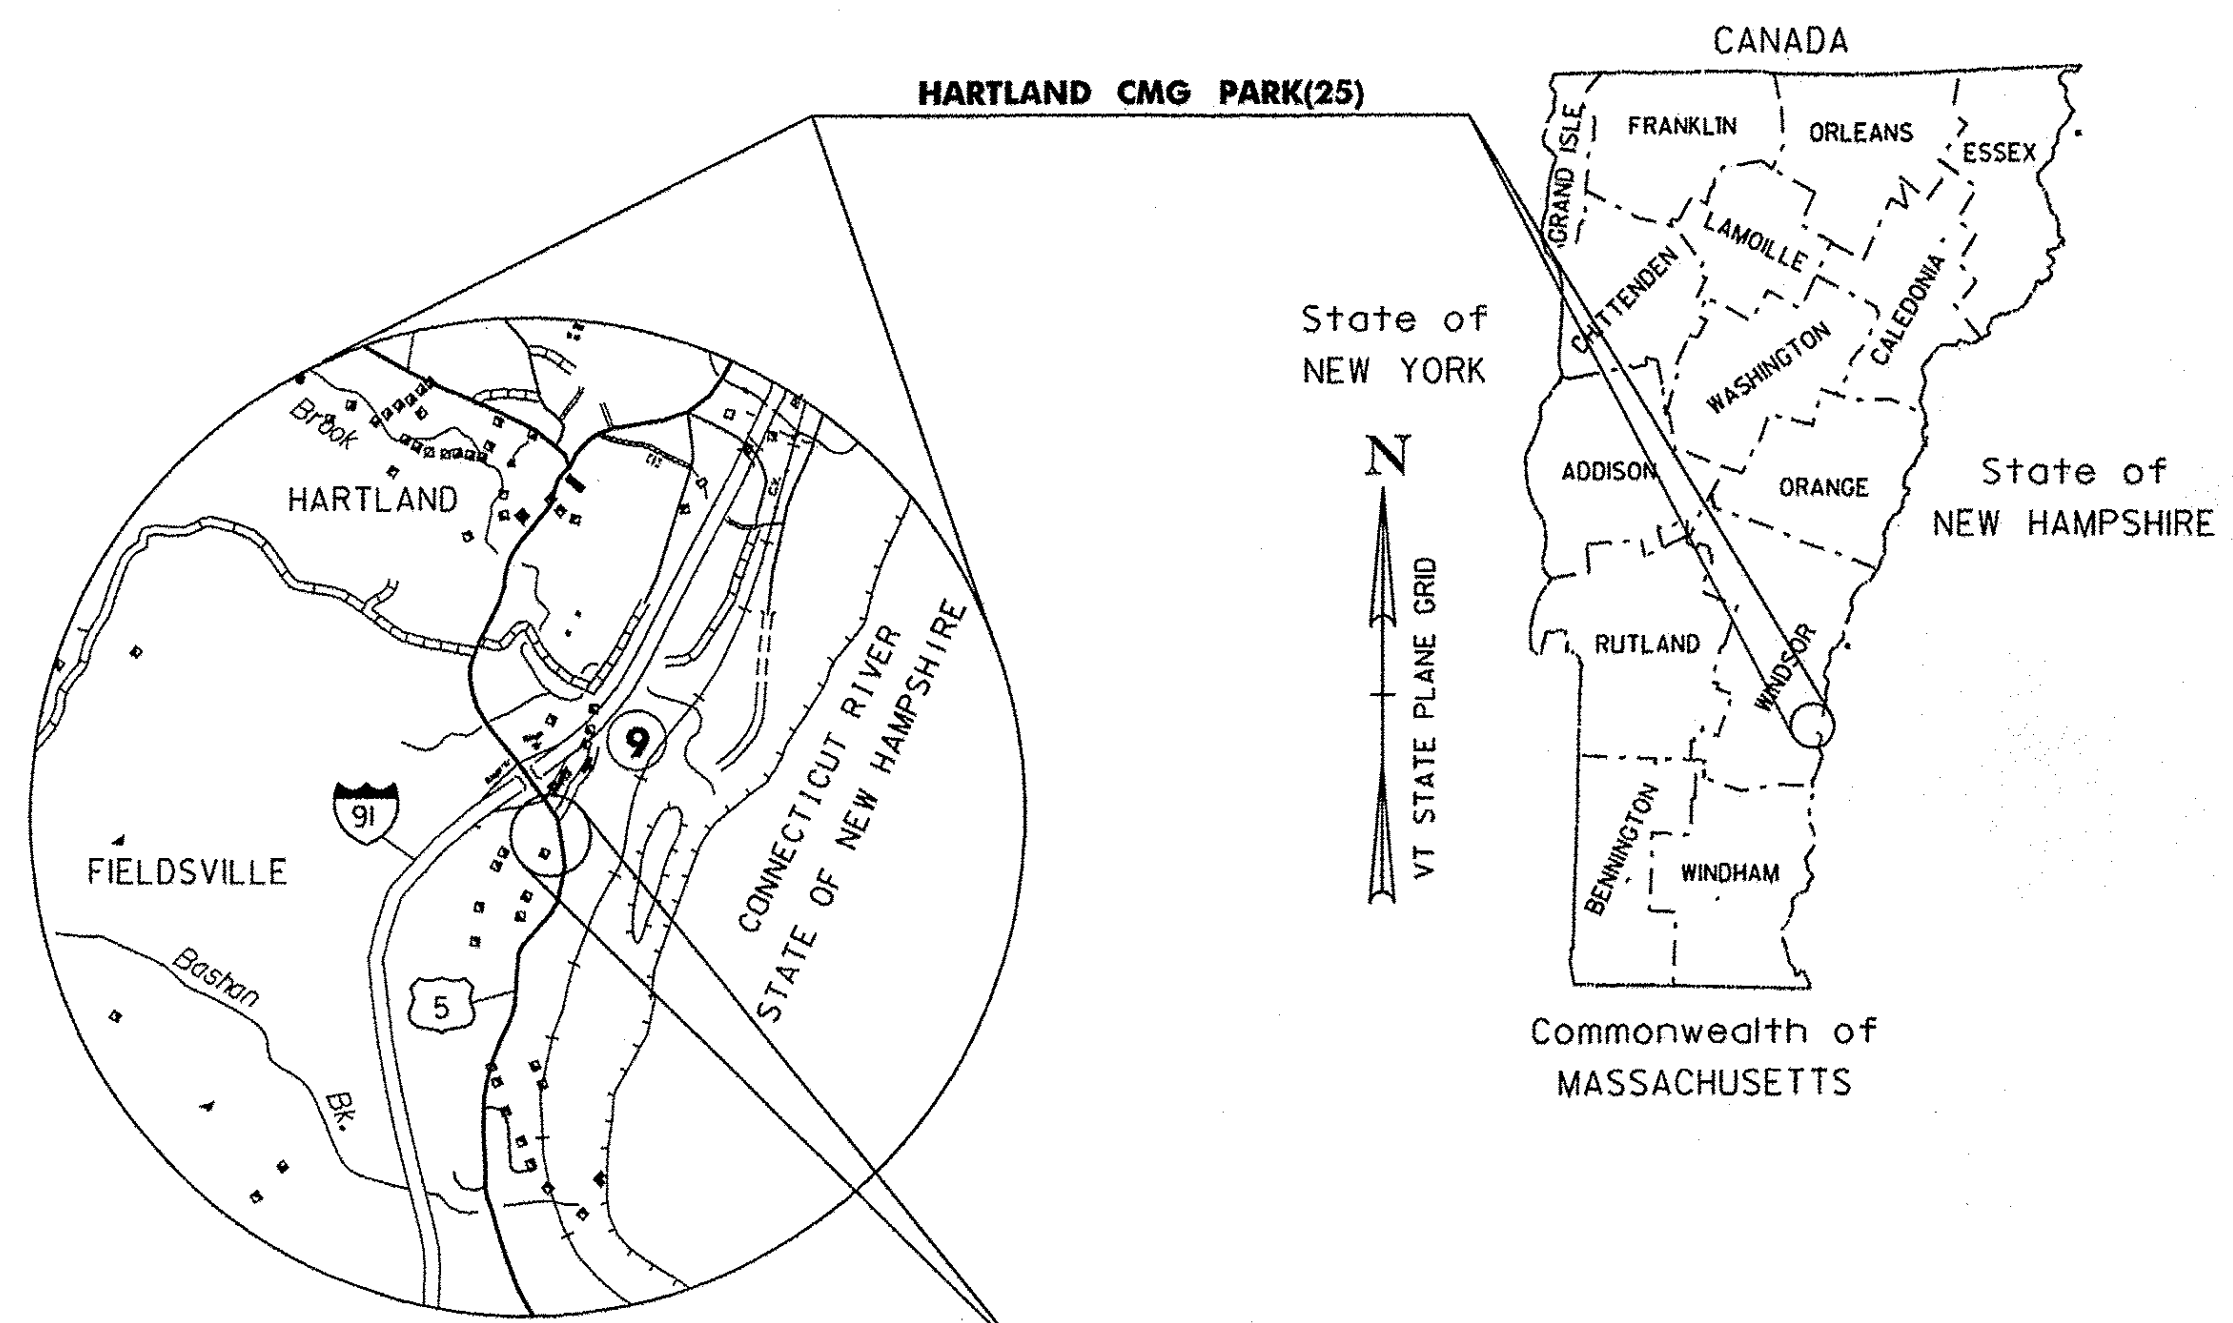

PROJECT LOCATION



RECORD PLANS	
CONTRACTOR:	CAPITAL EARTHMOVING, INC. - BARRE, VT
RESIDENT ENGINEER:	CHARLIE HARDING
CONSTRUCTION BEGAN:	APRIL 28, 2014
CONSTRUCTION COMPLETE:	OCTOBER 1, 2014
RECORD PLANS BY:	CHARLIE HARDING & CRAIG PIERCE
I HEREBY CERTIFY THAT ALL THE CONSTRUCTION REQUIRED BY THIS SET OF DRAWINGS HAS BEEN ACCOMPLISHED AS INDICATED HEREIN.	
BY	<i>Charlie Harding</i> RESIDENT ENGINEER
DATE	02-24-16
NOTE: Any further information concerning final quantities, amounts or other details relative to this project may be found at Central Files in the electronic archives.	

PROJECT LOCATION : THIS PROJECT IS LOCATED ON THE SOUTHERN SIDE OF US ROUTE 5, 200 FEET EAST OF THE INTERSTATE 91, EXIT 9 INTERCHANGE.

PROJECT DESCRIPTION : WORK TO BE PERFORMED UNDER THIS PROJECT INCLUDES THE RECONSTRUCTION AND EXPANSION OF THE EXISTING PARK-AND-RIDE FACILITY, INCLUDING NEW SUBBASE, PAVEMENT, MARKINGS, SIGNAGE, LIGHTING, LANDSCAPING AND OTHER HIGHWAY RELATED ITEMS.

LENGTH OF PROJECT : 214.50 FEET (0.041 MI)

PROPOSED PARK-AND-RIDE EXPANSION

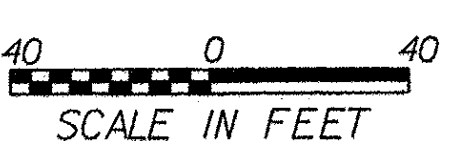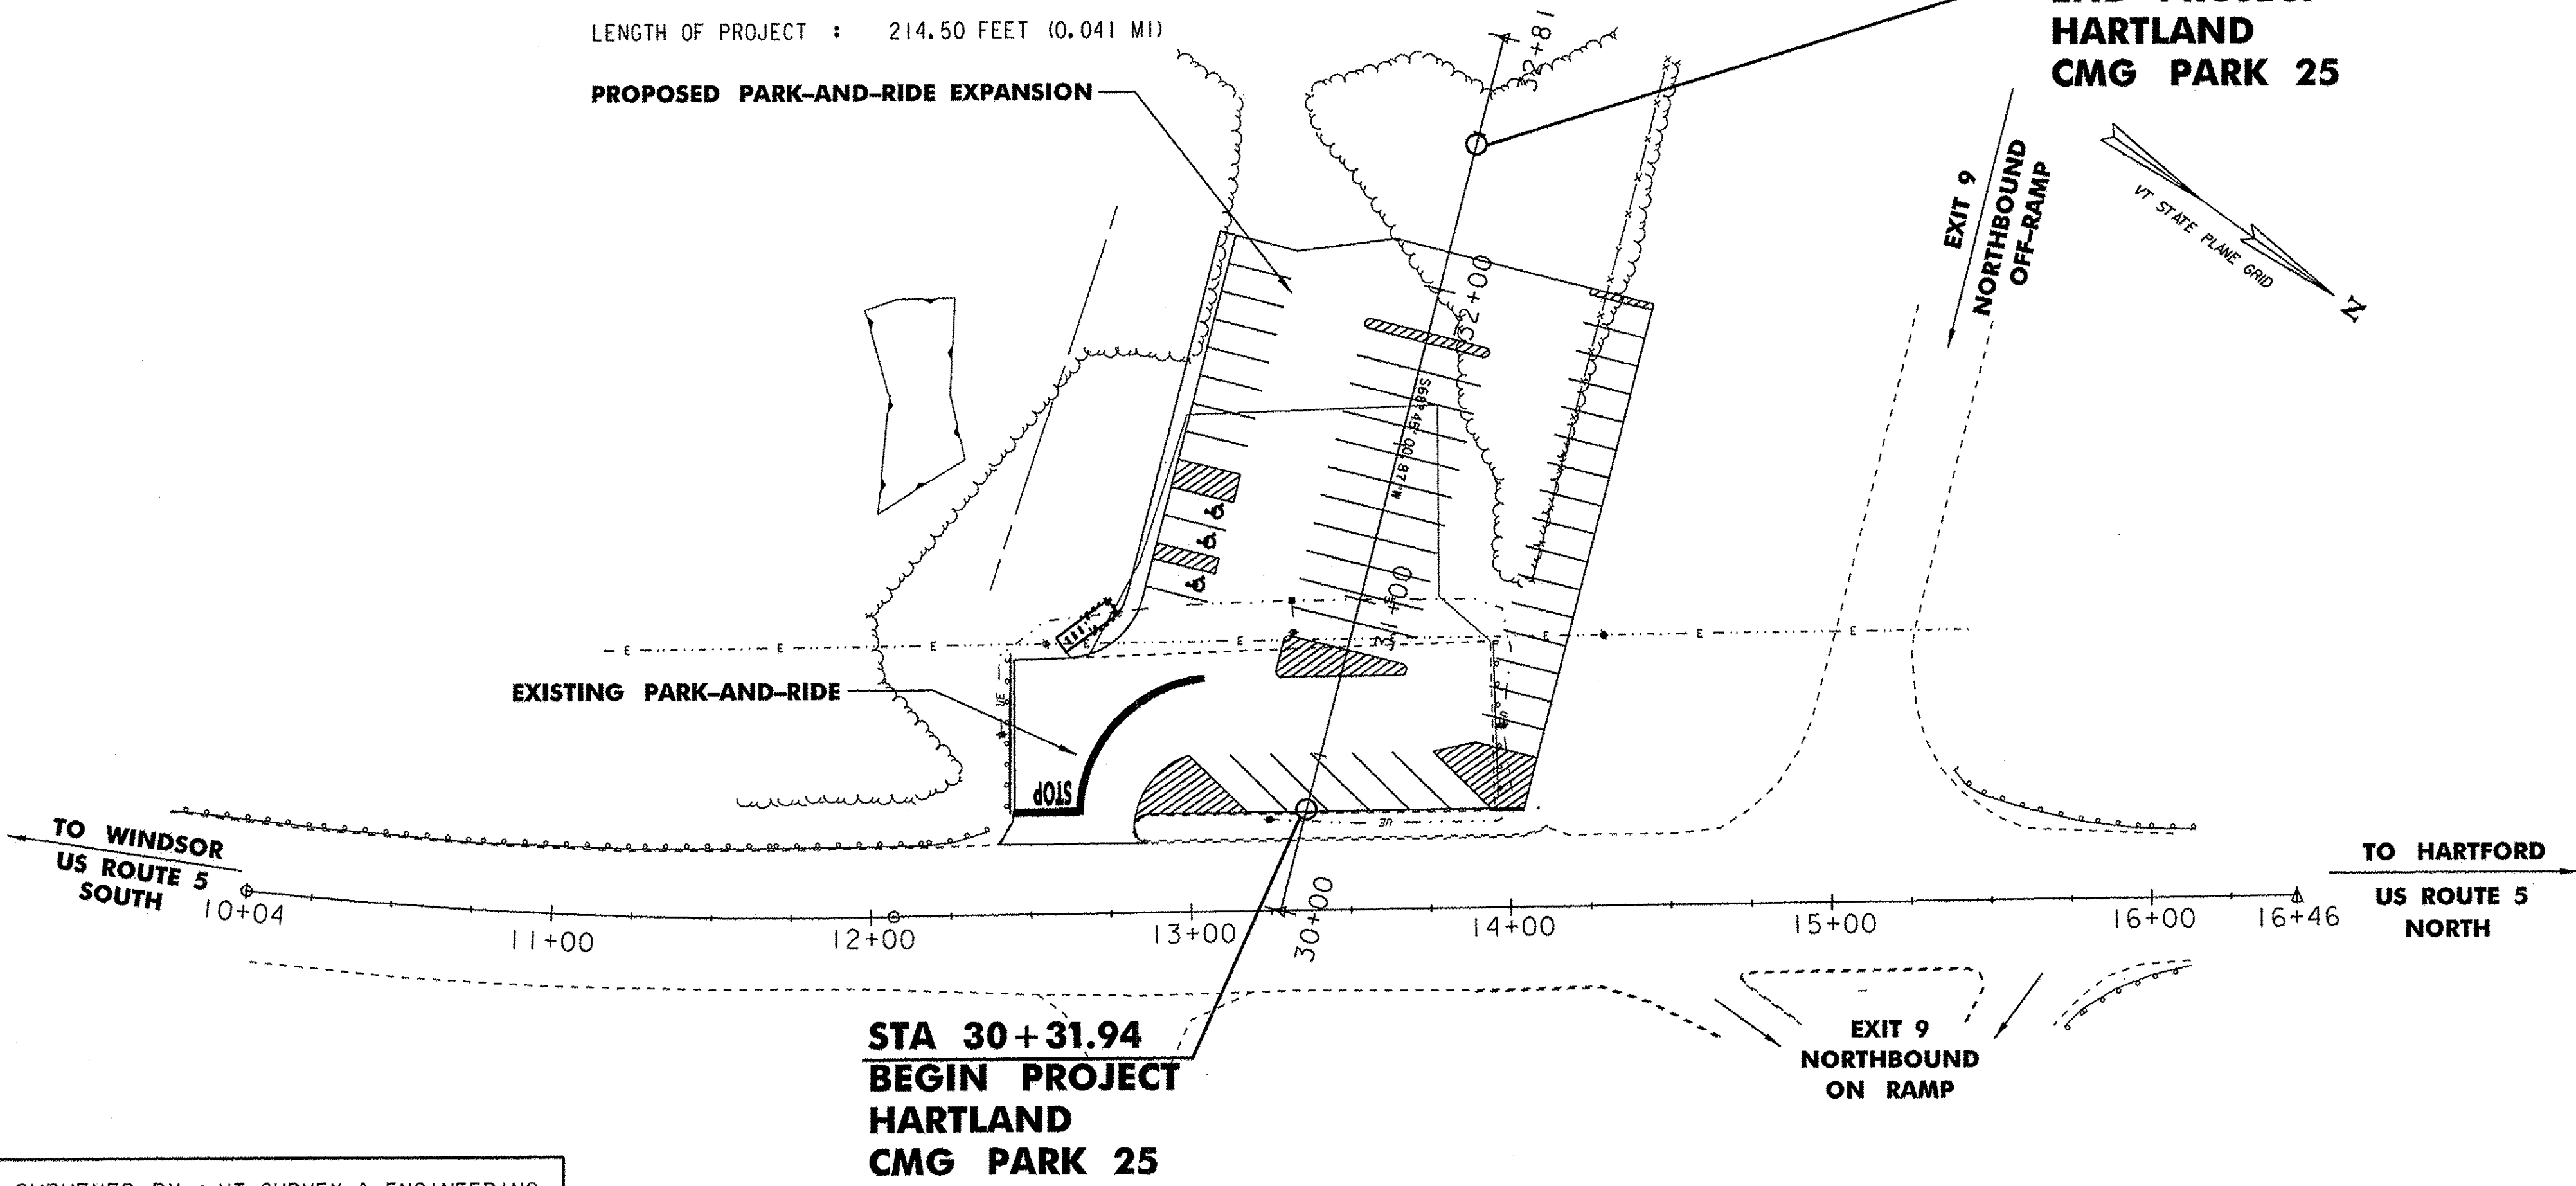

**STA 32+46.44
END PROJECT
HARTLAND
CMG PARK 25**

**STA 30+31.94
BEGIN PROJECT
HARTLAND
CMG PARK 25**


QUALITY ASSURANCE PROGRAM: 3

CONVENTIONAL SYMBOLS

COUNTY LINE	
TOWN LINE	
LIMITS OF ACCESS	
POINT OF ACCESS	
FENCE LINE	
STONE WALL	
TRAVELED WAY	
GUARD RAIL	
RAILROAD	
SURVEY LINE	
CULVERT	
POWER POLE	
TELEPHONE POLE	
TREES	
CONTROL OF ACCESS	
PROPERTY LINE	
R.O.W. TAKING LINE	
SLOPE RIGHTS	
TOP OF CUT	
TOE OF SLOPE	

SURVEYED BY : VT SURVEY & ENGINEERING
SURVEYED DATE : JUNE 2005

DATUM
VERTICAL NAVD88
HORIZONTAL NAD83 (1992)

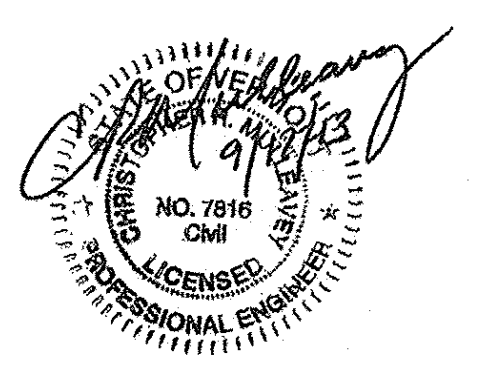

THESE PLANS ARE SUBJECT TO SUCH ENGINEERING CHANGES AS MAY BE REQUIRED BY THE FEDERAL HIGHWAY ADMINISTRATION OR THE DIRECTOR OF PROGRAM DEVELOPMENT.

CONSTRUCTION IS TO BE CARRIED ON IN ACCORDANCE WITH THESE PLANS AND THE STANDARD SPECIFICATIONS FOR CONSTRUCTION DATED 2011, AS APPROVED BY THE FEDERAL HIGHWAY ADMINISTRATION ON JULY 20, 2011 FOR USE ON THIS PROJECT, INCLUDING ALL SUBSEQUENT REVISIONS AND SUCH REVISED SPECIFICATIONS AND SPECIAL PROVISIONS AS ARE INCORPORATED IN THESE PLANS.

DIRECTOR OF PROJECT DEVELOPMENT	APPROVED <i>Kevin A. Maslov</i> DATE 9/19/13
PROJECT MANAGER : WAYNE L. DAVIS	
PROJECT NAME : HARTLAND	PROJECT NUMBER : CMG PARK (25)
SHEET 1 OF 30 SHEETS	

Hoyle, Tanner & Associates, Inc.
150 Dow Street
Manchester, NH 03101-1227
Telephone: 603-669-5555
Fax: 603-669-4168
Web Page: www.hoyletanner.com
HTA PROJECT 904221