

P1
32+80.78
**STA. 32+46.44
END PROJECT
HARTLAND
CMG PARK 25**

STA. 32+11.78
END PAVEMENT

50' WETLAND
BUFFER

CLASS II WETLANDS

*465.10
HIGH POINT

NORTHBOUND OFF-RAMP

POE
STA. 16+45.51

MATCH EXISTING

SEE PARK-AND-RIDE
ENTRANCE DETAIL FOR
GRADING INFORMATION

**STA. 30+31.94
BEGIN PROJECT
HARTLAND
CMG PARK 25**


US ROUTE 5

US ROUTE 5

PC
Sta 10+04.34

P1
STA. 11+05.85

P1
STA. 12+07.08

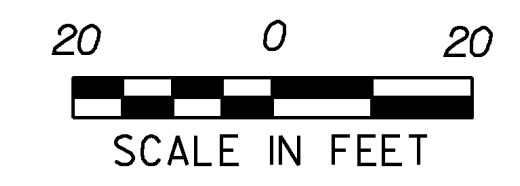

**Hoyle, Tanner
& Associates, Inc.**

HTA PROJECT 904221	MODEL Z20K1540IGRAD
-----------------------	------------------------

PROJECT NAME: HARTLAND
PROJECT NUMBER: CMG PARK(25)

FILE NAME: Z20k154grading.dgn
PROJECT LEADER: WAYNE L. DAVIS
DESIGNED BY: JCC
GRADING PLAN

PLOT DATE: 9/16/2013
DRAWN BY: JCC
CHECKED BY: CRM
SHEET 10 OF 30

9/16/2013 10:58:11 AM
 C:\Users\jcc\OneDrive\Documents\Z20K1540IGRAD.dgn