

DURABLE 24 INCH STOP BAR

STA. 30+20.4, 78.4, LT

DURABLE LETTER OR SYMBOL

STA. 30+92.1, 50.0, LT (HANDICAP)
 STA. 31+05.9, 50.1, LT (HANDICAP)
 STA. 31+15.5, 50.1, LT (HANDICAP)
 STA. 30+18.6, 76.7, LT (STOP)

DURABLE 4 INCH YELLOW LINE (DOUBLE CENTERLINE)

STA. 30+13.8, 67.7, LT TO STA. 30+63.9, 40.9, LT

DURABLE 4 INCH WHITE LINE


PARKING SPOT LINES
 HANDICAP HATCHING
 END PARK AND RIDE LOT HATCHING

DURABLE 4" WHITE LINE (TYP.)

GORE DETAIL

NTS

MOUNT TO GATE

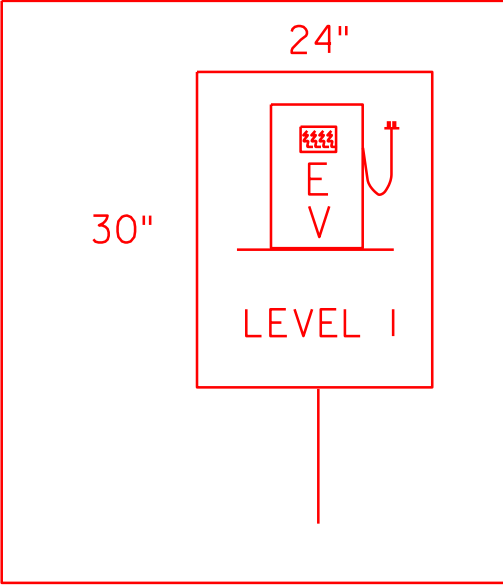

NEW

- 1 @ 30+26 14' RT
- 1 @ 30+90 68' RT
- 1 @ 31+10 68' LT
- 1 @ 31+47 68' LT
- 2 @ 31+28 0' CL
- 1 @ 31+65 68' RT

NOTES:

1. ALL EXISTING SIGNS NOT SHOWN SHALL BE RETAINED AS DIRECTED BY THE RESIDENT ENGINEER.
2. FOR SIGNING DETAILS, SEE DETAIL SHEETS AND VTRANS STANDARD SHEETS E-191, E-193 AND T-45.
3. ALL SIGNS AND POSTS WILL BE NEW UNLESS OTHERWISE NOTED.
4. COVER PARK AND RIDE SIGNS AT STA 13+72.2 AND 12+11.1 PRIOR TO START OF CONSTRUCTION.
5. REMOVE SIGNS (7 AS SHOWN).

PARKING SPACES	
TOTAL SPACE	= 55
ADA SPACES	= 1 VAN
ADA SPACES	= 2

SIGN LEGEND

- N = NEW
- R = REMOVE
- R&S = REMOVE & SALVAGE
- S = SALVAGE SIGN
- RET. = RETAIN
- B-B = BACK TO BACK



PROJECT NAME: HARTLAND
 PROJECT NUMBER: CMG PARK(25)

FILE NAME: Z20k154signply.dgn
 PROJECT LEADER: WAYNE L. DAVIS
 DESIGNED BY: JCC
SIGNING AND MARKING PLAN

PLOT DATE: 9/30/2013
 DRAWN BY: JCC
 CHECKED BY: CRM
 SHEET 13 OF 30

Hoyle, Tanner & Associates, Inc.

HTA PROJECT 904221 MODEL Z20K154SIGNPLY

